GENERAL NOTES:

1. COMPLY WITH THE REQUIREMENTS OF THE UNIFORM BUILDING CODE, 1973 EDITION.
2. UNLESS OTHERWISE NOTED, PLAN DIMENSIONS ARE TO COLUMN GRID OR CENTERLINES, FACE OF STUDS AND FACE OF CONCRETE WALLS.
3. DO NOT SCALE DRAWINGS; USE NOTED DIMENSIONS.
4. FOR PARTITIONS USE (2) 2"x4" WOOD STUDS AT 24" ON CENTER WITH 5/8" GYPSUM WALLBOARD APPLIED TO BOTH SIDES.
5. PROVIDE BLOCKING AND BACKING REQUIRED FOR WALL-HUNG ACCESSORIES AND EQUIPMENT.
6. "FLOOR LINE" REFERS TO TOP OF CONCRETE SLABS.

LEGEND:

WOOD STUD PARTITION

(2) WOOD STUD PARTITION

(1) METAL WALL PANELS F.O.I.C.

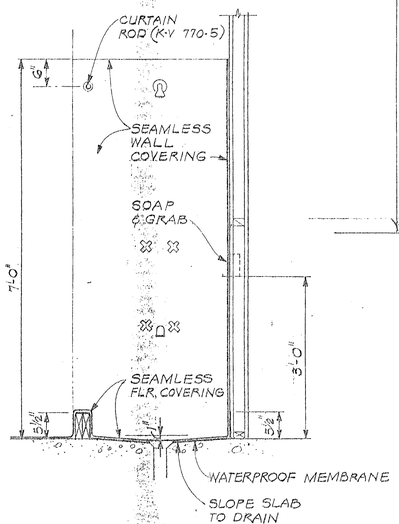

SHOWER SECTION (5) A-1/A-1 (1)

3/4"=1'-0"

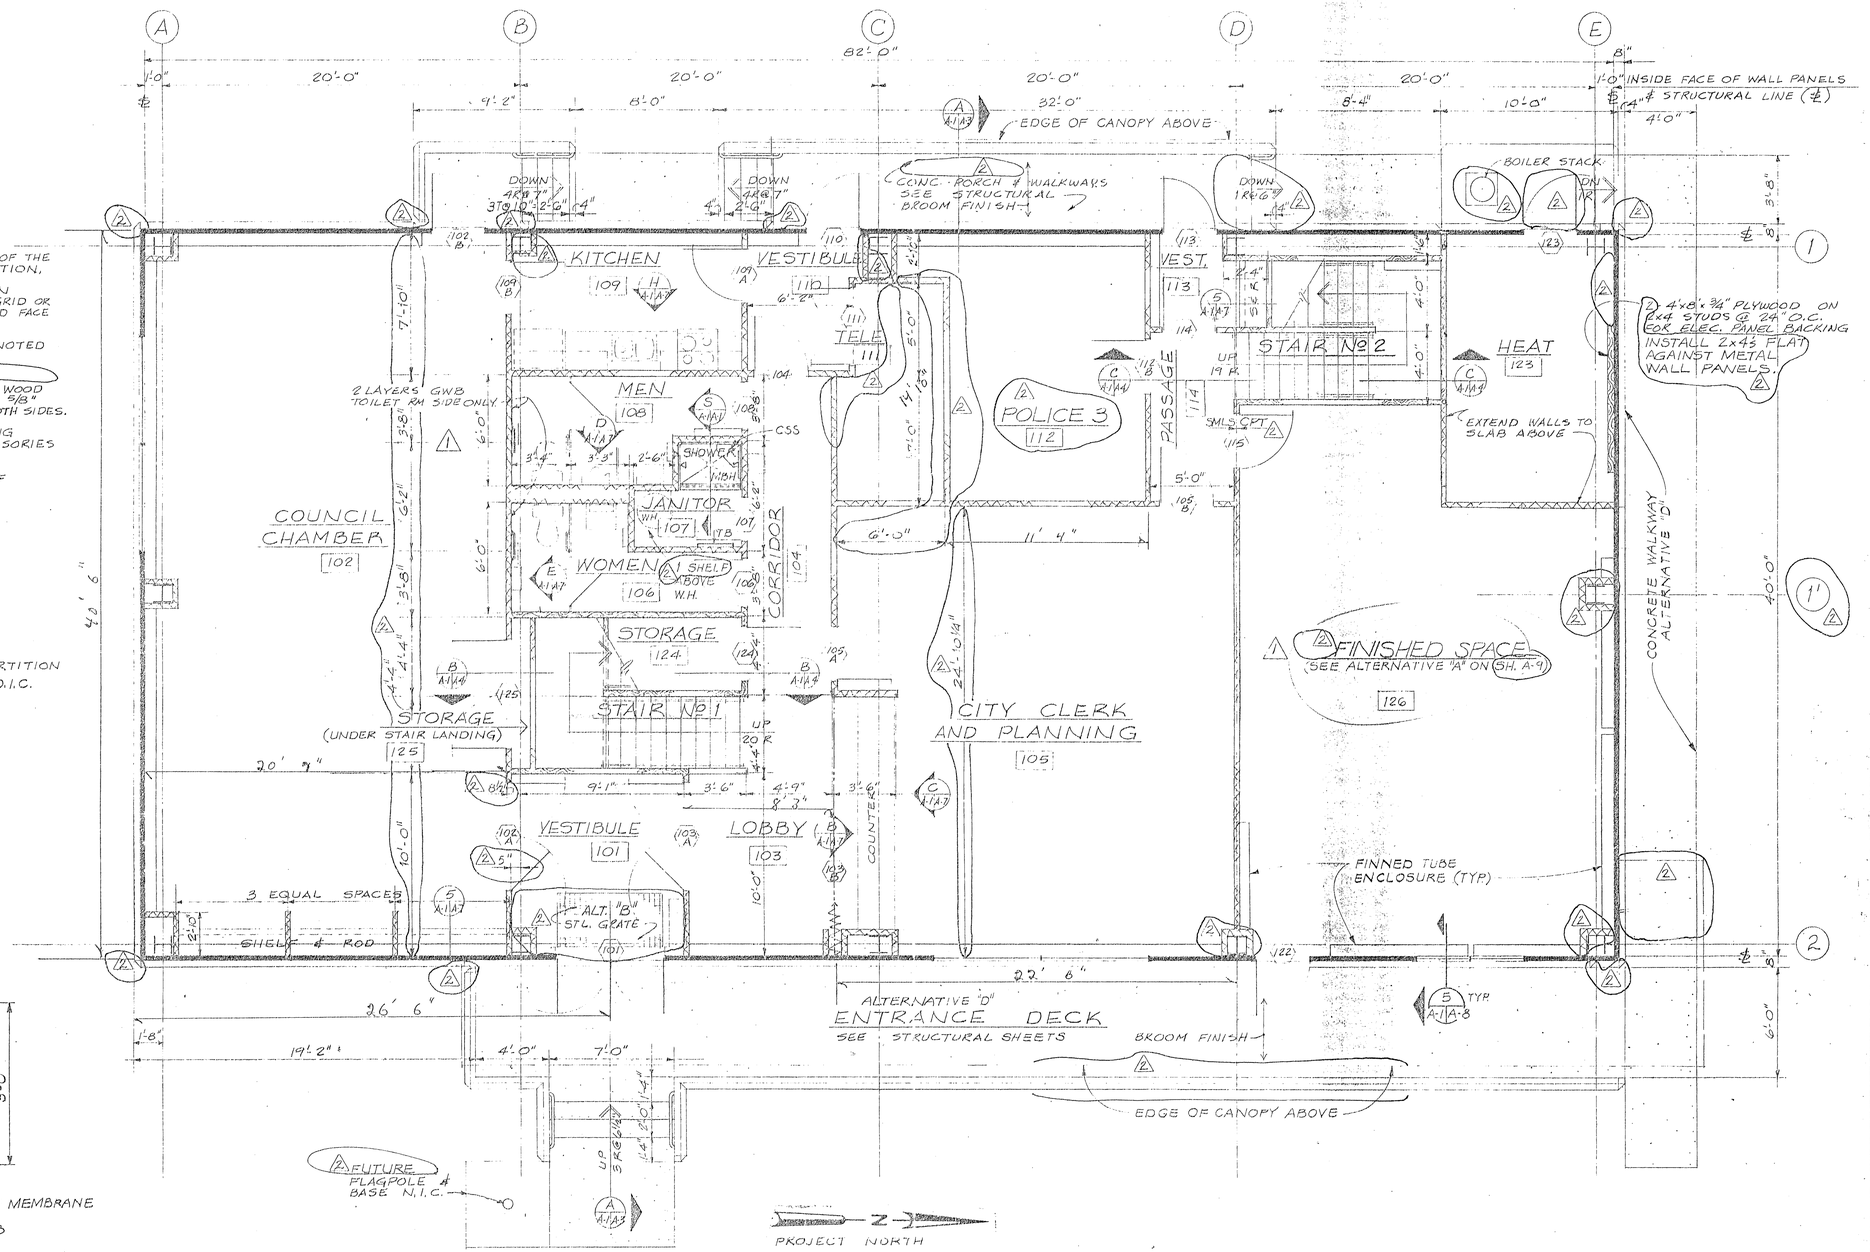

AS BUILT
DATE JAN 27 1977

STATE OF ALASKA
REGISTERED ARCHITECT

CH2M HILL	DES. JJP				
	DR.				
	CHK. JMY				
	APPD. EAH				
		1	12-14-76	AS BUILT	
		2	2-6-76	ADD SHOWER SECTION & MISC. REVISIONS	GEB JJP
		NO.	DATE	REVISION	BY APPD.

FIRST FLOOR PLAN 1/4"=1'-0"

BASIC BID NO. 1 & ALTERNATIVES 'B' & 'D'

CITY HALL FOR HOME, ALASKA

SHEET OF 7 A-1
PROJ. NO. K9327.1
DATE 27 JUNE 75
DWG. NO. C9327-1

GENERAL NOTES:

1. COMPLY WITH THE REQUIREMENTS OF THE UNIFORM BUILDING CODE, 1973 EDITION.
2. UNLESS OTHERWISE NOTED, PLAN DIMENSIONS ARE TO COLUMN GRID OR CENTERLINES, FACE OF STUDS AND FACE OF CONCRETE WALLS.
3. DO NOT SCALE DRAWINGS; USE NOTED DIMENSIONS.
4. FOR PARTITIONS USE (2) 2x4 WOOD STUDS AT 24" ON CENTER WITH 5/8" GYPSUM WALLBOARD APPLIED TO BOTH SIDES.
5. PROVIDE BLOCKING AND BACKING REQUIRED FOR WALL-HUNG ACCESSORIES AND EQUIPMENT.
6. "FLOOR LINE" REFERS TO TOP OF CONCRETE SLABS.

LEGEND:

- WOOD STUD PARTITION
- (2) WOOD STUD PARTITION
- (1) METAL WALL PANELS F.O.I.C.

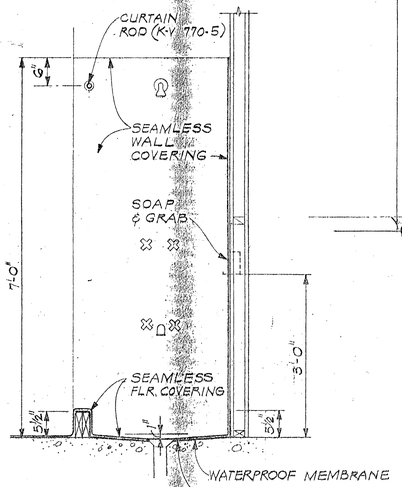

SHOWER SECTION (S, A-1/A-1) 3/4"=1'-0"

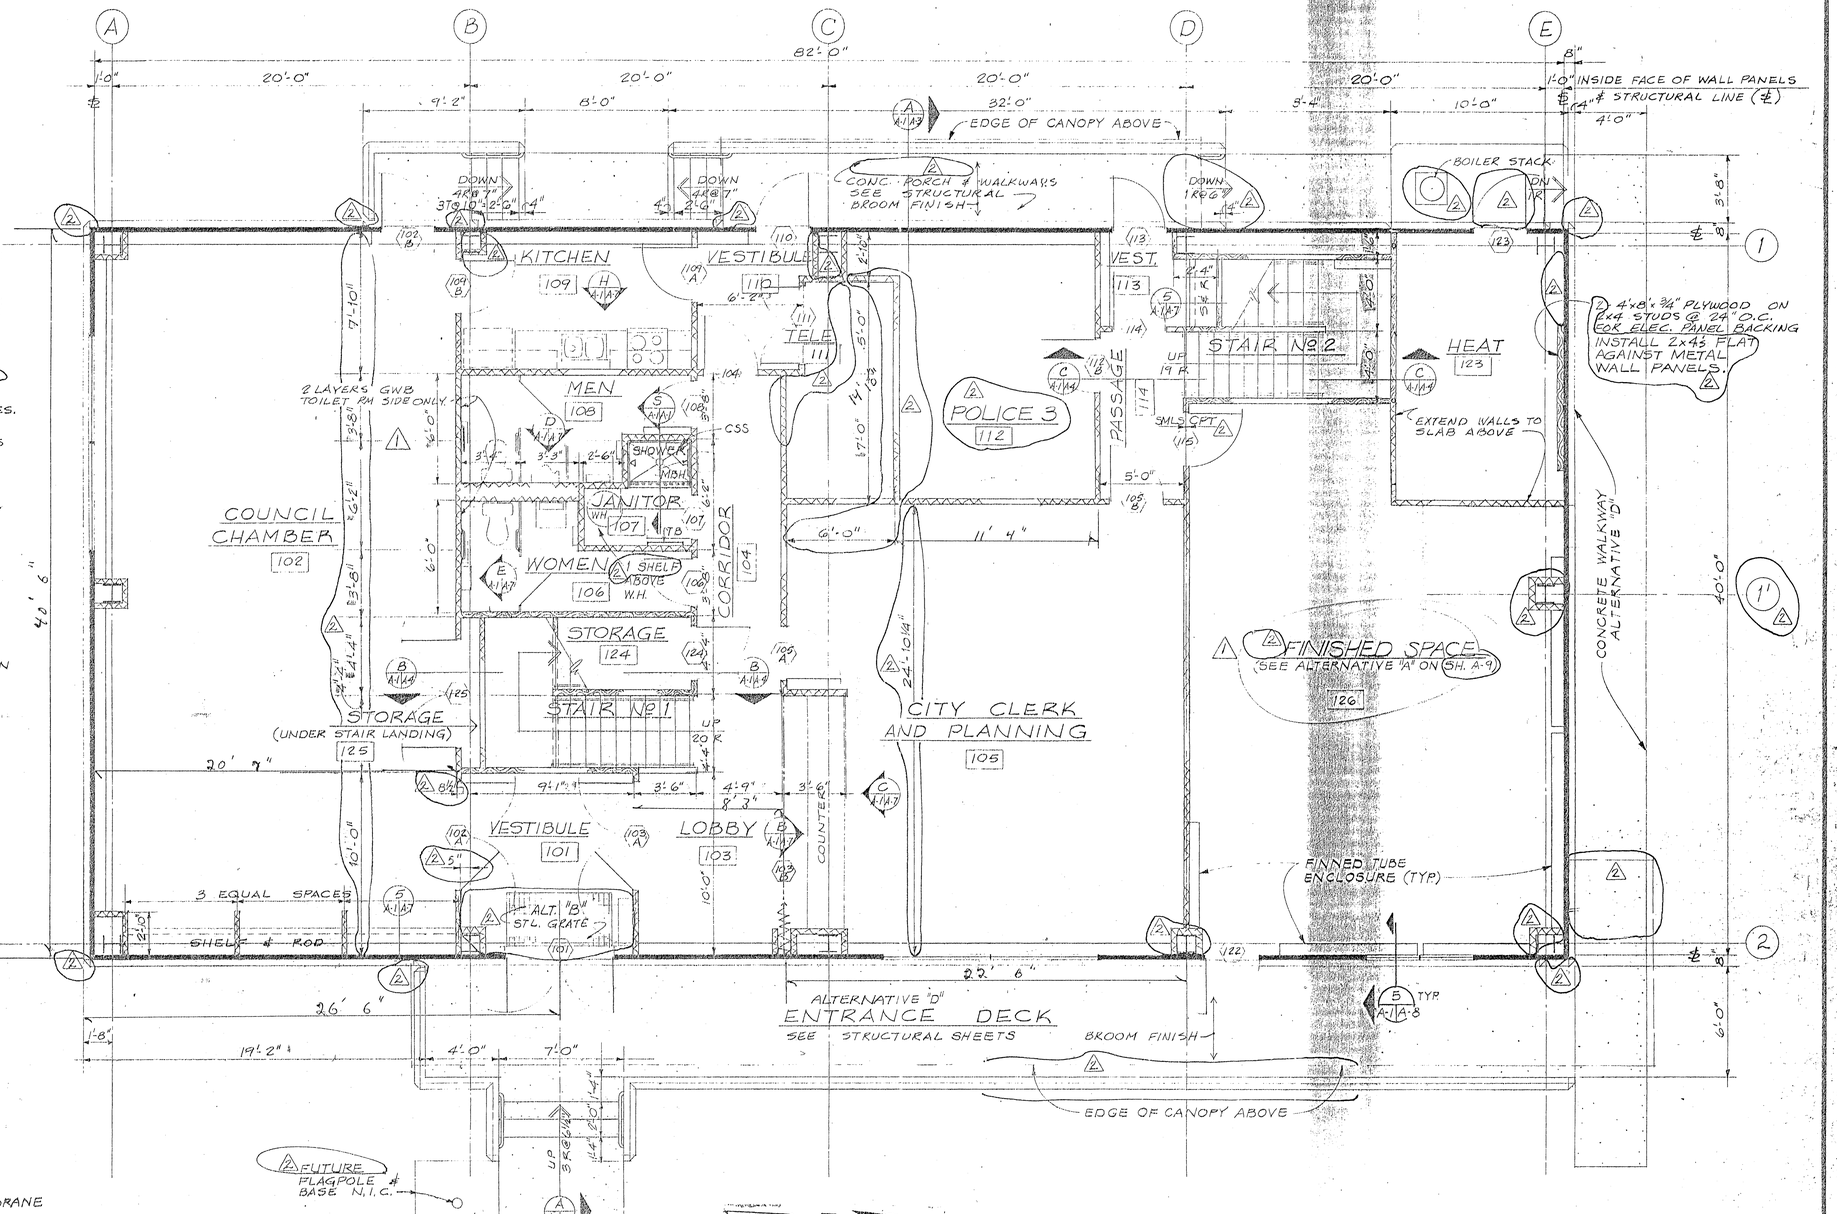

AS BUILT
DATE JAN 27 1977

CH2M HILL	DES.	JJP	
	DR.		
	CHK.	JMY	
	APPD.	EAH	

NO.	DATE	REVISION	BY	APPD.
2	12-14-76	AS BUILT	GEB	JJP
1	2-6-76	ADD SHOWER SECTION & MISC. REVISIONS		

FIRST FLOOR PLAN 1/4"=1'-0"

BASIC BID NO. 1 & ALTERNATIVES 'B' & 'D'

CITY HALL FOR HOME, ALASKA

SHEET OF 7 A-1
PROJ. NO. K9327.1
DATE 27 JUNE 75
DWG. NO. C9327-A1

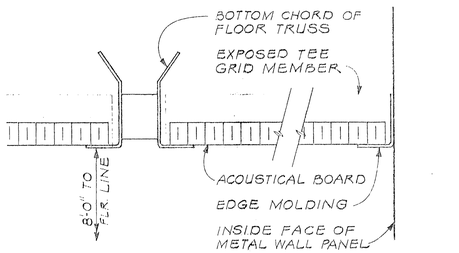

GRID DETAIL 1 A-1a A-1a HALF SIZE EDGE 2 A-1a A-1a HALF SIZE

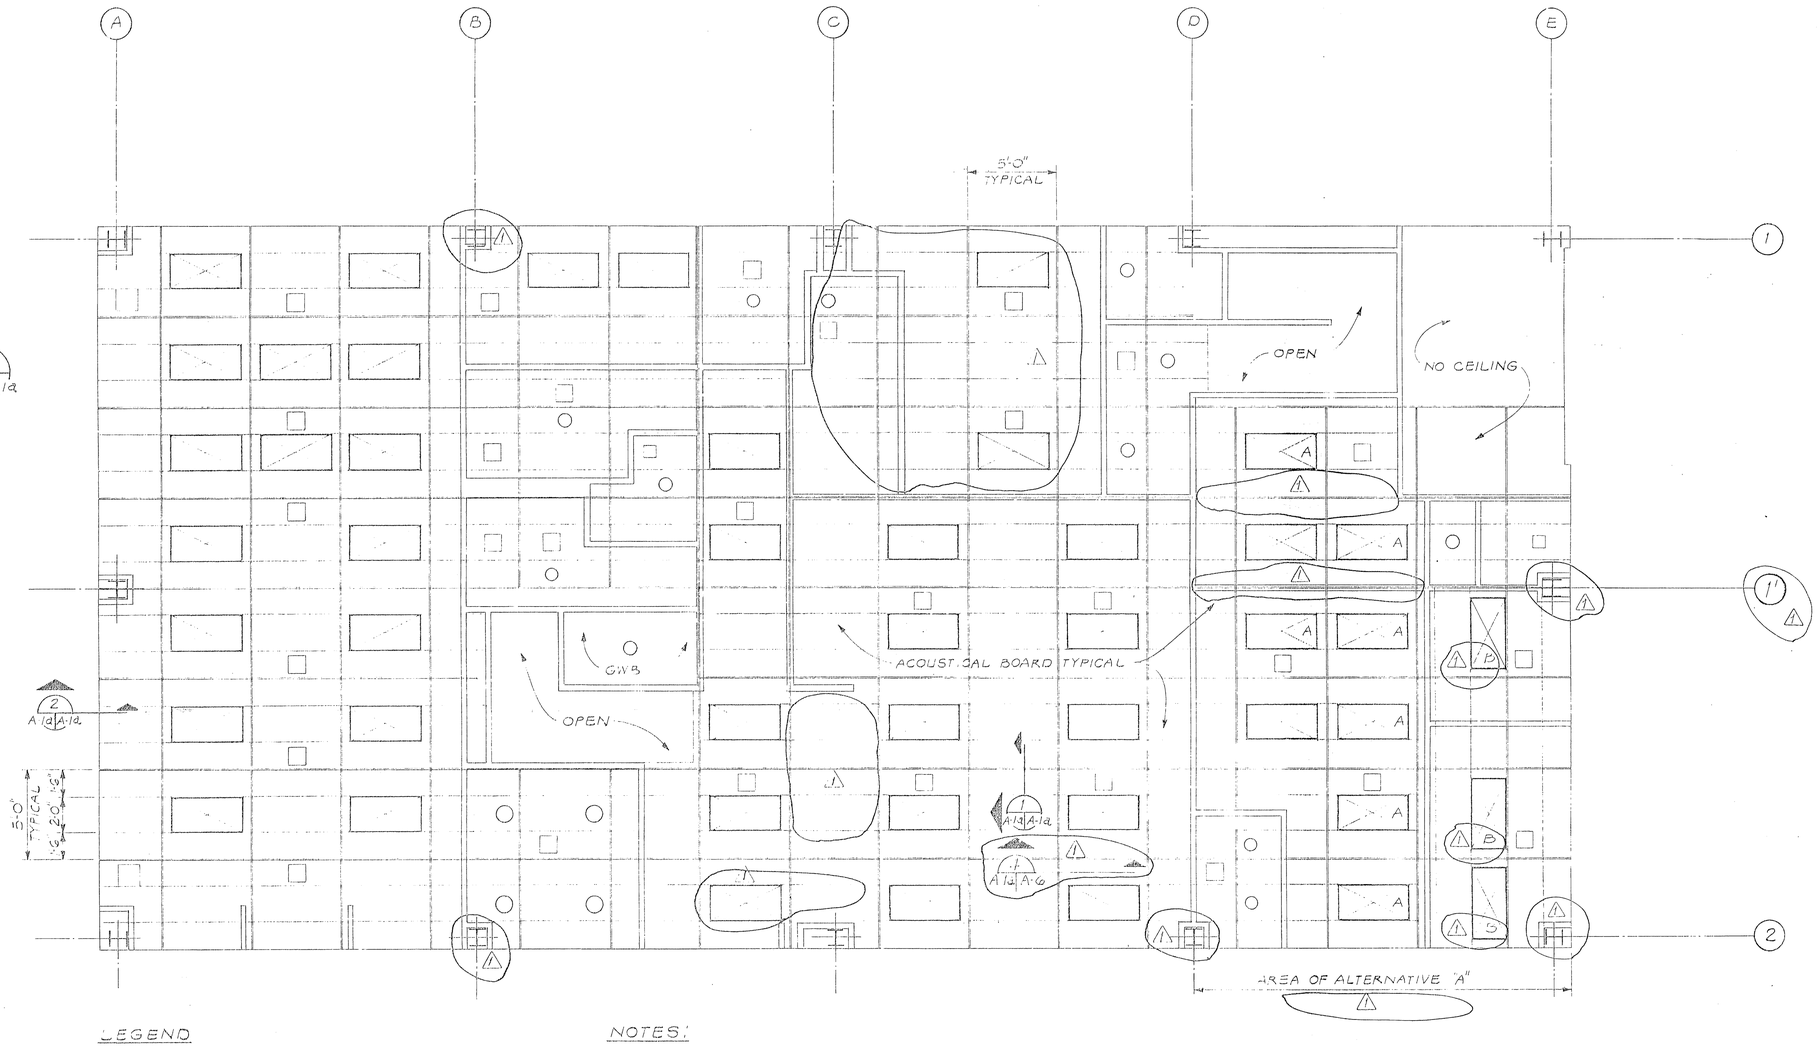

LEGEND

- 2x4' LAY-IN FLUORESCENT LIGHT INDICATES LIGHT ADDED BY ALTERNATIVE "A"
- RECESSED LIGHT
- DIFFUSER OR GRILLE
- BOTTOM CHORD OF FLOOR TRUSS ABOVE
- EXPOSED TEE GRID

NOTES:

1. FASTEN TOP PLATE OF STUD WALLS TO CEILING GRID AT 4'-0" O.C. MAX
2. SEE FLOOR PLANS FOR SPACE DIMENSIONS.
3. ALTERNATIVE "A" LIGHTING LAYOUT IS SHOWN ABOVE.

AS BUILT
DATE JAN 27 1977

STATE OF ALASKA

CH2M HILL ALASKA

DES.	JJP			
DR.	BLB			
CHK.	JMY	1	12.14.76	AS BUILT
APPD.	EAH	NO.	DATE	REVISION

BY APPD.

FIRST FLOOR REFLECTED CEILING PLAN

BASIC BID NO. 1 & ALTERNATIVE A"

CITY HALL FOR NOME, ALASKA

SHEET OF	A-1a
PROJ. NO.	K9327.1
DATE	6 FEB '76
DWG. NO.	C9327-1

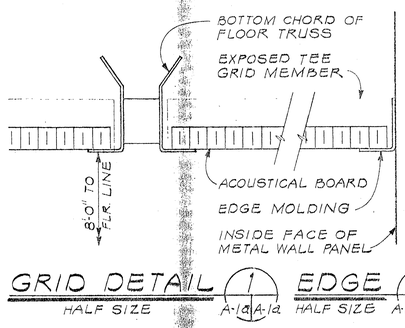

GRID DETAIL 1 A-1a A-1a HALF SIZE EDGE 2 A-1a A-1a HALF SIZE

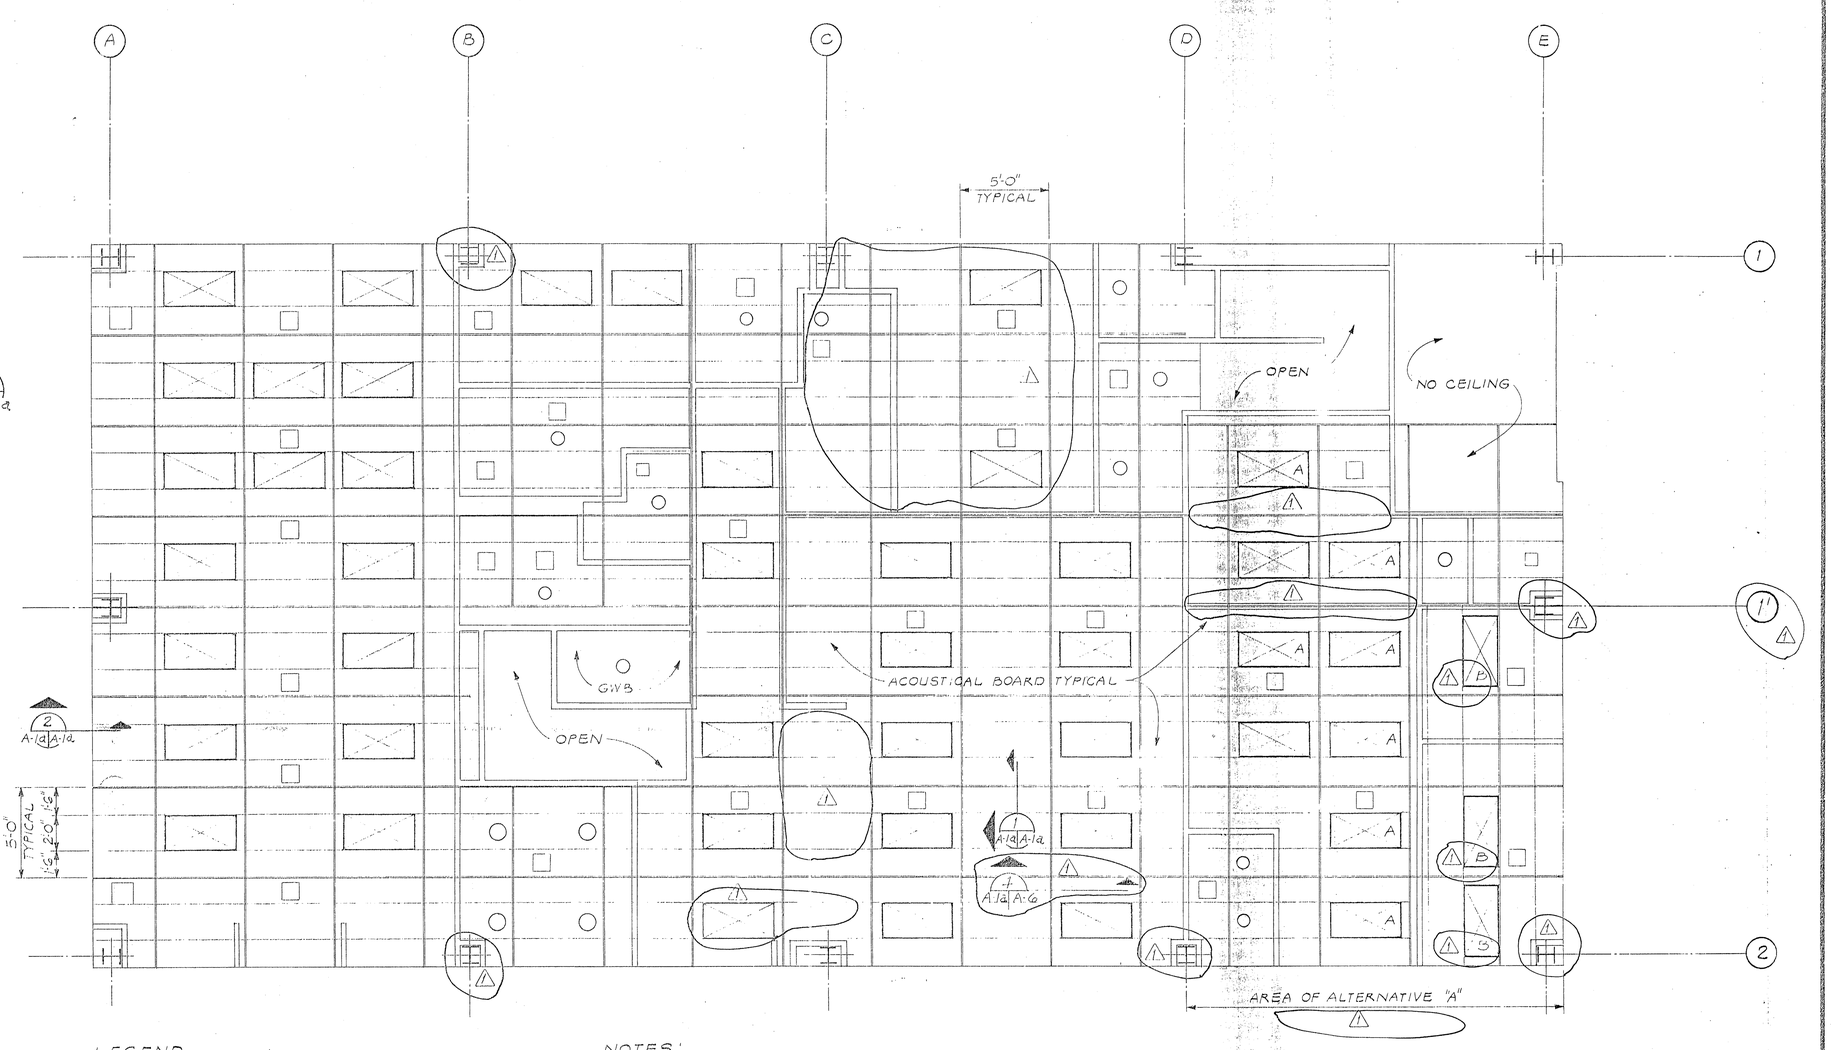

LEGEND

- 2'x4' LAY-IN FLUORESCENT LIGHT INDICATES LIGHT ADDED BY ALTERNATIVE "A"
- RECESSED LIGHT
- DIFFUSER OR GRILLE
- BOTTOM CHORD OF FLOOR TRUSS ABOVE
- EXPOSED TEE GRID

NOTES:

1. FASTEN TOP PLATE OF STUD WALLS TO CEILING GRID AT 4'-0" O.C. MAX
2. SEE FLOOR PLANS FOR SPACE DIMENSIONS.
3. ALTERNATIVE "A" LIGHTING LAYOUT IS SHOWN ABOVE.

STATE OF ALASKA — REGISTERED PROFESSIONAL ENGINEER

AS BUILT
DATE JAN 27 1977

CH2M HILL — ALASKA

DES.	JJP
DR.	BLB
CHK.	JMY
APPD.	EAH

NO.	DATE	REVISION	BY	APPD.
1	12.14.76	AS BUILT		

FIRST FLOOR REFLECTED CEILING PLAN

BASIC BID NO. 1 & ALTERNATIVE "A"

CITY HALL FOR NOME, ALASKA

SHEET OF	A-1a
PROJ. NO.	K9327.1
DATE	6 FEB '76
DWG. NO.	C9327-1

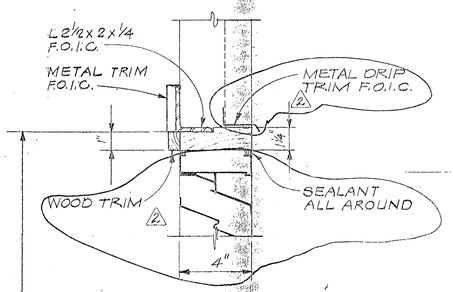

HEAD

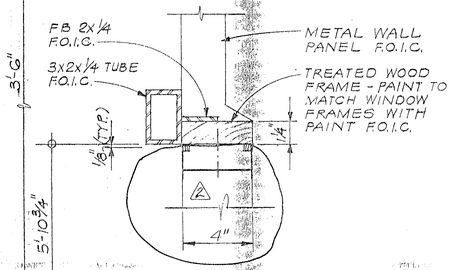

JAMB

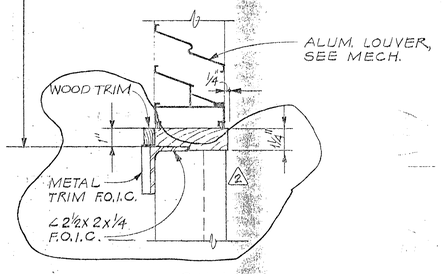

SILL

NOTE:
STEEL TUBE AND ANGLE FRAMES ARE ALSO TYPICAL FOR WINDOWS F.O.I.C.

LOUVER DETAILS

3" = 1'-0"

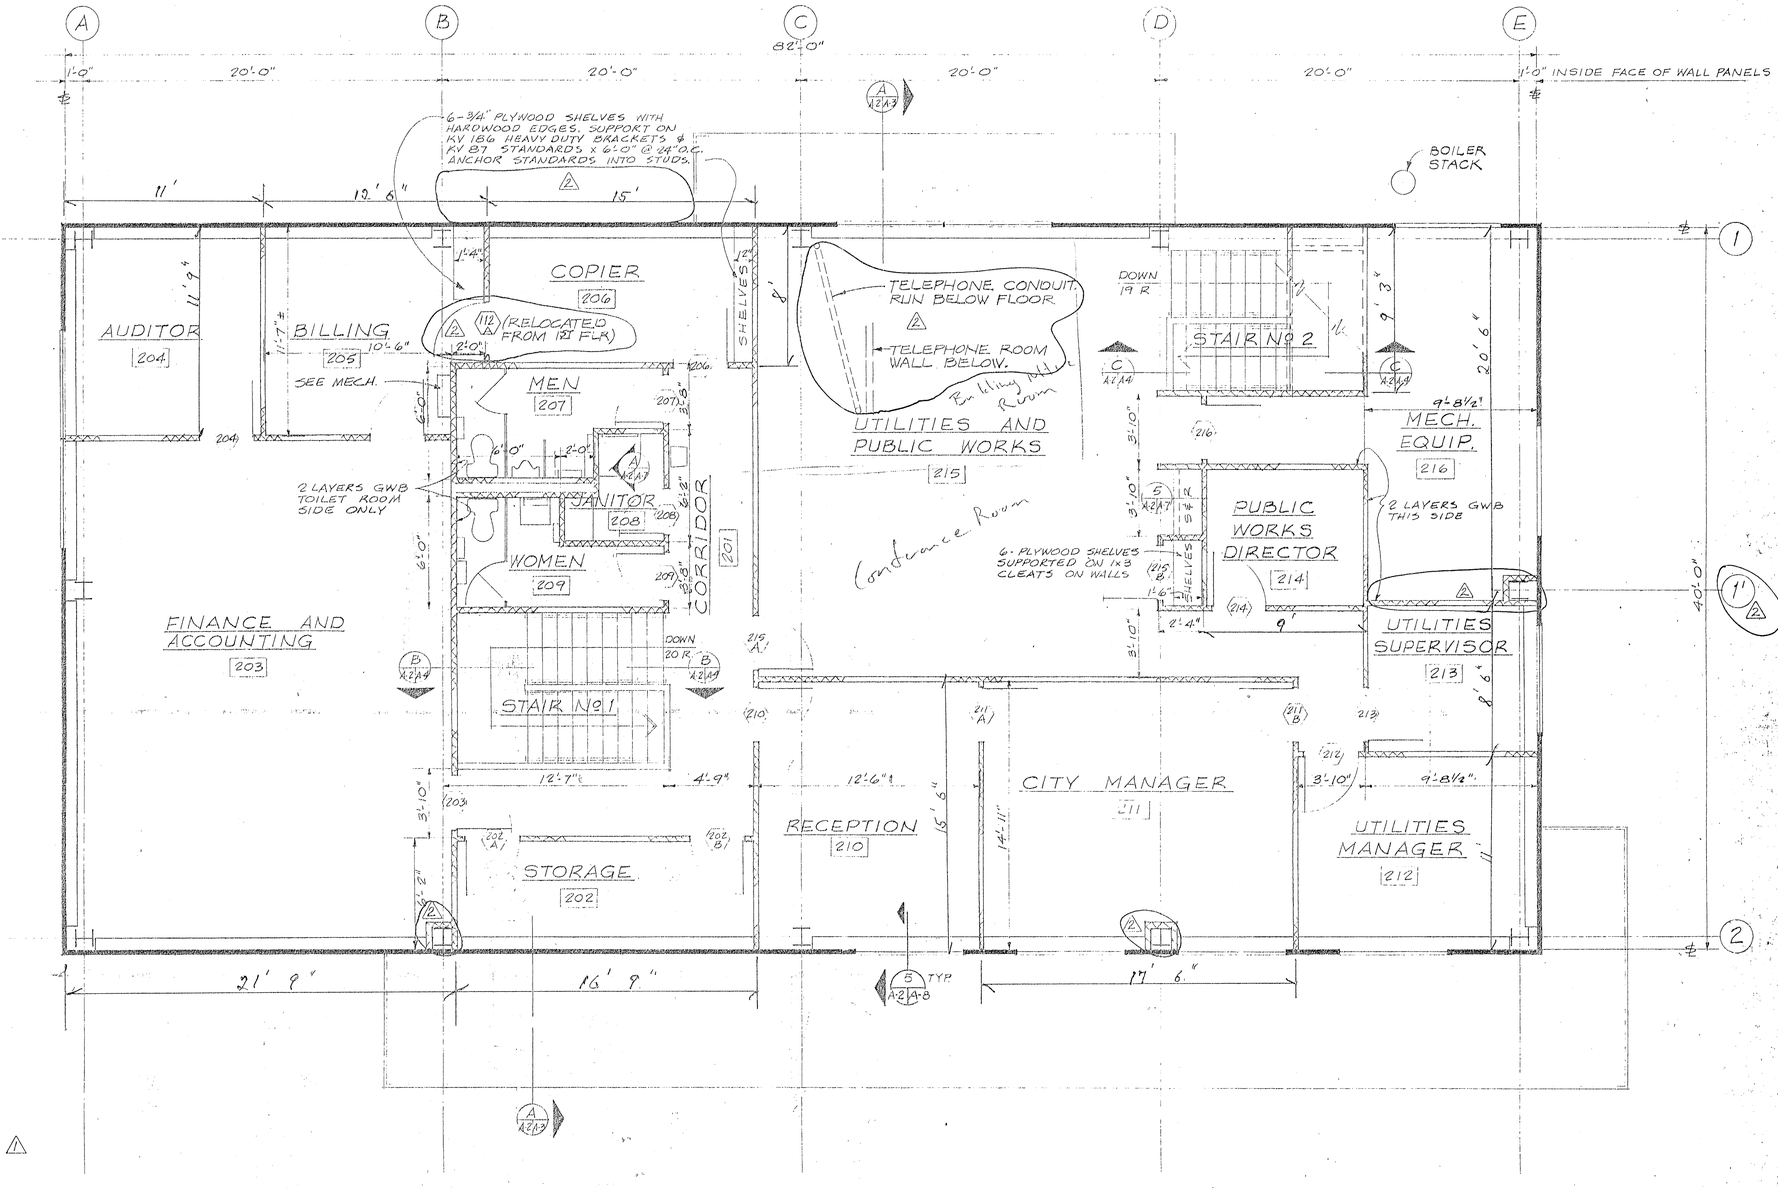

PROJECT NORTH

AS BUILT
DATE JAN 27 1977

STATE OF ALASKA
JOHN M. LEMAN
REGISTERED ARCHITECT
NO. 1571

CH2M HILL	DES. JJP					
	DR. JJP					
	CHK. JMY	1	12-14-76	AS BUILT	DH	
	APPD. EAH	2	2-6-76	ADDED LOUVER DETAIL	GEB	JJP
		NO.	DATE	REVISION	BY	APPD.

SECOND FLOOR PLAN ¼"=1'-0"

BASIC BID NO. 1

CITY HALL FOR NOME, ALASKA

SHEET OF 7 A-2
PROJ. NO. K9327.1
DATE 27 JUNE 75
DWG. NO. C9327-1

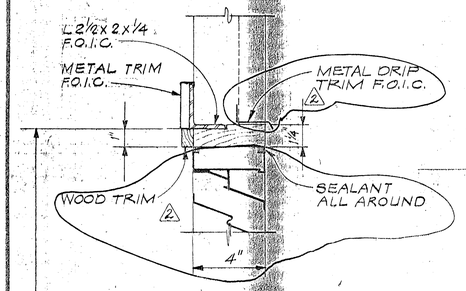

HEAD

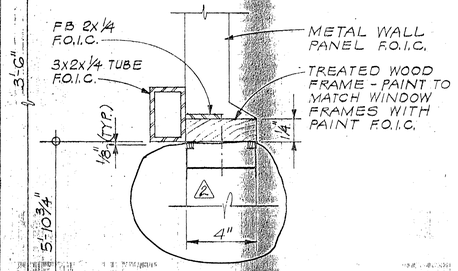

JAMB

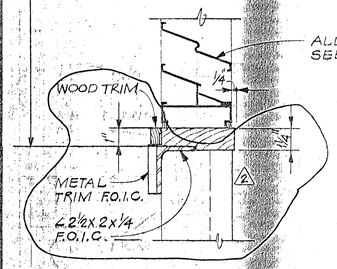

SILL

NOTE:
STEEL TUBE AND ANGLE FRAMES ARE ALSO TYPICAL FOR WINDOWS F.O.I.C.

LOUVER DETAILS

3" = 1'-0"

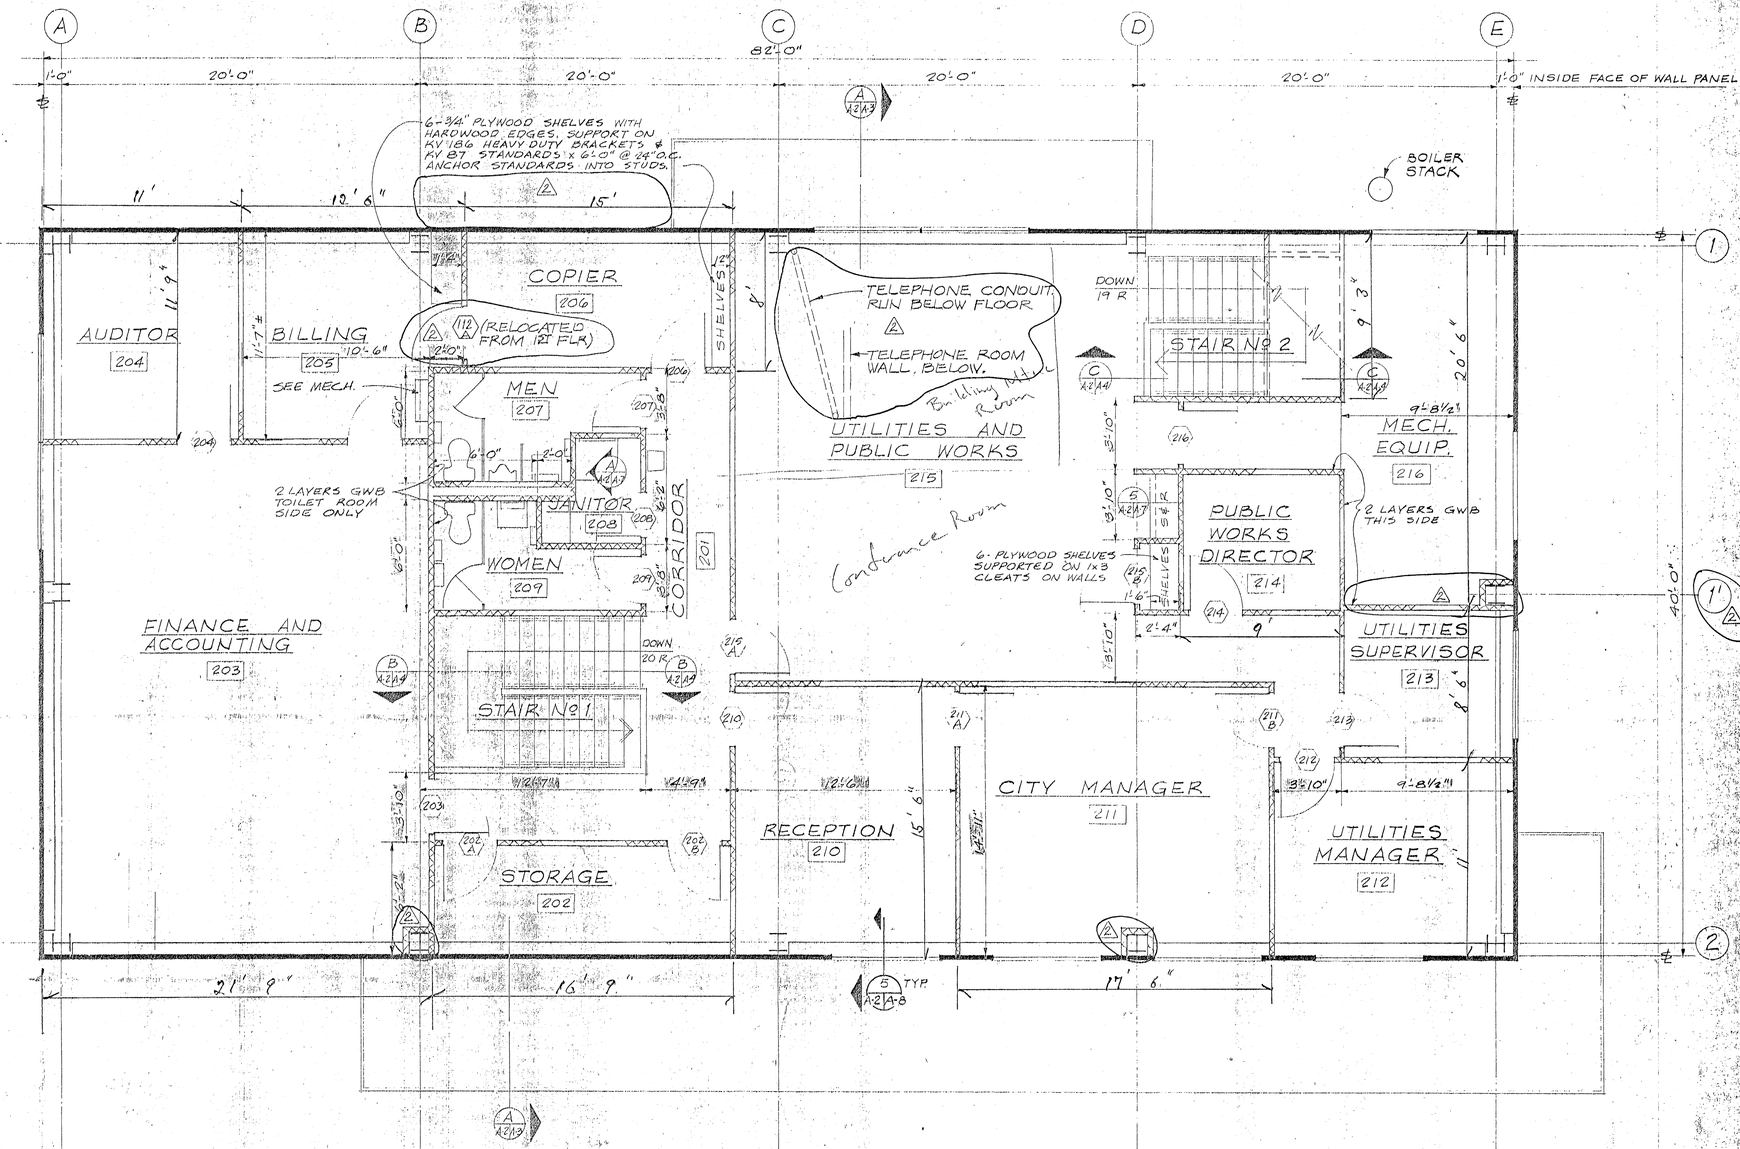

PROJECT NORTH

AS-BUILT
DATE JAN 27 1977

NO.	DATE	REVISION	BY	APPD.
1	12-14-76	AS BUILT.	DT	
2	2-6-76	ADDED LOUVER DETAIL	GEB	JJP

CH2M HILL
DES. JJP
DR. JJP
CHK. JMY
APPD. EAH

SECOND FLOOR PLAN 1/4"=1'-0"

BASIC BID NO. 1

CITY HALL FOR NOME, ALASKA

SHEET OF 7 A-2
PROJ. NO. K9327.1
DATE 2 JUNE 75
DWG. NO. C9327-A

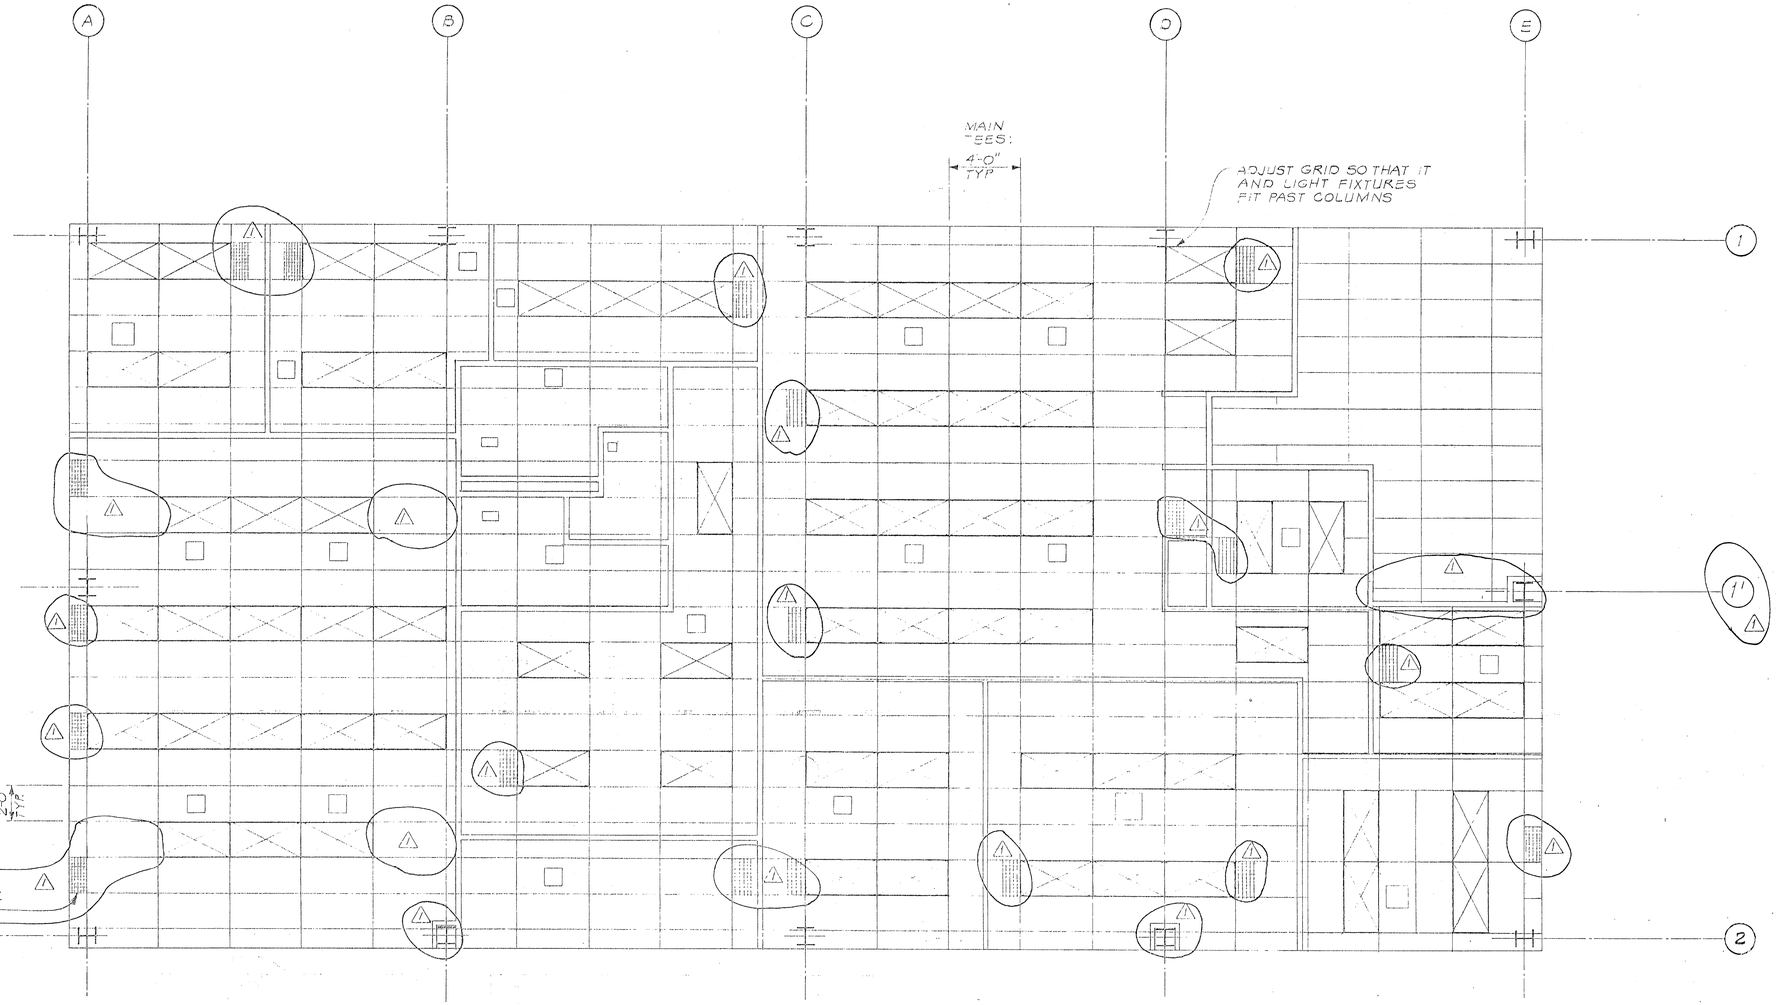

NOTE:
SEE SH. A-1a FOR LEGEND & ADDITIONAL TYP CALLOUTS.

AS BUILT
DATE JAN 27 1977

STATE OF ALASKA
49TH
Edward A. Hall
Registered Professional Engineer

CH2M HILL ALASKA

DES.	JJP
DR.	GEB
CHK.	JMY
APPD.	EAH

NO.	DATE	REVISION	BY	APPD.
1	12-16-76	AS BUILT		

SECOND FLOOR REFLECTED CEILING PLAN

BASIC BID NO. 1

CITY HALL FOR NOME, ALASKA

SHEET OF	A-2a
PROJ. NO.	K9327.1
DATE	6 FEB '76
DWG. NO.	C9327-1

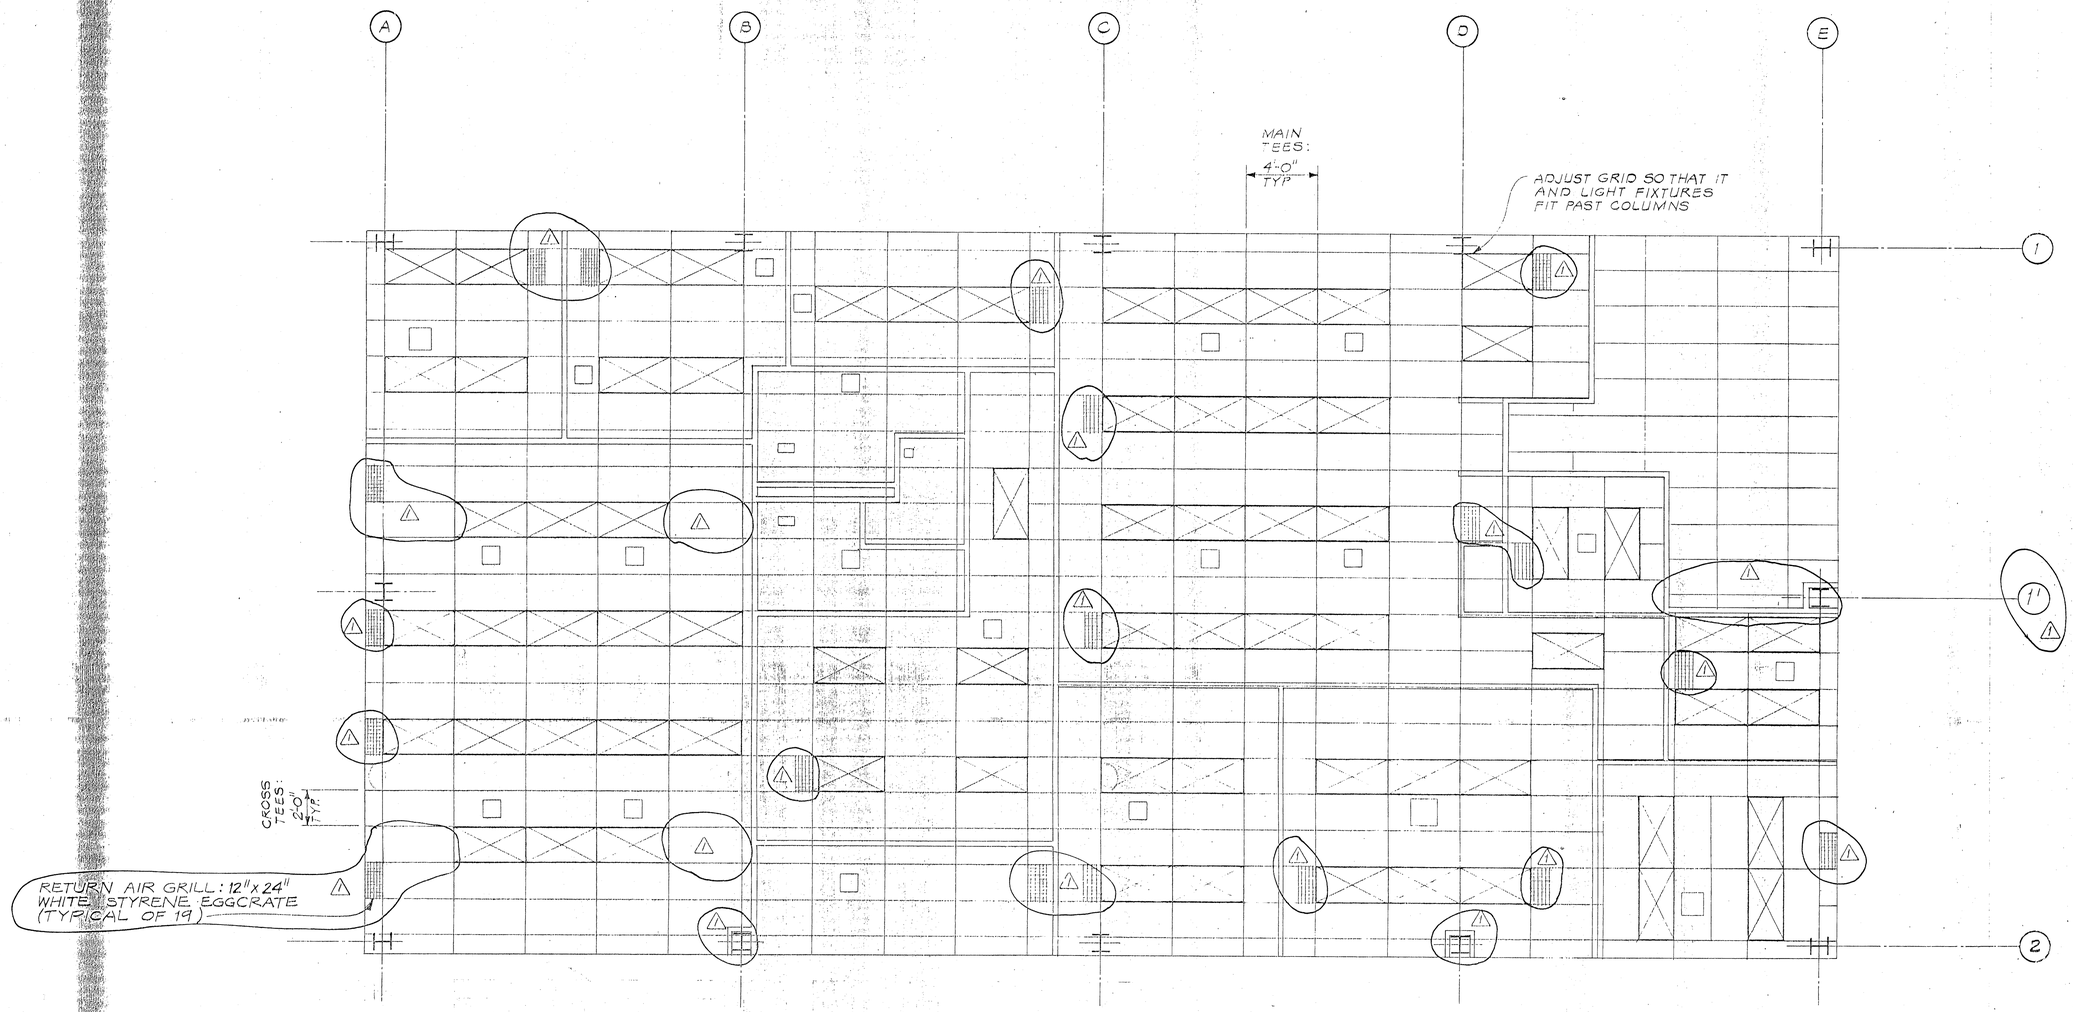

NOTE:
SEE SH. A-1a FOR LEGEND & ADDITIONAL TYP. CALLOUTS.

AS BUILT
DATE JAN 27 1977

STATE OF ALASKA 49TH
Registered Professional Engineer

CH2M HILL

DES.	JJP
DR.	GEB
CHK.	JMY
APPD.	EAH

NO.	DATE	REVISION	BY	APPD.
1	12.16.76	AS BUILT		

SECOND FLOOR REFLECTED CEILING PLAN

BASIC BID NO. 1

CITY HALL FOR NOME, ALASKA

SHEET OF	A-2a
PROJ. NO.	K9327.1
DATE	6 FEB '76
DWG. NO.	C9327-1

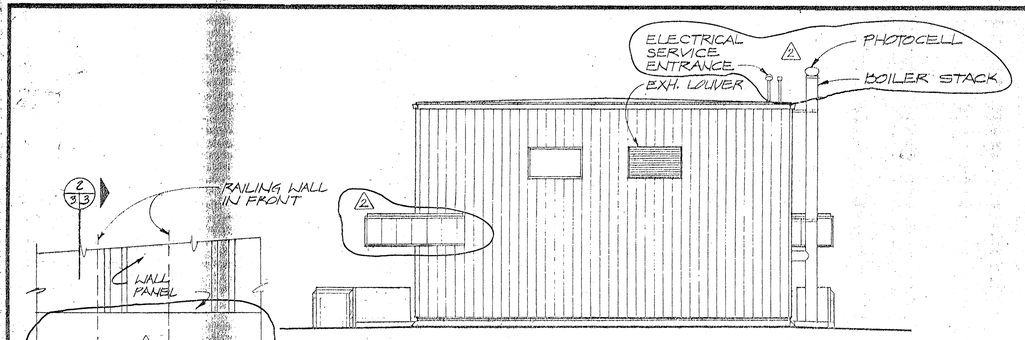

NORTH ELEVATION
1/8" = 1'-0"

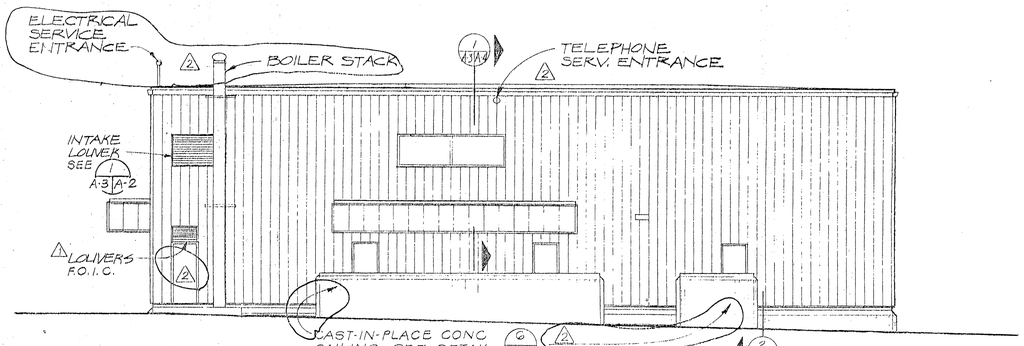

WEST ELEVATION
1/8" = 1'-0"

△NOTE: ELEVATIONS SHOW ALTERNATIVE "D" FOR BASIC BID NO. 1 SEE SHEET A-8.

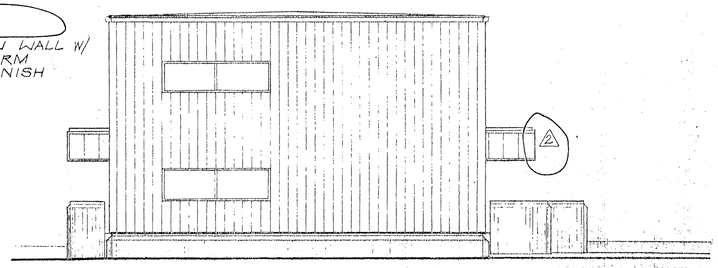

SOUTH ELEVATION
1/8" = 1'-0"

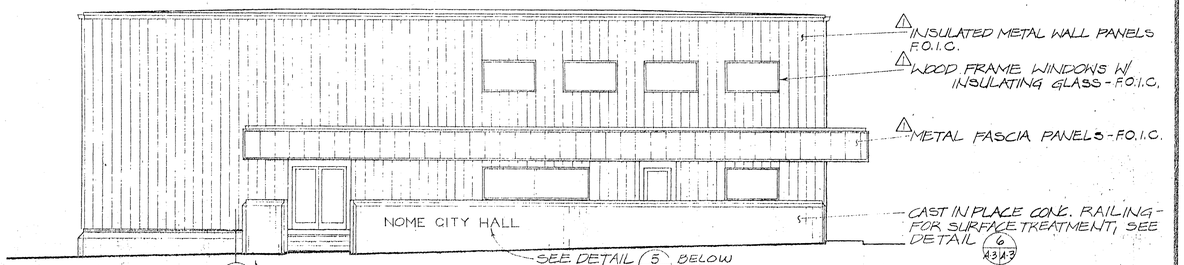

EAST ELEVATION
1/8" = 1'-0"

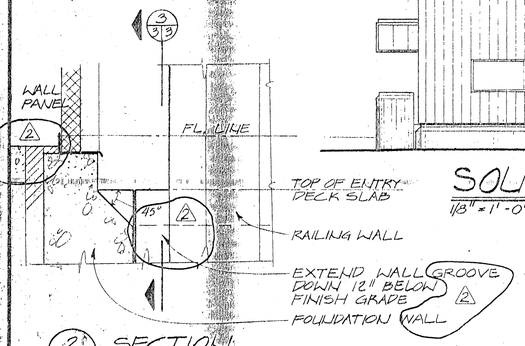

3 A-3 A-3 DETAIL 1½" = 1'-0"

2 A-3 A-3 SECTION 1½" = 1'-0"

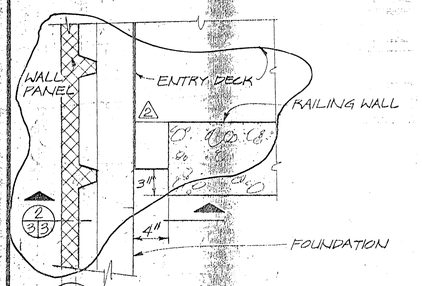

1 A-3 A-3 PLAN 1½" = 1'-0"

ENTRY DECK/FOUNDATION WALL DETAILS - TYPICAL

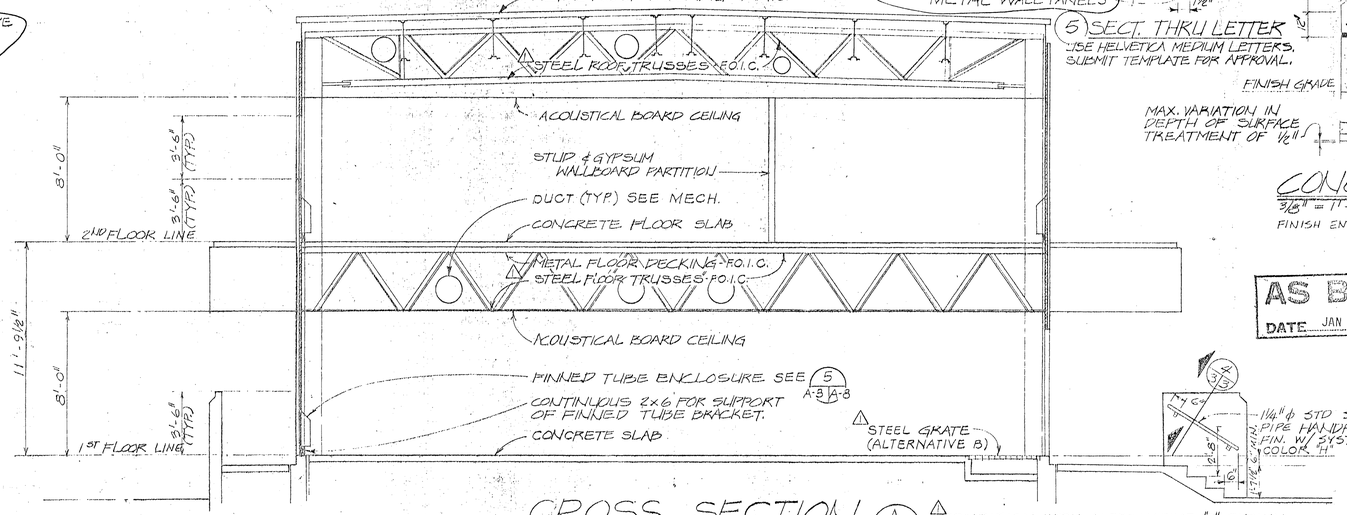

CROSS SECTION
1/4" = 1'-0"

A A-1 A-3

△CONDITION WITH ALTERNATIVE "D" SHOWN

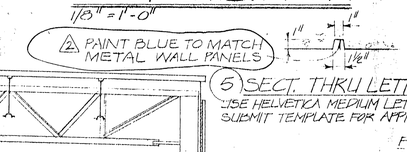

CONCRETE FINISH DETAILS
3/16" = 1'-0" ALTERNATIVE "D" △

6 A-3 A-3

FINISH ENTRY DECKS, STAIRS & RAILING WALLS W/ PAINT SYSTEM 7

AS BUILT
DATE JAN 27 1977

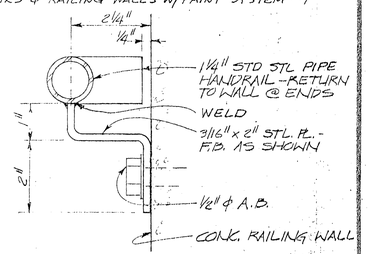

HANDRAIL DETAIL
6" = 1'-0"

4 A-3 A-3

CH2M HILL	DES. JJP			
	DR. DH			
	CHK. JMY	△ 12.17.76	AS BUILT	GEB JJP
	APPD. EAH	△ 2-6-76	MISCELLANEOUS REVISIONS;	
		NO. DATE	REVISION	BY APPD.

ELEVATIONS AND SECTION

BASIC BID NO. 1 & ALTERNATIVES "B" & "D"

CITY HALL FOR NOME, ALASKA

SHEET OF 7 A-3
PROJ. NO. K9327.1
DATE 27 JUNE 75
DWG. NO. C9327-1

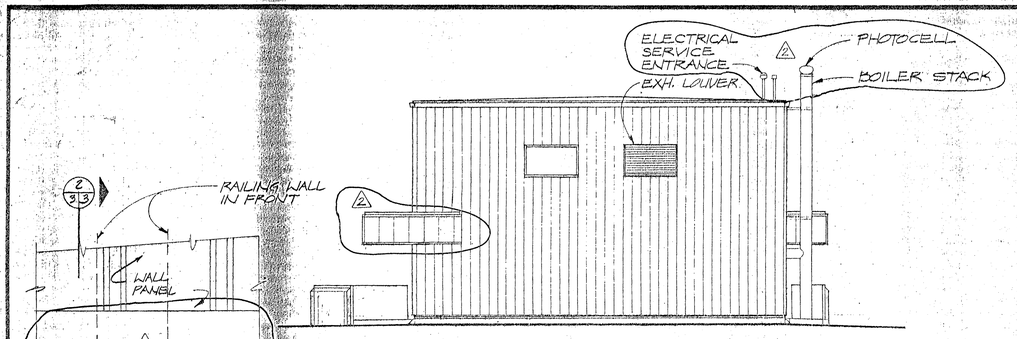

NORTH ELEVATION
1/8" = 1'-0"

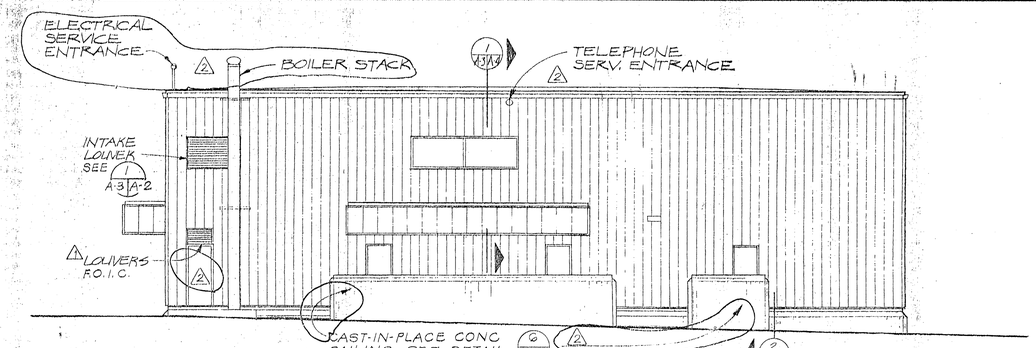

WEST ELEVATION
1/8" = 1'-0"

△NOTE: ELEVATIONS SHOW ALTERNATIVE "D" FOR BASIC BID NO.1 SEE SHEET A-8.

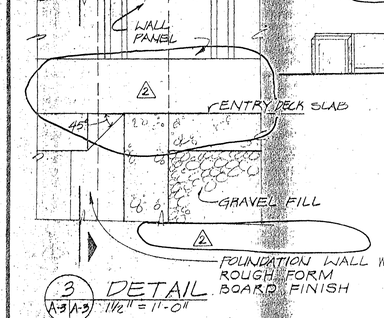

3 A-3 A-3 DETAIL 1½" = 1'-0"

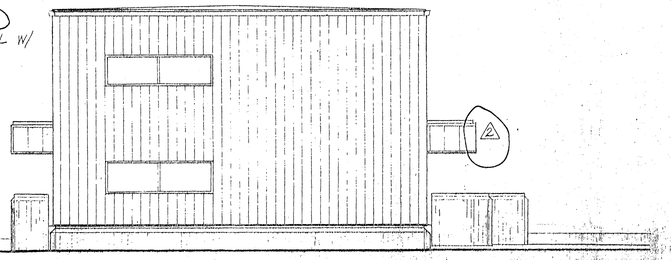

SOUTH ELEVATION
1/8" = 1'-0"

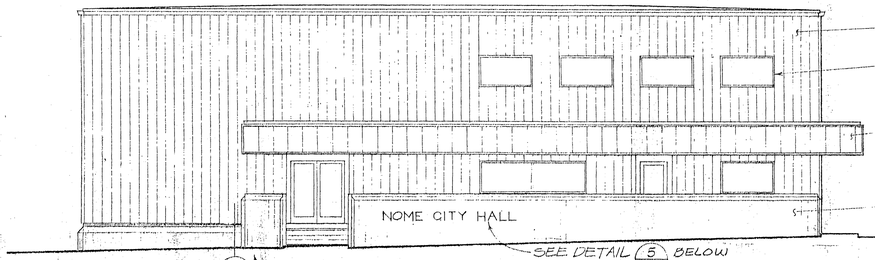

2 3-3 EAST ELEVATION
1/8" = 1'-0"

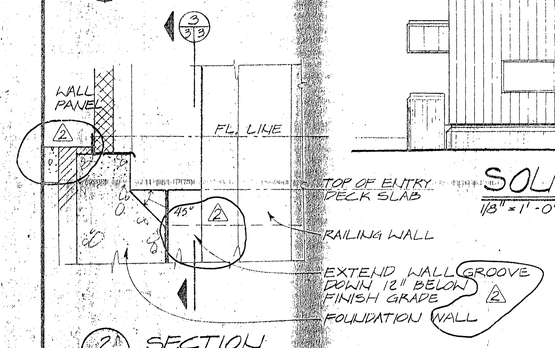

2 A-3 A-3 SECTION
1½" = 1'-0"

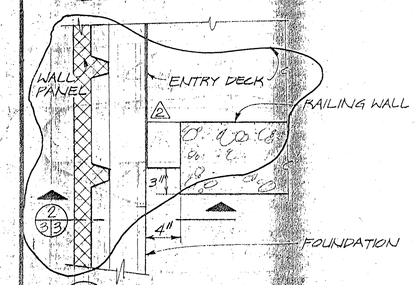

1 A-3 A-3 PLAN
1½" = 1'-0"

ENTRY DECK/FOUNDATION WALL DETAILS-TYPICAL

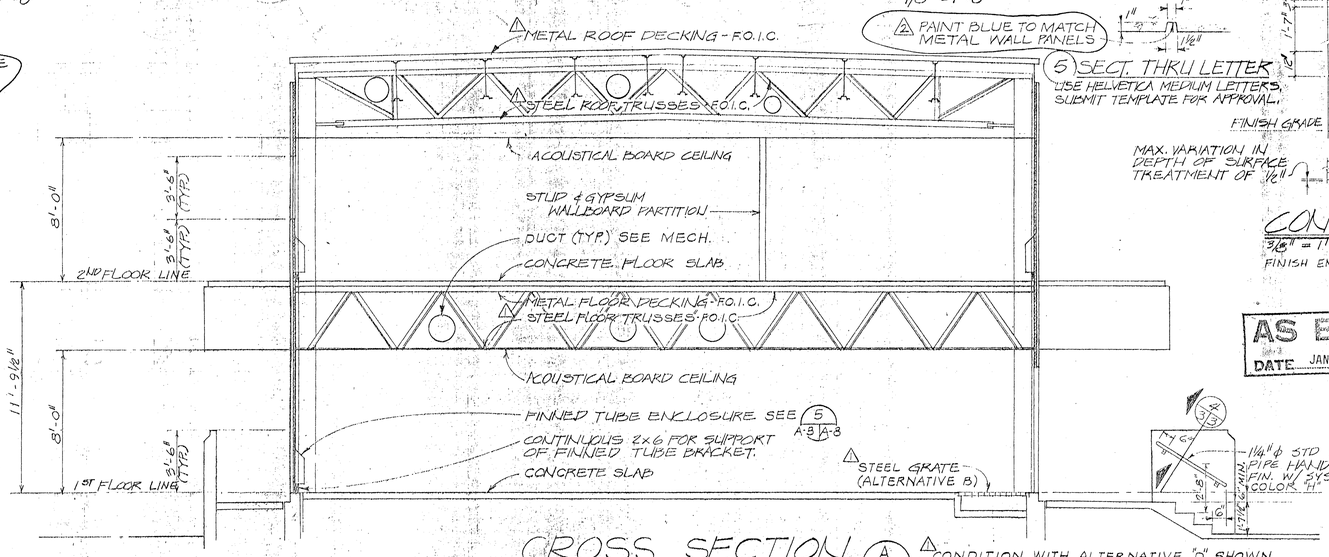

CROSS SECTION
1/4" = 1'-0"

A A-1 A-3 △CONDITION WITH ALTERNATIVE "D" SHOWN

△2 PAINT BLUE TO MATCH METAL WALL PANELS

5 SECT. THRU LETTER
USE HELVETICA MEDIUM LETTERS, SUBMIT TEMPLATE FOR APPROVAL.

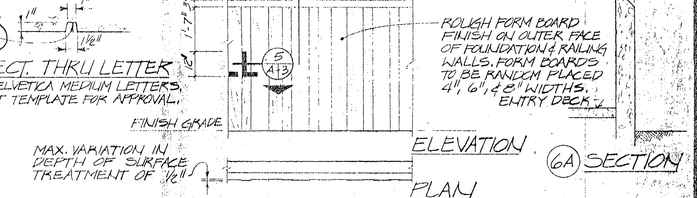

ELEVATION 6A SECTION
PLAN

MAX. VARIATION IN DEPTH OF SURFACE TREATMENT OF ½"

CONCRETE FINISH DETAILS
3/16" = 1'-0" ALTERNATIVE "D" △
FINISH ENTRY DECKS, STAIRS & RAILING WALLS W/ PAINT SYSTEM 7

6 A-3 A-3

AS BUILT
DATE JAN 27 1977

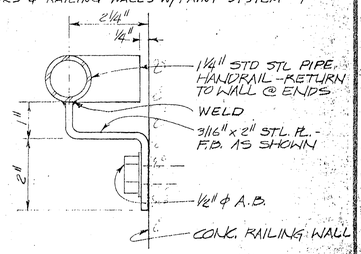

HANDRAIL DETAIL
6" = 1'-0"

4 A-3 A-3

CH2M HILL

DES.	JJP	
DR.	DI	
CHK.	JMY	
APPD.	EAH	

NO.	DATE	REVISION	BY	APPD.
△	12-17-76	AS BUILT		
△	2-6-76	MISCELLANEOUS REVISIONS	GSB	JJP

ELEVATIONS AND SECTION

BASIC BID NO. 1 & ALTERNATIVES "B" & "D"

CITY HALL FOR NOME, ALASKA

SHEET OF 7	A-3
PROJ. NO.	K9327.1
DATE	27 JUNE 76
DWG. NO.	C9327-1

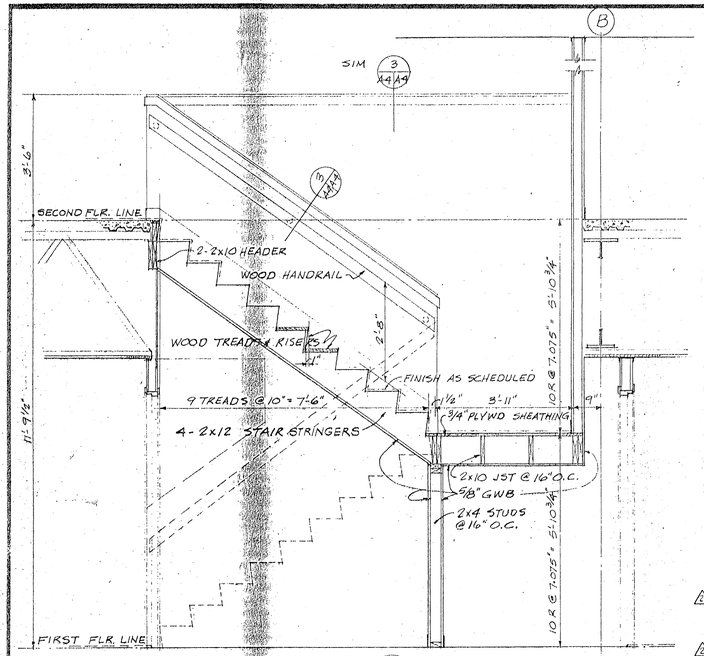

SECTION B (A-1/A-4) STAIR No 1
1/2" = 1'-0"

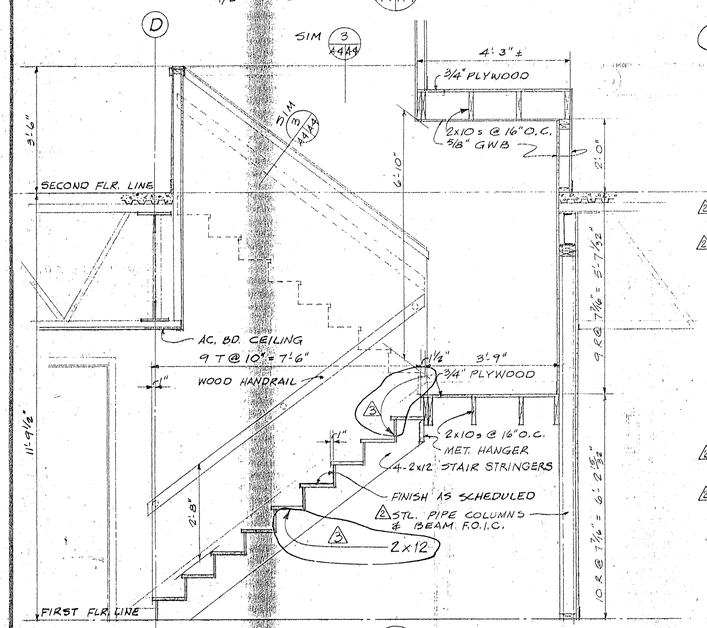

SECTION C (A-1/A-4) STAIR No 2
1/2" = 1'-0"

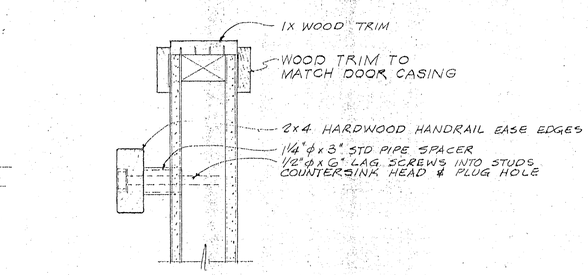

TYPICAL RAILING DETAIL 3 (A-4/A-4)
3" = 1'-0"

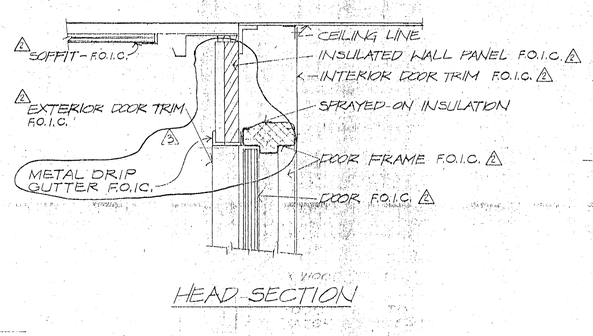

HEAD SECTION

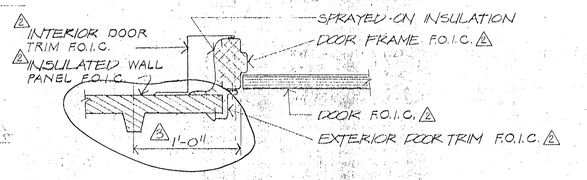

JAMB SECTION

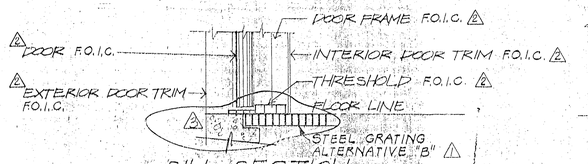

SILL SECTION

DOORWAY DETAILS 2 (A-6/A-4)
1½" = 1'-0"

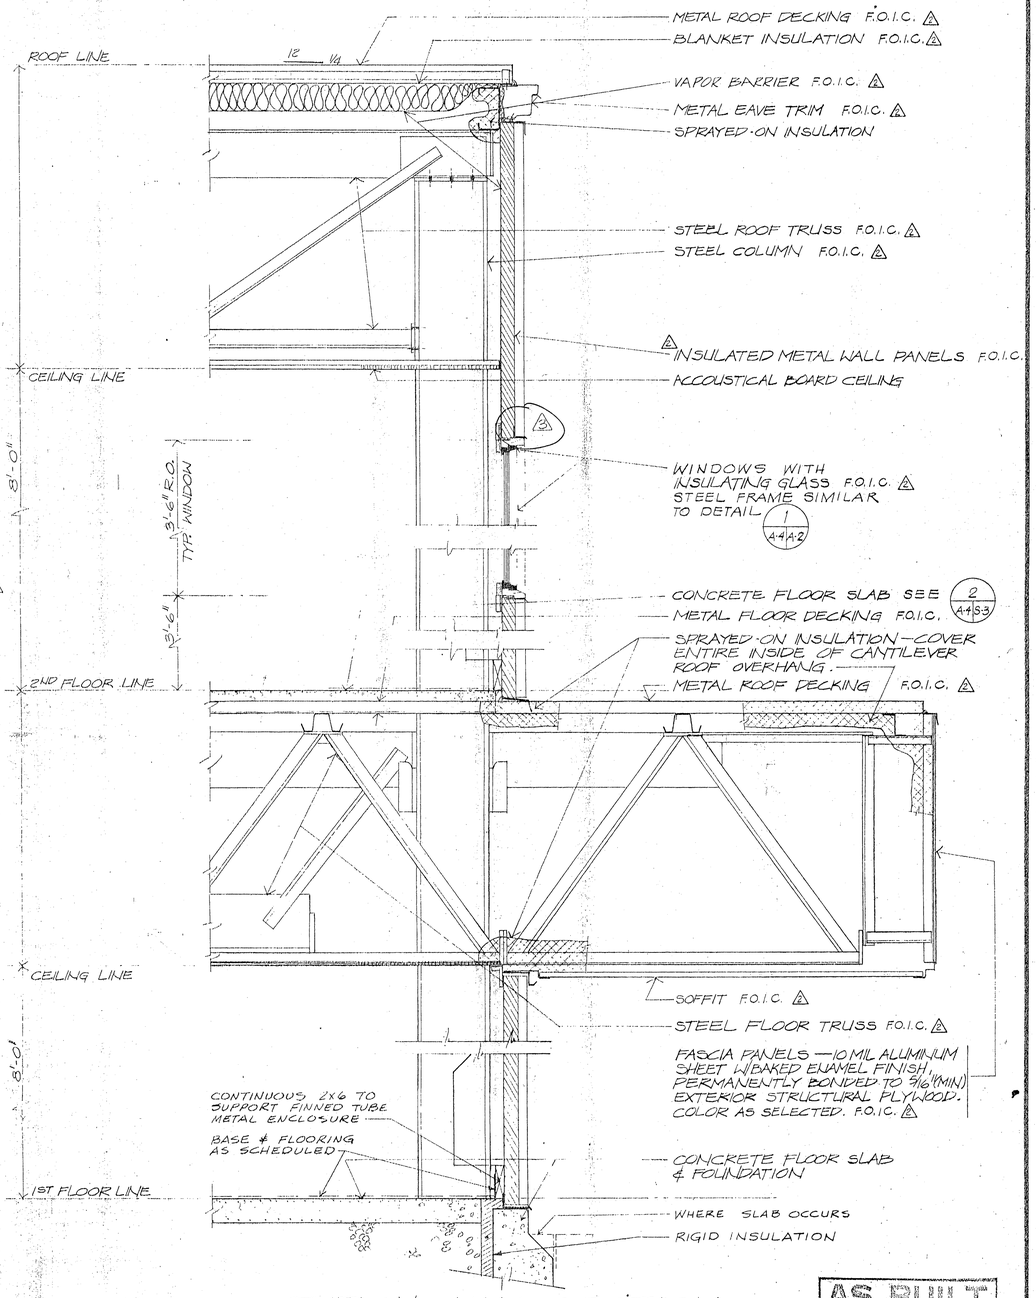

TYPICAL WALL SECTION 1 (A-3/A-4)
1" = 1'-0"

AS BUILT
DATE JAN 27 1977

STATE OF ALASKA
49TH
Raymond A. [illegible]
NO 1331-A
REGISTERED PROFESSIONAL ENGINEER

CH2M HILL ALASKA

DES.	JJP
DR.	
CHK.	JMY
APPD.	EAH

NO.	DATE	REVISION	BY	APPD.
3	12-17-76	AS BUILT		
2	2-6-76	N.I.C. CHANGED TO F.O.I.C.	GEB	JJP
1	2-6-76	MISCELLANEOUS REVISIONS	GEB	JJP

STAIR & WALL SECTIONS AND DETAILS

BASIC BID NO. 1
& ALTERNATIVE "B"

CITY HALL FOR NOME, ALASKA

SHEET OF 7	A-4
PROJ. NO.	K9327.1
DATE	27 JUNE 75
DWG. NO.	C 9327-1

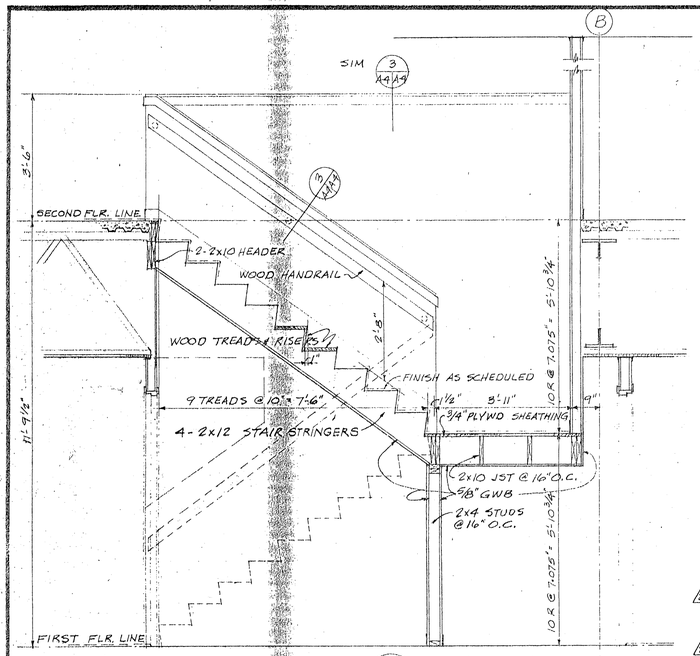

SECTION B STAIR Nº 1
1/2" = 1'-0"

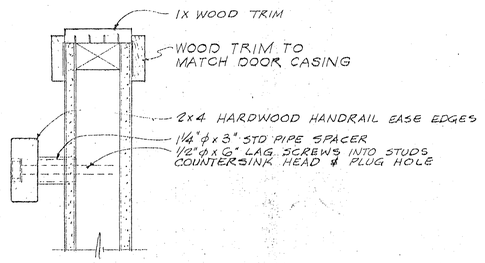

TYPICAL RAILING DETAIL 3 A4/A4
3" = 1'-0"

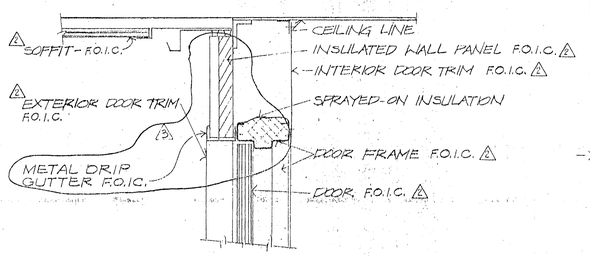

HEAD SECTION

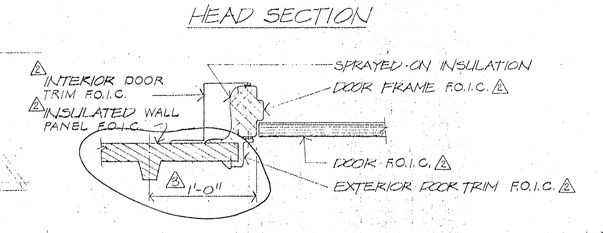

JAMB SECTION

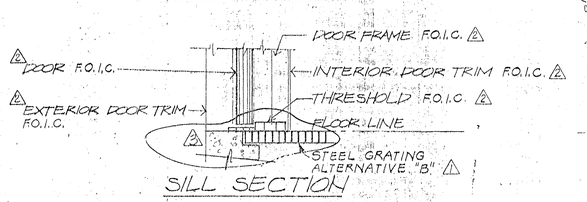

SILL SECTION

DOORWAY DETAILS 2 A6/A9
1 1/2" = 1'-0"

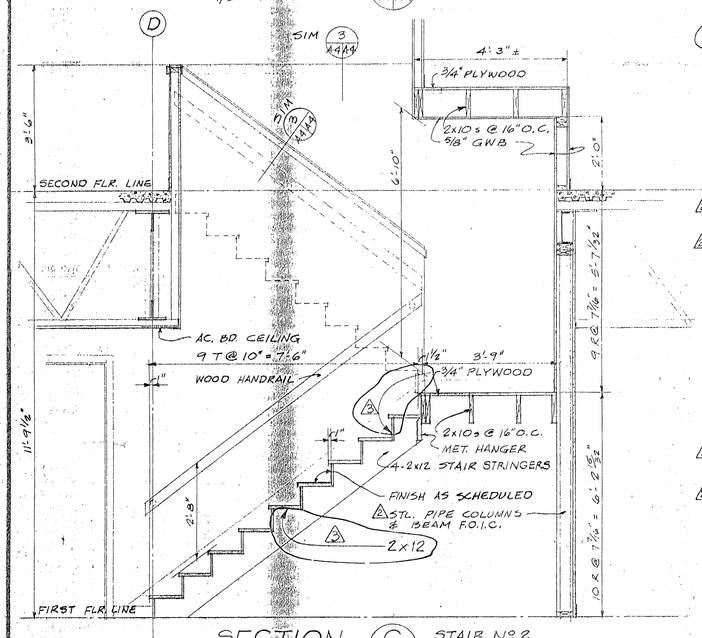

SECTION C STAIR Nº 2
1/2" = 1'-0"

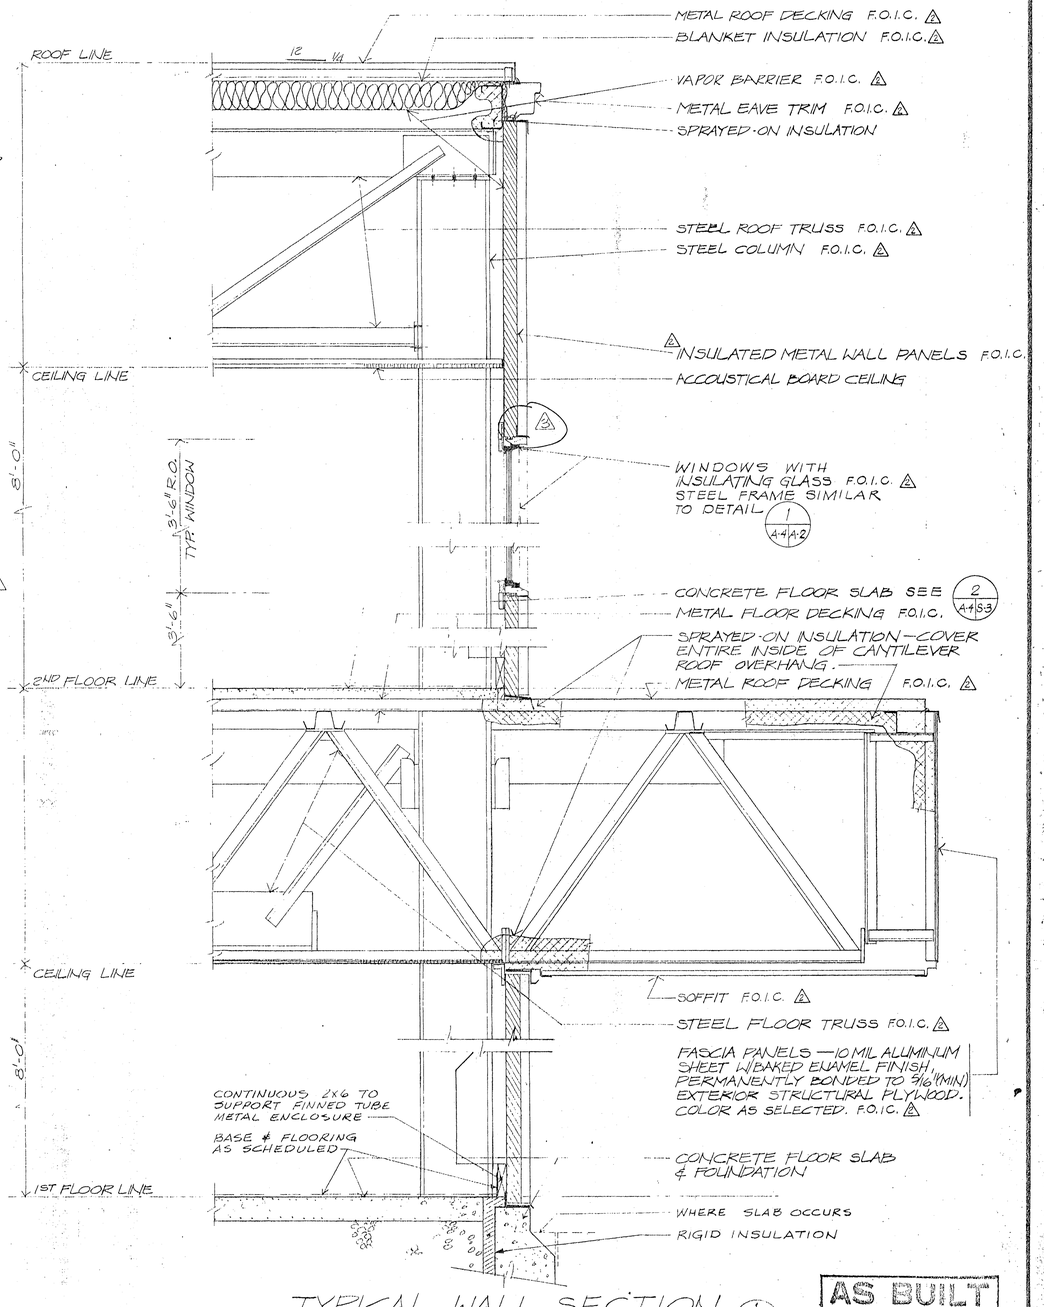

TYPICAL WALL SECTION 1 A3/A4
1" = 1'-0"

AS BUILT
DATE JAN 27 1977

STATE OF ALASKA
49TH
Raymond A. Lowell
NO 1331-A
REGISTERED PROFESSIONAL ENGINEER

CH2M HILL

DES.	JJP			
DR.				
CHK.	JMY			
APPD.	EAH			

NO.	DATE	REVISION	BY	APPD.
3	12-17-76	AS BUILT		
2	2-6-76	N.I.C. CHANGED TO F.O.I.C.	GEB	JJP
1	2-6-76	MISCELLANEOUS REVISIONS	GEB	JJP

STAIR & WALL SECTIONS AND DETAILS

BASIC BID NO. 1
& ALTERNATIVE "B"

CITY HALL FOR NOME, ALASKA

SHEET OF	A-4
PROJ. NO.	K9327.1
DATE	JUNE 75
DWG. NO.	C 9327-1

ROOM ACCESSORIES

"NUMBERS USED ARE "BOBRICK WASHROOM EQUIPMENT, INC." UNLESS NOTED OTHERWISE. TYPICAL MOUNTING HEIGHTS ARE SHOWN ON ROOM ELEVATIONS.

WOMEN 106 & 209

MIRROR W/SHELF (M&S)	B-166 1622
TOILET TISSUE DISPENSER (TPD)	B-284
FEMININE NAPKIN VENDOR (FNV)	B-2802
FEMININE NAPKIN DISPOSAL (FND)	B-270
SOAP DISPENSER (SD)	B-85
PAPER TOWEL DISPENSER (PTD)	B-262
WASTE RECEPTACLE (WR)	B-279
GRAB BAR (GB)	B-4490 x 12" (RM. 106 ONLY)
GRAB BAR (GB)	B-4490 x 24" (RM. 106 ONLY)
ROBE HOOK (RH)	B-2116 (RM. 106 ONLY)

JANITOR 208

MOP & BROOM HOLDER (MBH)	B-223 x 24"

MEN 108 & 207

MIRROR W/SHELF	B-166 1622
TOILET TISSUE DISPENSER	B-284
SOAP DISPENSER	B-85
PAPER TOWEL DISPENSER	B-262
WASTE RECEPTACLE	B-279
GRAB BAR	B-490 x 12" (RM. 108 ONLY)
GRAB BAR	B-490 x 24" (RM. 108 ONLY)
ROBE HOOK	B-2116 (RM. 108 ONLY)

TOILET 119 (ALTERNATIVE "A") 2

MIRROR W/SHELF	B-166 1622
TOILET TISSUE DISPENSER	B-284
SOAP DISPENSER	B-85
PAPER TOWEL DISPENSER	B-262
WASTE RECEPTACLE	B-279
ROBE HOOK	B-2116

JANITOR 107

MOP & BROOM HOLDER (MBH)	B-223 X 24"
SOAP & GRAB (S&G)	B-665
TOWEL BAR (TB)	B-205 X 24"
ROBE HOOK	B-2116
CORNER SHOWER SEAT (CSS)	B-508

NOTES

1. CEILING HEIGHT IS 8'-0" IN ALL AREAS.
2. FINISH CLOSETS AND ALCOVES THE SAME AS AREAS INTO WHICH THEY OPEN.
3. INTERIOR SIDE OF EXTERIOR METAL WALL PANELS ARE FACTORY FINISHED AND ARE NOT TO BE PAINTED IN THIS CONTRACT, UNLESS SPECIFICALLY NOTED IN SCHEDULE.
4. FINISH WOOD WINDOW FRAMES INSIDE AND OUT WITH SYSTEM NUMBER 1, COLOR "H"
5. FINISH ALL INTERIOR WOOD TRIM WITH SYSTEM NUMBER 2, COLOR "R"
6. NUMBERS USED IN "WALLS, FINISH" COLUMN REFER TO PAINT SYSTEMS; LETTERS REFER TO COLORS.

PAINT SYSTEMS

1. WOOD (PAINTED)
   1 COAT ALKYD OR LATEX WOOD PRIMER
   1 COAT ALKYD FINISH, SEMIGLOSS
2. WOOD (STAINED & VARNISHED)
   1 COAT WOOD STAIN
   1 COAT ALKYD SANDING SEALER
   1 COAT ALKYD VARNISH, GLOSS, SANDED
   1 COAT ALKYD VARNISH, SATIN
3. METAL
   1 COAT PRIMER
   2 COATS ALUMINUM PAINT - HIGH HEAT
4. GYPSUM WALLBOARD (ALKYD)
   1 COAT LATEX OR ALKYD PRIMER SEALER
   1 COAT INTERIOR ALKYD STIPPLE, SEMIGLOSS
5. GYPSUM WALLBOARD (LATEX)
   1 COAT LATEX PRIMER SEALER
   1 COAT INTERIOR LATEX STIPPLE, SEMIGLOSS
6. FERROUS METAL (SHOP PRIMED)
   TOUCH-UP W/ALKYD RUST-INHIBITIVE PRIMER
   1 COAT ALKYD ENAMEL, SEMIGLOSS
7. CONCRETE
   2 COATS CLEAR ACRYLIC RESIN SEALER

COLORS

A. CARPET: CCC - TXR-10 FLAMEGARD FG-5559 GOLDEN OCHER 1
B. SEAMLESS FLOOR & WALL COVERING; OMNI-TECH (COLOR & PATTERN TO BE SELECTED FROM 3 GRANULES)
C. STAIR TREADS & RISERS: BURKE #109
D. BASE: BURKE #598-P DARK BROWN
E. V.A.T.: ARMSTRONG EXCELON SUPREME #55504 CREAM
F. NOT USED
G. PAINT: PRATT & LAMBERT #5591, GILT
H. PAINT: P&L #2615, SNOFLAKE
I. PAINT: P&L #5523-1, SUDAN IVORY
J. PAINT: P&L #3103, SALEM STRAW
K. PAINT: P&L #3015, WAXEN YELLOW
L. PAINT: P&L #2557 VANILLA
M. PLASTIC LAMINATE: FORMICA #866 GREEN OLIVE.
N. PLASTIC LAMINATE: FORMICA #868 ABSINTH
O. PLASTIC LAMINATE: FORMICA #881 POPPY
P. TOILET PARTITIONS: MID SOUTH #92M24 SPANISH OLIVE
Q. TOILET PARTITIONS: MID SOUTH #92M26 HARVEST
R. WOOD DOORS, FRAMES, TRIM, CABINET FACES: PRATT & LAMBERT STAIN, TRIM EFFECT T32 V665
S. KICK & PUSH PLATES: DARK BROWN
T. N.I.C. DRAPES: BEIGE WITH LOOSE WOVEN SHADES OF ORANGE, GREEN & GOLD

AS BUILT
DATE JAN. 27, 1977

ROOM FINISH SCHEDULE

LOCATION	ROOM NO.	ROOM NAME	FLOOR MATERIAL	FLOOR FINISH	BASE & WAINSCOT MATERIAL	BASE & WAINSCOT FINISH	WALLS MATERIAL	WALLS FINISH	CEILING MATERIAL	CEILING FINISH	REMARKS
FIRST FLOOR	101	VESTIBULE	CONC.	SMLS	4"	SMLS	–	GWB/MET	*4-H/F	AC BD	F	*PAINT WEST WALL COL
	102	COUNCIL CHAMBER	CPT	F	4"	RUB	F	GWB/MET	4-H/F*	AC BD	F	*PAINT METAL PANELS ONL SOUTH WALL W/ COLOR
	103	LOBBY	CPT	F	4"	RUB	F	GWB/MET	4-H/F	AC BD	F	
	104	CORRIDOR	CPT	F	4"	RUB	F	GWB	4-H	AC BD	F	
	105	CITY CLERK & PLANNING	CPT	F	4"	RUB	F	GWB/MET	*5-H/F	AC BD	F	*PAINT NORTH WALL CO
	106	WOMEN	CONC	SMLS	△ 4'-0"	SMLS	–	GWB	4-I	AC BD	F	WAINSCOT ON ALL WALL TOILET PARTITIONS CO
	107	JANITOR	CONC	SMLS	△ 7'-0"	SMLS	–	GWB	4-H	AC BD	F	WAINSCOT AT SHOWER O
	108	MEN	CONC	SMLS	△ 4'-0"	SMLS	–	GWB	4-I	AC BD	F	WAINSCOT ON ALL WALL TOILET PARTITIONS COLO
	109	KITCHEN	CONC △	SMLS	△ 4"	SMLS	–	GWB/MET	4-I/F	AC BD	F	
	110	VESTIBULE	CONC	–△	4"	RUB	F	GWB/MET	4-H/F	AC BD	F	
	111	TELEPHONE	CONC	–△	4"	RUB	F	GWB	5/H	AC BD △	F	
	112	POLICE 3 2	CONC	–△	4"	RUB	F	GWB/MET	5-H/F	AC BD	F	
	113	VESTIBULE	CONC	–△	4"	RUB	F	GWB/MET	4-H/F	AC BD	F	
	114	PASSAGE	CONC △	SMLS	△ 4"	SMLS	–	GWB	4-H	AC BD	F	
ALTERNATIVE "A" 2	115	POLICE 2 2	CPT △	F	4"	RUB	F	GWB	4-H	AC BD	F	
	116	STORAGE	CPT △	F	4"	RUB	F	GWB	5-H	AC BD	F	
	117	POLICE 1 2	CPT	F	4"	RUB	F	GWB	4-H*	AC BD	F	*PAINT WEST WALL COLO
	118	INTERROGATION	CONC	SMLS	△ 4'-0"	SMLS	–	GWB/MET	4-L/F	AC BD	F	WAINSCOT ON ALL WALL
	119	TOILET	CONC	SMLS	△ 4'-0"	SMLS	–	GWB/MET	4-L/F	AC BD	F	WAINSCOT ON ALL WALL
	120	CHIEF	CPT	F	4"	RUB	F	GWB/MET	5-K/F	AC BD	F	
	121	ENTRY	CONC	SMLS	△ 4"	SMLS	–	GWB/MET	4-H/F	AC BD	F	
	122	VESTIBULE	CONC	SMLS△	△ 4"	SMLS	–	GWB/MET	4-H/F	AC BD	F	
2	123	HEAT	CONC	–△	4"	RUB	F	GWB/MET	–/F	X	—	
	124	STORAGE	CONC	–△	4"	RUB	F	GWB	—	GWB	—	
	125	CHAIR STORAGE	CONC	–△	4"	RUB	F	GWB	4-H	GWB	4-H	
	126	UNFINISHED SPACE	CONC	–△	–		–	GWB/MET	–	AC BD	F	2
SECOND FLOOR	201	CORRIDOR	CPT	F	4"	RUB	F	GWB	*5-H	AC BD	F	PAINT EAST WALL COLO
	202	STORAGE	CONC	–△	4"	RUB	F	GWB/MET	5-H/F	AC BD	F	
	203	FINANCE & ACCTG.	VAT 3	WAX	4"	RUB	F	GWB/MET	5-H/F*	AC BD	F	
	204	AUDITOR	CPT	F	4"	RUB	F	GWB/MET	5-K/F	AC BD	F	
	205	BILLING	CPT	F	4"	RUB	F	GWB/MET	5-K/F	AC BD	F	
	206	COPIER	CPT	F	4"	RUB	F	GWB/MET	5-H/F	AC BD	F	
	207	MEN	CONC	SMLS	△ 4'-0"	SMLS	–	GWB	4-I	AC BD	F	WAINSCOT ON ALL WALL TOILET PARTITIONS COLOR
	208	JANITOR	CONC	SMLS	△ 4'-0"	SMLS	–	GWB	4-H	AC BD	F	WAINSCOT AT SERVICE BA
	209	WOMEN	CONC	SMLS	△ 4'-0"	SMLS	–	GWB	4-I	AC BD	F	WAINSCOT ON ALL WALLS TOILET PARTITIONS COLOR
	210	RECEPTION	CARPET	F	4"	RUB	F	GWB/MET	*5-H/F	AC BD	F	* PAINT WEST WALL COLOR
	211	CITY MANAGER	CARPET	F	4"	RUB	F	GWB/MET	*5-H/F	AC BD	F	*PAINT WEST WALL COLOR
	212	UTILITIES MANAGER	CARPET	F	4"	RUB	F	GWB/MET	5-K/F	AC BD	F	
	213	UTILITIES SUPERVISOR	CARPET	F	4"	RUB	F	GWB/MET	5-K/F	AC BD	F	
	214	PUB. WORKS DIREC.	CARPET	F	4"	RUB	F	GWB	5-K/F	AC BD	F	
	215	UTIL. & PUB. WKS.	CARPET	F	4"	RUB	F	GWB/MET	*5-H/F	AC BD	F	*PAINT EAST WALL COLOR
	216	MECH. EQUIPMENT	CONC	–△	4"	RUB	F	GWB/MET	–/F	AC BD	F	
STAIRS		STAIR NO. 1	CPT	F	4"	RUB	F	GWB	4-H*	AC BD	F	*PAINT SOUTH WALL COLOR
		STAIR NO 2	RUB*	F	4"	RUB	F	GWB	4-H	AC BD	F	*TREADS, RISERS, & LAN

SCHEDULE ABBREVIATIONS

BOT	BOTTOM	MATL	MATERIAL	AC BD	ACOUSTICAL BOARD	X	EXPOSED STRUC
CMU	CONCRETE MASONRY UNIT	MET PAN	METAL PANEL	CONC	CONCRETE	VAT	VINYL-ASBESTOS
DET	DETAIL	MFR	MANUFACTURER	CPT	CARPET	HC	HOLLOW CORE
EXST	EXISTING			F	FACTORY FINISH	HM	HOLLOW METAL
FIN	FINISH	PNLG	PANELING			KA	KEYED ALIKE
GLB	GLASS BLOCK	PLYWD	PLYWOOD	GWB	GYPSUM WALLBOARD	KD	KEYED DIFFERE
				MET	METAL	HD	HARDENER
HDBD	HARDBOARD	REQ'D.	REQUIRED	RUB	RUBBER	PL	PLATE
HDR	HEADER			SMLS	SEAMLESS FLOOR AND WALL COVERING	SC	SOLID CORE
		RM	ROOM			WD	WOOD
				FOIC	FURNISHED BY OWNER, INSTALLED BY CONTRACTOR 1		

CH2M HILL

DES.	JJP
DR.	TH
CHK.	JMY
APPD.	EAH

NO.	DATE	REVISION	BY	APPD.
3	10-17-76	AS BUILT		
2	2-6-76	ADDITION OF ALTERNATIVE "A"	GEB	JJP
1	2-6-76	MISCELLANEOUS REVISIONS	GEB	JJP

ROOM FINISH SCHEDULE

BASIC BID NO. 1 & ALTERNATIVE "A"

CITY HALL FOR HOME, ALASKA

SHEET OF 7 A
PROJ. NO. K
DATE 2-7 J
DWG. NO. C

ROOM ACCESSORIES

NUMBERS USED ARE "BOBRICK WASHROOM EQUIPMENT, INC.", UNLESS NOTED OTHERWISE. TYPICAL MOUNTING HEIGHTS ARE SHOWN ON ROOM ELEVATIONS.

WOMEN 106 & 209

MIRROR W/SHELF (M&S)	B-166	1622
TOILET TISSUE DISPENSER (TPD)	B-284	
FEMININE NAPKIN VENDOR (FNV)	B-2802	
FEMININE NAPKIN DISPOSAL (FND)	B-270	
SOAP DISPENSER (SD)	B-35	
PAPER TOWEL DISPENSER (PTD)	B-262	
WASTE RECEPTACLE (WR)	B-279	
GRAB BAR (GB)	B-490 x 12"	(RM. 106 ONLY)
GRAB BAR (GB)	B-490 x 24"	(RM. 106 ONLY)
ROBE HOOK (RH)	B-2116	(RM. 106 ONLY)

JANITOR 208

MOP & BROOM HOLDER (MBH)	B-223 x 24"

MEN 108 & 207

MIRROR W/SHELF	B-166	1622
TOILET TISSUE DISPENSER	B-284	
SOAP DISPENSER	B-35	
PAPER TOWEL DISPENSER	B-262	
WASTE RECEPTACLE	B-279	
GRAB BAR	B-490 x 12"	(RM. 108 ONLY)
GRAB BAR	B-490 x 24"	(RM. 108 ONLY)
ROBE HOOK	B-2116	(RM. 108 ONLY)

TOILET 119 (ALTERNATIVE "A") 2

MIRROR W/SHELF	B-166	1622
TOILET TISSUE DISPENSER	B-284	
SOAP DISPENSER	B-35	
PAPER TOWEL DISPENSER	B-262	
WASTE RECEPTACLE	B-279	
ROBE HOOK	B-2116	

JANITOR 107

MOP & BROOM HOLDER (MBH)	B-223 X 24"
SOAP & GRAB (S&G)	B-665
TOWEL BAR (TB)	B-205 X24"
ROBE HOOK	B-2116
CORNER SHOWER SEAT (CSS)	B-508

NOTES

1. CEILING HEIGHT IS 8'-0" IN ALL AREAS.
2. FINISH CLOSETS AND ALCOVES THE SAME AS AREAS INTO WHICH THEY OPEN.
3. INTERIOR SIDE OF EXTERIOR METAL WALL PANELS ARE FACTORY FINISHED AND ARE NOT TO BE PAINTED IN THIS CONTRACT, UNLESS SPECIFICALLY NOTED IN SCHEDULE.
4. FINISH WOOD WINDOW FRAMES INSIDE AND OUT WITH SYSTEM NUMBER 1, COLOR "H"
5. FINISH ALL INTERIOR WOOD TRIM WITH SYSTEM NUMBER 2, COLOR "R"
6. NUMBERS USED IN "WALLS, FINISH" COLUMN REFER TO PAINT SYSTEMS; LETTERS REFER TO COLORS.

PAINT SYSTEMS

1. WOOD (PAINTED)
   1 COAT ALKYD OR LATEX WOOD PRIMER
   1 COAT ALKYD FINISH, SEMIGLOSS
2. WOOD (STAINED & VARNISHED)
   1 COAT WOOD STAIN
   1 COAT ALKYD SANDING SEALER
   1 COAT ALKYD VARNISH, GLOSS, SANDED
   1 COAT ALKYD VARNISH, SATIN
3. METAL
   1 COAT PRIMER
   2 COATS ALUMINUM PAINT - HIGH HEAT
4. GYPSUM WALLBOARD (ALKYD)
   1 COAT LATEX OR ALKYD PRIMER SEALER
   1 COAT INTERIOR ALKYD STIPPLE, SEMIGLOSS
5. GYPSUM WALLBOARD (LATEX)
   1 COAT LATEX PRIMER SEALER
   1 COAT INTERIOR LATEX STIPPLE, SEMIGLOSS
6. FERROUS METAL (SHOP PRIMED)
   TOUCH-UP W/ALKYD RUST-INHIBITIVE PRIMER
   1 COAT ALKYD ENAMEL, SEMIGLOSS
7. CONCRETE
   2 COATS CLEAR ACRYLIC RESIN SEALER

COLORS

A. CARPET: CCC - TXR-10 FLAMEGARD FG-5559 GOLDEN OCHER 1
B. SEAMLESS FLOOR & WALL COVERING; OMNI-TECH (COLOR & PATTERN TO BE SELECTED FROM 3 GRANULES)
C. STAIR TREADS & RISERS: BURKE #109
D. BASE: BURKE #598-P DARK BROWN
E. V.A.T.: ARMSTRONG EXCELON SUPREME #55504 CREAM
F. NOT USED
G. PAINT: PRATT & LAMBERT #5591, GILT
H. PAINT: P&L #2615, SNOFLAKE
I. PAINT: P&L #5523-1, SUDAN IVORY
J. PAINT: P&L #3103, SALEM STRAW
K. PAINT: P&L #3015, WAXEN YELLOW
L. PAINT: P&L #2557 VANILLA
M. PLASTIC LAMINATE: FORMICA #866 GREEN OLIVE
N. PLASTIC LAMINATE: FORMICA #868 ABSINTH
O. PLASTIC LAMINATE: FORMICA #881 POPPY
P. TOILET PARTITIONS: MID SOUTH #92M24 SPANISH OLIVE
Q. TOILET PARTITIONS: MID SOUTH #92M26 HARVEST
R. WOOD DOORS, FRAMES, TRIM, CABINET FACES: PRATT & LAMBERT STAIN, TRIM EFFECT T32 V665
S. KICK & PUSH PLATES: DARK BROWN
T. N.I.C. DRAPES: BEIGE WITH LOOSE WOVEN SHADES OF ORANGE, GREEN & GOLD

AS BUILT
DATE JAN 27 1977

ROOM FINISH SCHEDULE

LOCATION	ROOM NO.	ROOM NAME	FLOOR MATERIAL	FLOOR FINISH	BASE & WAINSCOT MATERIAL	BASE & WAINSCOT FINISH	WALLS MATERIAL	WALLS FINISH	CEILING MATERIAL	CEILING FINISH	REMARKS
FIRST FLOOR	101	VESTIBULE	CONC.	SMLS	4" SMLS	–	GWB/MET	*4-H/F	AC BD	F	*PAINT WEST WALL COLOR "G"
	102	COUNCIL CHAMBER	CPT	F	4" RUB	F	GWB/MET	4-H/F*	AC BD	F	*PAINT METAL PANELS ONLY ON SOUTH WALL W/ COLOR "G"
	103	LOBBY	CPT	F	4" RUB	F	GWB/MET	4-H/F	AC BD	F	
	104	CORRIDOR	CPT	F	4" RUB	F	GWB	4-H	AC BD	F	
	105	CITY CLERK & MANNING	CPT	F	4" RUB	F	GWB/MET	*5-H/F	AC BD	F	*PAINT NORTH WALL COLOR "G"
	106	WOMEN	CONC	SMLS	1 4'-0" SMLS	–	GWB	4-I	AC BD	F	WAINSCOT ON ALL WALLS TOILET PARTITIONS COLOR "P"
	107	JANITOR	CONC	SMLS	1 7'-0" SMLS	–	GWB	4-H	AC BD	F	WAINSCOT AT SHOWER ONLY
	108	MEN	CONC	SMLS	1 4'-0" SMLS	–	GWB	4-I	AC BD	F	WAINSCOT ON ALL WALLS TOILET PARTITIONS COLOR "P"
	109	KITCHEN	CONC 1	SMLS	1 4" SMLS	–	GWB/MET	4-I/F	AC BD	F	
	110	VESTIBULE	CONC	– 1	4" RUB	F	GWB/MET	4-H/F	AC BD	F	
	111	TELEPHONE	CONC	– 1	4" RUB	F	GWB	5/H	AC BD 1	F	
	112	POLICE 3 2	CONC	– 1	4" RUB	F	GWB/MET	5-H/F	AC BD	F	
	113	VESTIBULE	CONC	– 1	4" RUB	F	GWB/MET	4-H/F	AC BD	F	
	114	PASSAGE	CONC 1	SMLS	1 4" SMLS	–	GWB	4-H	AC BD	F	
ALTERNATIVE "A" 2	115	POLICE 2 2	CPT 1	F	4" RUB	F	GWB	4-H	AC BD	F	
	116	STORAGE	CPT 1	F	4" RUB	F	GWB	5-H	AC BD	F	
	117	POLICE 1 2	CPT	F	4" RUB	F	GWB	4-H*	AC BD	F	*PAINT WEST WALL COLOR "J"
	118	INTERROGATION	CONC	SMLS	1 4'-0" SMLS	–	GWB/MET	4-L/F	AC BD	F	WAINSCOT ON ALL WALLS
	119	TOILET	CONC	SMLS	1 4'-0" SMLS	–	GWB/MET	4-L/F	AC BD	F	WAINSCOT ON ALL WALLS
	120	CHIEF	CPT	F	4" RUB	F	GWB/MET	5-K/F	AC BD	F	
	121	ENTRY	CONC	SMLS	1 4" SMLS	–	GWB/MET	4-H/F	AC BD	F	
	122	VESTIBULE	CONC	SMLS 1	1 4" SMLS	–	GWB/MET	4-H/F	AC BD	F	
	123	HEAT	CONC	– 1	4" RUB	F	GWB/MET	–/F	X	—	
	124	STORAGE	CONC	– 1	4" RUB	F	GWB	—	GWB	—	
	125	CHAIR STORAGE	CONC	– 1	4" RUB	F	GWB	4-H	GWB	4-H	
	126	UNFINISHED SPACE	CONC	– 1	–	–	GWB/MET	–	AC BD	F	2
SECOND FLOOR	201	CORRIDOR	CPT	F	4" RUB	F	GWB	*5-H	AC BD	F	PAINT EAST WALL COLOR "J"
	202	STORAGE	CONC	– 1	4" RUB	F	GWB/MET	5-H/F	AC BD	F	
	203	FINANCE & ACCTG.	VAT 3	WAX	4" RUB	F	GWB/MET	5-H/F	AC BD	F	
	204	AUDITOR	CPT	F	4" RUB	F	GWB/MET	5-K/F	AC BD	F	
	205	BILLING	CPT	F	4" RUB	F	GWB/MET	5-K/F	AC BD	F	
	206	COPIER	CPT	F	4" RUB	F	GWB/MET	5-H/F	AC BD	F	
	207	MEN	CONC	SMLS	1 4'-0" SMLS	–	GWB	4-I	AC BD	F	WAINSCOT ON ALL WALLS TOILET PARTITIONS COLOR "Q"
	208	JANITOR	CONC	SMLS	1 4'-0" SMLS	–	GWB	4-H	AC BD	F	WAINSCOT AT SERVICE BASIN 1
	209	WOMEN	CONC	SMLS	1 4'-0" SMLS	–	GWB	4-I	AC BD	F	WAINSCOT ON ALL WALLS TOILET PARTITIONS COLOR "Q"
	210	RECEPTION	CARPET	F	4" RUB	F	GWB/MET	*5-H/F	AC BD	F	* PAINT WEST WALL COLOR "J"
	211	CITY MANAGER	CARPET	F	4" RUB	F	GWB/MET	*5-H/F	AC BD	F	*PAINT WEST WALL COLOR "J"
	212	UTILITIES MANAGER	CARPET	F	4" RUB	F	GWB/MET	5-K/F	AC BD	F	
	213	UTILITIES SUPERVISOR	CARPET	F	4" RUB	F	GWB/MET	5-K/F	AC BD	F	
	214	PUB. WORKS DIREC.	CARPET	F	4" RUB	F	GWB	5-K/F	AC BD	F	
	215	UTIL. & PUB. WKS.	CARPET	F	4" RUB	F	GWB/MET	*5-H/F	AC BD	F	* PAINT EAST WALL COLOR "J"
	216	MECH. EQUIPMENT	CONC	– 1	4" RUB	F	GWB/MET	–/F	AC BD	F	
STAIRS		STAIR NO. 1	CPT	F	4" RUB	F	GWB	4-H*	AC BD	F	*PAINT SOUTH WALL COLOR "G"
		STAIR NO 2	RUB*	F	4" RUB	F	GWB	4-H	AC BD	F	*TREADS, RISERS, & LANDINGS

SCHEDULE ABBREVIATIONS

BOT	BOTTOM	MATL	MATERIAL	AC BD	ACOUSTICAL BOARD	X	EXPOSED STRUCTURE
CMU	CONCRETE MASONRY UNIT	MET PAN	METAL PANEL	CONC	CONCRETE	VAT	VINYL-ASBESTOS TILE
DET	DETAIL	MFR	MANUFACTURER	CPT	CARPET	HC	HOLLOW CORE
EXST	EXISTING			F	FACTORY FINISH	HM	HOLLOW METAL
FIN	FINISH	PNLG	PANELING			KA	KEYED ALIKE
GLB	GLASS BLOCK	PLYWD	PLYWOOD	GWB	GYPSUM WALLBOARD	KD	KEYED DIFFERENT
				MET	METAL	HD	HARDENER
HDBD	HARDBOARD	REQ'D.	REQUIRED	RUB	RUBBER	PL	PLATE
HDR.	HEADER			SMLS	SEAMLESS FLOOR AND WALL COVERING	SC	SOLID CORE
		RM	ROOM			WD	WOOD
				FOIC	FURNISHED BY OWNER, INSTALLED BY CONTRACTOR 1		

CH2M HILL
DES. JJP
DR. DI
CHK. JMY
APPD. EAH

NO.	DATE	REVISION	BY	APPD.
3	12-17-76	AS BUILT		
2	2-6-76	ADDITION OF ALTERNATIVE "A"	GEB	JJP
1	2-6-76	MISCELLANEOUS REVISIONS	GEB	JJP

ROOM FINISH SCHEDULE

BASIC BID NO. 1 & ALTERNATIVE "A"

CITY HALL FOR HOME, ALASKA

SHEET OF 7 A-5
PROJ. NO. K9327.1
DATE 27 JUNE 75
DWG. NO. C9327-1

ROOM ACCESSORIES

NUMBERS USED ARE BOBRICK WASHROOM EQUIPMENT, INC.', UNLESS NOTED OTHERWISE. TYPICAL MOUNTING HEIGHTS ARE SHOWN ON ROOM ELEVATIONS.

WOMEN 106 & 209

MIRROR W/SHELF (M&S)	B-166 1622
TOILET TISSUE DISPENSER (TPD)	B-284
FEMININE NAPKIN VENDOR (FNV)	B-2802
FEMININE NAPKIN DISPOSAL (FND)	B-270
SOAP DISPENSER (SD)	B-85
PAPER TOWEL DISPENSER (PTD)	B-262
WASTE RECEPTACLE (WR)	B-279
GRAB BAR (GB)	B-490 x 12" (RM. 106 ONLY)
GRAB BAR (GB)	B-490 x 24" (RM. 106 ONLY)
ROBE HOOK (RH)	B-2116 (RM. 106 ONLY)

JANITOR 208

MOP & BROOM HOLDER (MBH)	B-223 x 24"

MEN 108 & 207

MIRROR W/SHELF	B-166 1622
TOILET TISSUE DISPENSER	B-284
SOAP DISPENSER	B-85
PAPER TOWEL DISPENSER	B-262
WASTE RECEPTACLE	B-279
GRAB BAR	B-490 x 12" (RM. 108 ONLY)
GRAB BAR	B-490 x 24" (RM. 108 ONLY)
ROBE HOOK	B-2116 (RM. 108 ONLY)

TOILET 119 (ALTERNATIVE "A") △2

MIRROR W/SHELF	B-166 1622
TOILET TISSUE DISPENSER	B-284
SOAP DISPENSER	B-85
PAPER TOWEL DISPENSER	B-262
WASTE RECEPTACLE	B-279
ROBE HOOK	B-2116

JANITOR 107

MOP & BROOM HOLDER (MBH)	B-223 X 24"
SOAP & GRAB (S&G)	B-665
TOWEL BAR (TB)	B-205 X 24"
ROBE HOOK	B-2116
CORNER SHOWER SEAT (CSS)	B-508

NOTES

1. CEILING HEIGHT IS 8'-0" IN ALL AREAS.
2. FINISH CLOSETS AND ALCOVES THE SAME AS AREAS INTO WHICH THEY OPEN.
3. INTERIOR SIDE OF EXTERIOR METAL WALL PANELS ARE FACTORY FINISHED AND ARE NOT TO BE PAINTED IN THIS CONTRACT, UNLESS SPECIFICALLY NOTED IN SCHEDULE.
4. FINISH WOOD WINDOW FRAMES INSIDE AND OUT WITH SYSTEM NUMBER 1, COLOR "H"
5. FINISH ALL INTERIOR WOOD TRIM WITH SYSTEM NUMBER 2, COLOR "R"
6. NUMBERS USED IN "WALLS, FINISH" COLUMN REFER TO PAINT SYSTEMS; LETTERS REFER TO COLORS.

PAINT SYSTEMS

1. WOOD (PAINTED)
   1 COAT ALKYD OR LATEX WOOD PRIMER
   1 COAT ALKYD FINISH, SEMIGLOSS
2. WOOD (STAINED & VARNISHED)
   1 COAT WOOD STAIN
   1 COAT ALKYD SANDING SEALER
   1 COAT ALKYD VARNISH, GLOSS, SANDED
   1 COAT ALKYD VARNISH, SATIN
3. METAL
   1 COAT PRIMER
   2 COATS ALUMINUM PAINT - HIGH HEAT
4. GYPSUM WALLBOARD (ALKYD)
   1 COAT LATEX OR ALKYD PRIMER SEALER
   1 COAT INTERIOR ALKYD STIPPLE, SEMIGLOSS
5. GYPSUM WALLBOARD (LATEX)
   1 COAT LATEX PRIMER SEALER
   1 COAT INTERIOR LATEX STIPPLE, SEMIGLOSS
6. FERROUS METAL (SHOP PRIMED)
   TOUCH-UP WALKYD RUST-INHIBITIVE PRIMER
   1 COAT ALKYD ENAMEL, SEMIGLOSS
7. CONCRETE
   2 COATS CLEAR ACRYLIC RESIN SEALER

COLORS

A. CARPET: CCC - TXR-10 FLAMEGARD FG-5539 GOLDEN OCHER △1
B. SEAMLESS FLOOR & WALL COVERING; OMNI-TECH (COLOR & PATTERN TO BE SELECTED FROM 3 GRANULES)
C. STAIR TREADS & RISERS: BURKE #109
D. BASE: BURKE #598-P, DARK BROWN
E. V.A.T.: ARMSTRONG EXCELON SUPREME #55504 CREAM
F. NOT USED
G. PAINT: PRATT & LAMBERT #5591, GILT
H. PAINT: P&L #2615, SNOFLAKE
I. PAINT: P&L #5523-1, SUDAN IVORY
J. PAINT: P&L #3103, SALEM STRAW
K. PAINT: P&L #3015, WAXEN YELLOW
L. PAINT: P&L #2557 VANILLA
M. PLASTIC LAMINATE: FORMICA #866 GREEN OLIVE
N. PLASTIC LAMINATE: FORMICA #868 ABSINTH
O. PLASTIC LAMINATE: FORMICA #881 POPPY
P. TOILET PARTITIONS: MID SOUTH #92M24 SPANISH OLIVE
Q. TOILET PARTITIONS: MID SOUTH #92M26 HARVEST
R. WOOD DOORS, FRAMES, TRIM, CABINET FACES: PRATT & LAMBERT STAIN, TRIM EFFECT: T32 V693
S. KICK & PUSH PLATES: DARK BROWN
T. N.I.C. DRAPES: BEIGE WITH LOOSE WOVEN SHADES OF ORANGE, GREEN & GOLD

AS BUILT
DATE JAN. 27 1977

ROOM FINISH SCHEDULE

LOCATION	ROOM NO.	ROOM NAME	FLOOR MATERIAL	FLOOR FINISH	BASE & WAINSCOT MATERIAL	BASE & WAINSCOT FINISH	WALLS MATERIAL	WALLS FINISH	CEILING MATERIAL	CEILING FINISH	REMARKS
FIRST FLOOR	101	VESTIBULE	CONC.	SMLS	4" SMLS	-	GWB/MET	*4-H/F	AC BD	F	*PAINT WEST WALL COLOR "G"
	102	COUNCIL CHAMBER	CPT	F	4" RUB	F	GWB/MET	4-H/F*	AC BD	F	*PAINT METAL PANELS ONLY ON SOUTH WALL W/ COLOR "G"
	103	LOBBY	CPT	F	4" RUB	F	GWB/MET	4-H/F	AC BD	F	
	104	CORRIDOR	CPT	F	4" RUB	F	GWB	4-H	AC BD	F	
	105	CITY CLERK & PLANNING	CPT	F	4" RUB	F	GWB/MET	*6-H/F	AC BD	F	*PAINT NORTH WALL COLOR "G"
	106	WOMEN	CONC	SMLS	△ 4'-0" SMLS	-	GWB	4-I	AC BD	F	WAINSCOT ON ALL WALLS TOILET PARTITIONS COLOR "P"
	107	JANITOR	CONC	SMLS	△ 7'-0" SMLS	-	GWB	4-H	AC BD	F	WAINSCOT AT SHOWER ONLY
	108	MEN	CONC	SMLS	△ 4'-0" SMLS	-	GWB	4-I	AC BD	F	WAINSCOT ON ALL WALLS TOILET PARTITIONS COLOR "P"
	109	KITCHEN	CONC △	SMLS	△ 4" SMLS	-	GWB/MET	4-I/F	AC BD	F	
	110	VESTIBULE	CONC	-△	4" RUB	F	GWB/MET	4-H/F	AC BD	F	
	111	TELEPHONE	CONC	-△	4" RUB	F	GWB	5/H	AC BD △	F	
	112	POLICE 3 △2	CONC	-△	4" RUB	F	GWB/MET	5-H/F	AC BD	F	
	113	VESTIBULE	CONC	-△	4" RUB	F	GWB/MET	4-H/F	AC BD	F	
	114	PASSAGE	CONC △	SMLS	△ 4" SMLS	-	GWB	4-H	AC BD	F	
ALTERNATIVE "A" △2	115	POLICE 2 △2	CPT △	F	4" RUB	F	GWB	4-H	AC BD	F	
	116	STORAGE	CPT △	F	4" RUB	F	GWB	5-H	AC BD	F	
	117	POLICE 1 △2	CPT	F	4" RUB	F	GWB	4-H*	AC BD	F	*PAINT WEST WALL COLOR "J"
	118	INTERROGATION	CONC	SMLS	△ 4'-0" SMLS	-	GWB/MET	4-L/F	AC BD	F	WAINSCOT ON ALL WALLS
	119	TOILET	CONC	SMLS	△ 4'-0" SMLS	-	GWB/MET	4-L/F	AC BD	F	WAINSCOT ON ALL WALLS
	120	CHIEF	CPT	F	4" RUB	F	GWB/MET	5-K/F	AC BD	F	
	121	ENTRY	CONC	SMLS	△ 4" SMLS	-	GWB/MET	4-H/F	AC BD	F	
	122	VESTIBULE	CONC	SMLS△	△ 4" SMLS	-	GWB/MET	4-H/F	AC BD	F	
	123	HEAT	CONC	-△	4" RUB	F	GWB/MET	-/F	X	—	
	124	STORAGE	CONC	-△	4" RUB	F	GWB	—	GWB	—	
	125	CHAIR STORAGE	CONC	-△	4" RUB	F	GWB	4-H	GWB	4-H	
	126	UNFINISHED SPACE	CONC	-△	-	-	GWB/MET	—	AC BD	F	△2
SECOND FLOOR	201	CORRIDOR	CPT	F	4" RUB	F	GWB	*5-H	AC BD	F	PAINT EAST WALL COLOR "J"
	202	STORAGE	CONC	-△	4" RUB	F	GWB/MET	5-H/F	AC BD	F	
	203	FINANCE & ACCTG.	VAT △2	WAX	4" RUB	F	GWB/MET	5-H/F	AC BD	F	
	204	AUDITOR	CPT	F	4" RUB	F	GWB/MET	5-K/F	AC BD	F	
	205	BILLING	CPT	F	4" RUB	F	GWB/MET	5-K/F	AC BD	F	
	206	COPIER	CPT	F	4" RUB	F	GWB/MET	5-H/F	AC BD	F	
	207	MEN	CONC	SMLS	△ 4'-0" SMLS	-	GWB	4-I	AC BD	F	WAINSCOT ON ALL WALLS TOILET PARTITIONS COLOR "Q"
	208	JANITOR	CONC	SMLS	△ 4'-0" SMLS	-	GWB	4-H	AC BD	F	WAINSCOT AT SERVICE BASIN △
	209	WOMEN	CONC	SMLS	△ 4'-0" SMLS	-	GWB	4-I	AC BD	F	WAINSCOT ON ALL WALLS TOILET PARTITIONS COLOR "Q"
	210	RECEPTION	CARPET	F	4" RUB	F	GWB/MET	*5-H/F	AC BD	F	*PAINT WEST WALL COLOR "J"
	211	CITY MANAGER	CARPET	F	4" RUB	F	GWB/MET	*5-H/F	AC BD	F	*PAINT WEST WALL COLOR "J"
	212	UTILITIES MANAGER	CARPET	F	4" RUB	F	GWB/MET	5-K/F	AC BD	F	
	213	UTILITIES SUPERVISOR	CARPET	F	4" RUB	F	GWB/MET	5-K/F	AC BD	F	
	214	PUB. WORKS DIREC.	CARPET	F	4" RUB	F	GWB	5-K/F	AC BD	F	
	215	UTIL. & PUB. WKS.	CARPET	F	4" RUB	F	GWB/MET	*5-H/F	AC BD	F	*PAINT EAST WALL COLOR "J"
	216	MECH. EQUIPMENT	CONC	-△	4" RUB	F	GWB/MET	-/F	AC BD	F	
STAIRS		STAIR NO. 1	CPT	F	4" RUB	F	GWB	4-H*	AC BD	F	*PAINT SOUTH WALL COLOR "G"
		STAIR NO. 2	RUB*	F	4" RUB	F	GWB	4-H	AC BD	F	*TREADS, RISERS, & LANDINGS

SCHEDULE ABBREVIATIONS

BOT	BOTTOM	MATL	MATERIAL	AC BD	ACOUSTICAL BOARD
CMU	CONCRETE MASONRY UNIT	MET PAN	METAL PANEL	CONC	CONCRETE
DET	DETAIL	MFR	MANUFACTURER	CPT	CARPET
EXST	EXISTING			F	FACTORY FINISH
FIN	FINISH	PNLG	PANELING		
GLB	GLASS BLOCK	PLYWD	PLYWOOD	GWB	GYPSUM WALLBOARD
				MET	METAL
HDBD	HARDBOARD	REQ'D.	REQUIRED	RUB	RUBBER
HDR.	HEADER			SMLS	SEAMLESS FLOOR AND WALL COVERING
		RM	ROOM	FOIC	FURNISHED BY OWNER, INSTALLED BY CONTRACTOR △

X	EXPOSED STRUCTURE
VAT	VINYL-ASBESTOS TILE
HC	HOLLOW CORE
HM	HOLLOW METAL
KA	KEYED ALIKE
KD	KEYED DIFFERENT
HD	HARDENER
PL	PLATE
SC	SOLID CORE
WD	WOOD

STATE OF ALASKA 1912 Raymond Wilson Registered Architect

CH2M HILL

DES.	JJP
DR.	DH
CHK.	JMY
APPD.	EAH

NO.	DATE	REVISION	BY	APPD.
3	12.17.76	AS BUILT		
2	2-6-76	ADDITION OF ALTERNATIVE "A"	GEB	JJP
1	2-6-76	MISCELLANEOUS REVISIONS	GEB	JJP

ROOM FINISH SCHEDULE

BASIC BID NO. 1 & ALTERNATIVE "A"

CITY HALL FOR HOME, ALASKA

SHEET OF 7 A-5
PROJ. NO. K9327.1
DATE 27 JUNE 75
DWG. NO. C9327-1

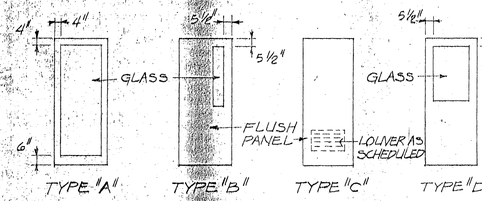

DOOR TYPES

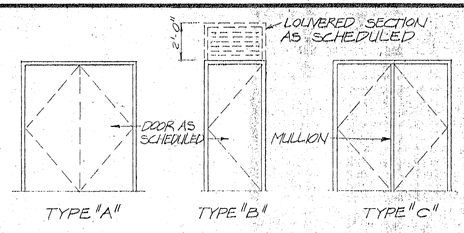

FRAME TYPES

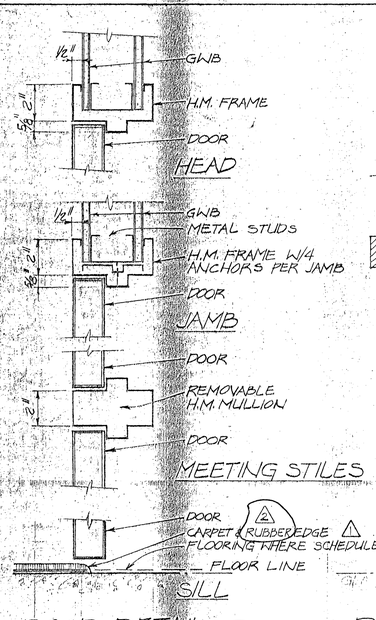

DOOR DETAIL 1

3" = 1'-0" (A-6 | A-6)

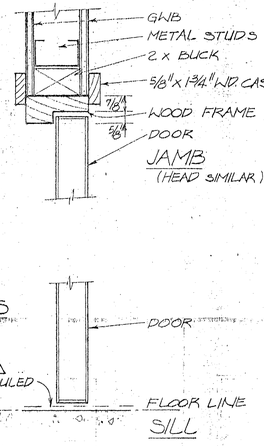

DOOR DETAIL 2

3" = 1'-0" (A-6 | A-6)

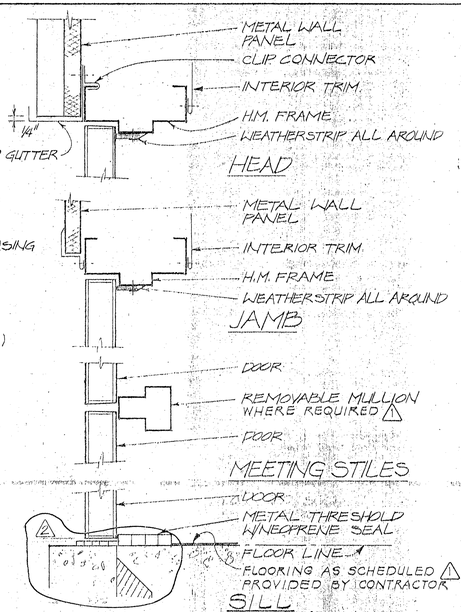

DOOR DETAIL 3

3" = 1'-0" (A-6 | A-6)

△ ALL DOOR ITEMS NOTED IN DETAIL 3 ARE FURNISHED BY OWNER & INSTALLED BY CONTRACTOR.

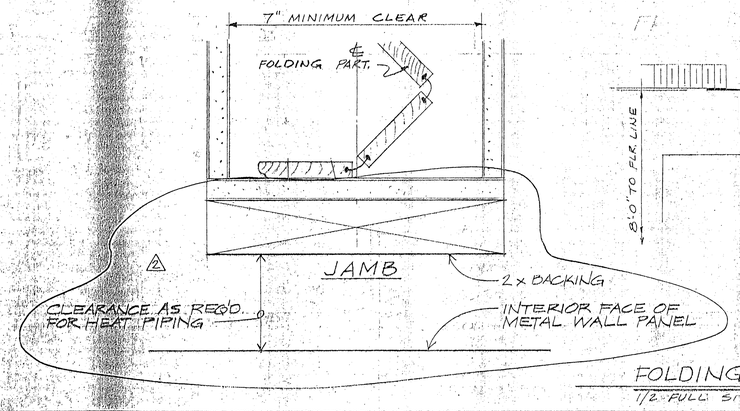

FOLDING PARTITION DET. 4

1/2" FULL SIZE (A/a | A-6 | A/a)

DOOR AND FRAME SCHEDULE

LOCATION	NO.	OPENING SIZE W	OPENING SIZE H	OPENING DOOR THICK.	OPENING DOOR TYPE	OPENING DOOR MATERIAL	OPENING DOOR FINISH	OPENING DOOR GLASS	FRAME TYPE	FRAME MATERIAL	FRAME FINISH	FRAME DETAILS HEAD	FRAME DETAILS JAMB	FRAME DETAILS SILL	HARDWARE SET Nº.	HARDWARE KEY GROUP	REMARKS
FIRST FLOOR	101	6'-0"	7'-0"	1¾"	2xA (1)	HM	6-H	¼" ℄	A	HM	6-H	2(A-6/A-4)	2(A-6/A-4)	2(A-6/A-4)	1	KA-1	F.O.I.C. △
	102 A	6-2	7-0	1¾	2xB (1)	S.C. WD	2-R	¼" ℄	C	HM	6-H	1	1	1	2	KA-1	
	102 B	3-0	(2) 7-0	1¾	C	HM	6-H	—	B	HM	6-H	3	3	3	3	—	F.O.I.C. △
	103 A	6-2	7-0	1¾	2xB (1)	SC WD	2-R	¼" ℄	C	HM	6-H	1	1	1	4	—	
	104	3-0	7-0	1¾	C	SC WD	2-R	—	B	WD	2-R	2	2	1	5	—	
	105 A	3-0	7-0	1¾	C	SC WD	2-R	—	B	WD	2-R	2	2	2	6	KA-2	
	105 B	3-0	7-0	1¾	C	SC WD	2-R	—	B	WD	2-R	2	2	1	6	KA-2	
	106	2-8	7-0	1¾	C	SC WD	2-R	—	B	WD	2-R	2	2	1	7	—	SIGN: "WOMEN"
	107	2-6	7-0	1¾	C	SC WD	2-R	—	B	WD	2-R	2	2	1	6	KA-3	
	108	2-8	7-0	1¾	C	SC WD	2-R	—	B	WD	2-R	2	2	1	7	—	SIGN: "MEN"
	109 A	3-0	7-0	1¾	C	SC WD	2-R	—	B	WD	2-R	2	2	1	6	KA-1	
	109 B	3-0	7-0	1¾	B	SC WD	2-R	¼" ℄	B	WD	2-R	2	2	1	6	KA-1	
	110	3-0	7-0	1¾	C	HM	6-H	—	B	HM	6-H	3	3	3	8	KA-1	F.O.I.C. △
	111	4'-4"	7-0	1⅜	2xC	HC WD	2-R	—	B	WD	2-R	2	2	2	9	(2)	
	112 A	3-0	7-0	1¾	C	SC WD	2-R	—	B	WD	2-R	2	2	1	11	—	
	112 B	3-0	7-0	1¾	C	SC WD	2-R	—	B	WD	2-R	2	2	2	6	KA-2	
	113	3-0	7-0	1¾	B	HM	6-H	¼" ℄	B	HM	6-H	3	3	3	8	KA-2	F.O.I.C. △
	114	3-0	7-0	1¾	B	SC WD	2-R	¼" ℄	B	WD	2-R	2	2	2	5	—	
	115	3-0	7-0	1¾	C	SC WD	2-R	—	B	WD	2-R	2	2	2	10	KA-4	
ALTERNATIVE "A"	116	2-6	7-0	1⅜	C	HC WD	2-R	—	B	WD	2-R	2	2	1	6	KA-4	
	117	3-0	7-0	1¾	C	SC WD	2-R	—	B	WD	2-R	2	2	1	6	KA-2	(2)
	118	2-6	7-0	1¾	B	SC WD	2-R	¼" ℄	B	WD	2-R	2	2	1	12	KA-4	
	119	2-4	7-0	1⅜	C	HC WD	2-R	—	B	WD	2-R	2	2	2	13	—	
	120	2-6	7-0	1¾	C	SC WD	2-R	—	B	WD	2-R	2	2	2	6	KD	
	121	3-0	7-0	1¾	B	SC WD	2-R	½" WIRE	B	HM	6-H	1	1	2	5	—	
	122	3-0	7-0	1¾	B	HM	6-H	½" ℄ (2)	B	HM	6-H	2(A-6/A-4)	2(A-6/A-4)	2(A-6/A-4)	8	KA-4	F.O.I.C. △
	123	3-0	7-0	1¾	C	(4) HM	6-H		B	HM	6-H	3	3	3	14	KA-3	F.O.I.C. △ SEE NOTE (2)
	124	(4) 3-0	7-0	1¾	C	HC WD	2-R	—	B	WD	2-R	2	2	1	6	KA-3	
	125	6-0	7-0	1⅜	C	HC WD	2-R	—	B	WD	2-R	2	2	1	15	—	
	103 B	14'-0± VERIFY	8-0	—	—	WD	2-R	—	—	—	—	4	4	2	—	KA-2	FOLDING PARTITION
SECOND FLOOR	202 A	3-0	7-0	1¾	C	SC WD	2-R	—	B	WD	2-R	2	2	1	6	KA-2	
	202 B	3-0	7-0	1¾	C	SC WD	2-R	—	B	WD	2-R	2	2	1	6	KA-2	
	203	3-0	7-0	1¾	D	SC WD	2-R	¼ ℄	B	WD	2-R	2	2	2	6	KA-2	
	204	3-0	7-0	1¾	D	SC WD	2-R	¼ ℄	B	WD	2-R	2	2	2	16	—	
	205	3-0	7-0	1¾	C	SC WD	2-R	—	B	WD	2-R	2	2	2	16	—	
	206	3-0	7-0	1¾	B	SC WD	2-R	¼ ℄	B	WD	2-R	2	2	2	6	KA-2	
	207	2-8	7-0	1¾	C	SC WD	2-R	—	B	WD	2-R	2	2	1	7	—	SIGN: "MEN"
	208	2-6	7-0	1¾	C	SC WD	2-R	—	B•	WD	2-R	2	2	1	6	KA-3	
	209	2-8	7-0	1¾	C	SC WD	2-R	—	B	WD	2-R	2	2	1	7	—	SIGN: "WOMEN"
	210	3-0	7-0	1¾	D	SC WD	2-R	¼ ℄	B	WD	2-R	2	2	2	6	KA-2	SIGN: "CITY MANAGER"
	211 A	3-0	7-0	1¾	C	SC WD	2-R	—	B	WD	2-R	2	2	2	16	—	
	211 B	3-0	7-0	1¾	B	SC WD	2-R	¼ ℄	B	WD	2-R	2	2	2	6	KA-2	
	212	3-0	7-0	1¾	B	SC WD	2-R	¼ ℄	B	WD	2-R	2	2	2	6	KA-2	
	213	3-0	7-0	1¾	B	SC WD	2-R	¼ ℄	B	WD	2-R	2	2	2	16	—	
	214	3-0	7-0	1¾	B	SC WD	2-R	¼ ℄	B	WD	2-R	2	2	2	16	—	
	213 A	3-0	7-0	1¾	D	SC WD	2-R	¼ ℄	B	WD	2-R	2	2	2	6	KA-2	SIGNS: "UTILITIES" & "PUBLIC WORKS"
	213 B	3-0	7-0	1⅜	C	HC WD	2-R	—	B	WD	2-R	2	2	2	16	—	
	216	3-0	7-0	1¾	C	SC WD	2-R	—	B	WD	2-R	2	2	1	6	KA-3	1 HOUR RATING △

AS BUILT
DATE JAN 27 1977

NOTES:

1. 2x DENOTES 2 DOORS AT THAT OPENING.
2. 30"x22" LOUVER ABOVE DOOR.
3. SEE SHEET A-5 FOR FINISHES AND ABBREVIATIONS.
4. SEE SPECIFICATION SECTION 8A FOR HARDWARE SETS.
5. PAINT DOOR BUTT HINGES TO MATCH FRAME.
6. KEY GROUP "KA-2" TO PASS "KA-1"; KA-4 TO PASS "KA-1" & "KA-2."
7. DOOR SIGNS: BEST MANUFACTURING CO. PLASTIC SERIES "EC" 1" HIGH WHITE LETTERS ON 2" HIGH BROWN BACKGROUND. ATTACH TO DOORS WITH PHILLIPS HEAD SCREWS.

STATE OF ALASKA 49TH Raymond A. Uhlin No. 6311 REGISTERED PROFESSIONAL ENGINEER

CH2M HILL

NO.	DATE	REVISION	BY	APPD.
3	12.17.76	AS BUILT		
2	2-6-76	MISCELLANEOUS REVISIONS	GEB	JJP

DES. JJP | DR. — | CHK. JMY | APPD. EAH

DOOR AND FRAME SCHEDULE AND DETAILS

BASIC BID NO. 1 & ALTERNATIVE "A"

CITY HALL FOR HOME, ALASKA

SHEET OF 7 A-6 | PROJ. NO. K9327.1 | DATE 27 JUNE 75 | DWG. NO. C9327-1

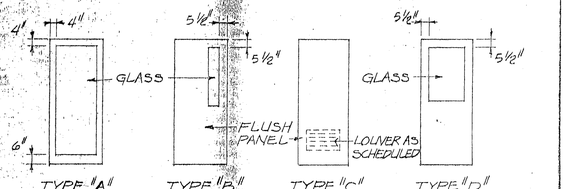

DOOR TYPES

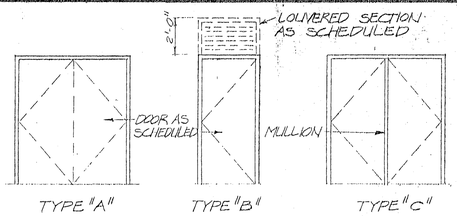

FRAME TYPES

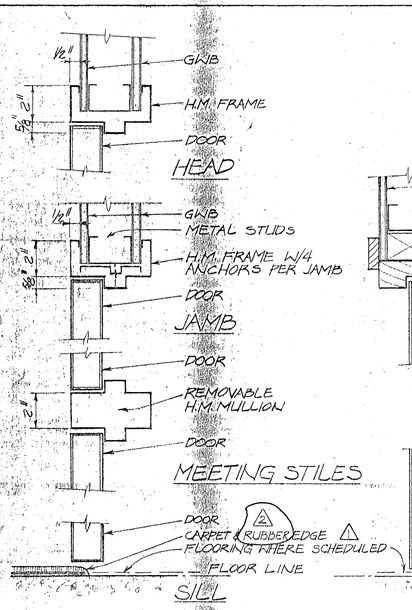

DOOR DETAIL 1

3" = 1'-0" (A-6)(A-6)

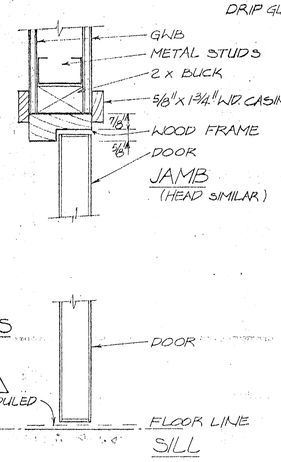

DOOR DETAIL 2

3" = 1'-0" (A-6)(A-6)

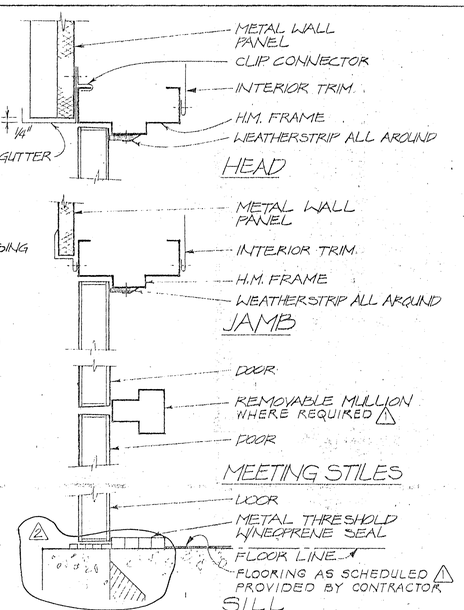

DOOR DETAIL 3

3" = 1'-0" (A-6)(A-6)

△ ALL DOOR ITEMS NOTED IN DETAIL 3 ARE FURNISHED BY OWNER & INSTALLED BY CONTRACTOR

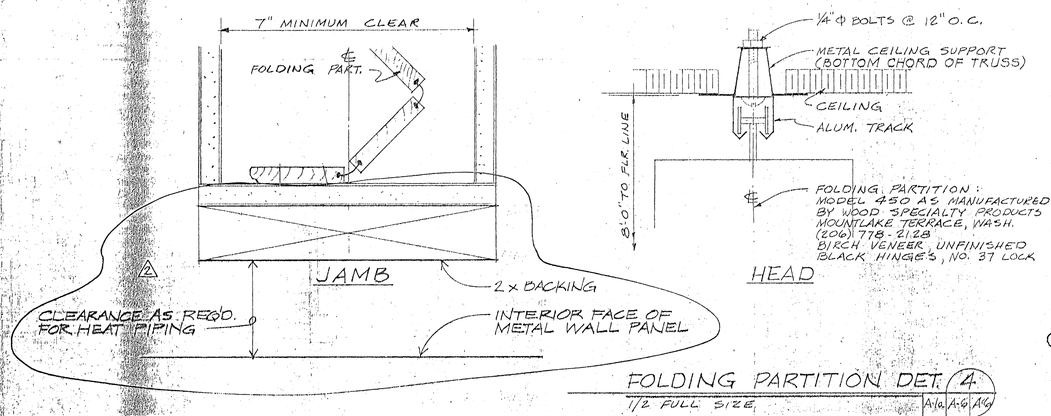

FOLDING PARTITION DET. 4

1/2 FULL SIZE (A-6)(A-6)

DOOR AND FRAME SCHEDULE

LOCATION	NO.	OPENING SIZE W	OPENING SIZE H	DOOR THICK.	DOOR TYPE	DOOR MATERIAL	DOOR FINISH	DOOR GLASS	FRAME TYPE	FRAME MATERIAL	FRAME FINISH	FRAME DETAILS HEAD	FRAME DETAILS JAMB	FRAME DETAILS SILL	HARDWARE SET NO.	HARDWARE KEY GROUP	REMARKS
FIRST FLOOR ALTERNATIVE "A"	101	6'-0"	7'-0"	1¾"	2xA△1	HM	6-H	¼" tempered	A	HM	6-H	2(A-6/A-4)	2(A-6/A-4)	2(A-6/A-4)	1	KA-1	F.O.I.C. △
	102 A	6-2	7-0	1¾	2xB△1	S.C. WD	2-R	¼" tempered	C	HM	6-H	1	1	1	2	KA-1	
	102 B	3-0	(2)7-0	1¾	C	HM	6-H	—	B	HM	6-H	3	3	3	3	—	F.O.I.C. △
	103 A	6-2	7-0	1¾	2xB△1	SC WD	2-R	¼" tempered	C	HM	6-H	1	1	1	4	—	
	104	3-0	7-0	1¾	C	SC WD	2-R	—	B	WD	2-R	2	2	1	5	—	
	105 A	3-0	7-0	1¾	C	SC WD	2-R	—	B	WD	2-R	2	2	2	6	KA-2	
	105 B	3-0	7-0	1¾	C	SC WD	2-R	—	B	WD	2-R	2	2	1	6	KA-2	
	106	2-8	7-0	1¾	C	SC WD	2-R	—	B	WD	2-R	2	2	1	7	—	SIGN: "WOMEN"
	107	2-6	7-0	1¾	C	SC WD	2-R	—	B	WD	2-R	2	2	1	6	KA-3	
	108	2-8	7-0	1¾	C	SC WD	2-R	—	B	WD	2-R	2	2	1	7	—	SIGN: "MEN"
	109 A	3-0	7-0	1¾	C	SC WD	2-R	—	B	WD	2-R	2	2	1	6	KA-1	
	109 B	3-0	7-0	1¾	B	SC WD	2-R	¼" tempered	B	WD	2-R	2	2	1	6	KA-1	
	110	3-0	7-0	1¾	C	HM	6-H	—	B	HM	6-H	3	3	3	8	KA-1	F.O.I.C. △
	111	4'-4"	7-0	1⅜	2xC	HC WD	2-R	—	B	WD	2-R	2	2	2	9	(2) △	
	112 A	3-0	7-0	1¾	C	SC WD	2-R	—	B	WD	2-R	2	2	1	11	—	
	112 B	3-0	7-0	1¾	C	SC WD	2-R	—	B	WD	2-R	2	2	2	6	KA-2	
	113	3-0	7-0	1¾	B	HM	6-H	½" tempered	B	HM	6-H	3	3	3	8	KA-2	F.O.I.C. △
	114	3-0	7-0	1¾	B	SC WD	2-R	¼" tempered	B	WD	2-R	2	2	2	5	—	
	115	3-0	7-0	1¾	C	SC WD	2-R	—	B	WD	2-R	2	2	2	10	KA-4	
	116	2-6	7-0	1⅜	C	HC WD	2-R	—	B	WD	2-R	2	2	1	6	KA-4	
	117	3-0	7-0	1¾	C	SC WD	2-R	—	B	WD	2-R	2	2	1	6	KA-2	(2)
	118	2-6	7-0	1¾	B	SC WD	2-R	¼" tempered	B	WD	2-R	2	2	1	12	KA-4	
	119	2-4	7-0	1⅜	C	HC WD	2-R	—	B	WD	2-R	2	2	2	13	—	
	120	2-6	7-0	1¾	C	SC WD	2-R	—	B	WD	2-R	2	2	2	6	K.D	
	121	3-0	7-0	1¾	B	SC WD	2-R	½" WIRE	B	HM	6-H	1	1	2	5	—	
	122	3-0	7-0	1¾	B	HM	6-H	½" tempered (2)	B	HM	6-H	2(A-6/A-4)	2(A-6/A-4)	2(A-6/A-4)	8	KA-4	F.O.I.C. △
	123	3-0	7-0	1¾	C	HM	6-H		B	HM	6-H	3	3	3	14	KA-3	F.O.I.C. △ SEE NOTE (2)
	124	(2)3-0	7-0	1¾	C	(2) HC WD	2-R	—	B	WD	2-R	2	2	1	6	KA-3	
	125	6-0	7-0	1⅜	C	HC WD	2-R	—	B	WD	2-R	2	2	1	15	—	
	103 B	14'-0" VERIFY	8-0	—	—	W.D	2-R	—	—	—	—	4	4	2	—	KA-2	FOLDING PARTITION
SECOND FLOOR	202	3-0	7-0	1¾	C	SC WD	2-R	—	B	WD	2-R	2	2	1	6	KA-2	
	202 B	3-0	7-0	1¾	C	SC WD	2-R	—	B	WD	2-R	2	2	1	6	KA-2	
	203	3-0	7-0	1¾	D	SC WD	2-R	¼ tempered	B	WD	2-R	2	2	2	6	KA-2	
	204	3-0	7-0	1¾	D	SC WD	2-R	¼ tempered	B	WD	2-R	2	2	2	16	—	
	205	3-0	7-0	1¾	C	SC WD	2-R	—	B	WD	2-R	2	2	2	16	—	
	206	3-0	7-0	1¾	B	SC WD	2-R	¼ tempered	B	WD	2-R	2	2	2	6	KA-2	
	207	2-8	7-0	1¾	C	SC WD	2-R	—	B	WD	2-R	2	2	1	7	—	SIGN: "MEN"
	208	2-6	7-0	1¾	C	SC WD	2-R	—	B	WD	2-R	2	2	1	6	KA-3	
	209	2-8	7-0	1¾	C	SC WD	2-R	—	B	WD	2-R	2	2	1	7	—	SIGN: "WOMEN"
	210	3-0	7-0	1¾	D	SC WD	2-R	¼ tempered	B	WD	2-R	2	2	2	6	KA-2	SIGN: "CITY MANAGER"
	211 A	3-0	7-0	1¾	C	SC WD	2-R	—	B	WD	2-R	2	2	2	16	—	
	211 B	3-0	7-0	1¾	B	SC WD	2-R	¼ tempered	B	WD	2-R	2	2	2	6	KA-2	
	212	3-0	7-0	1¾	B	SC WD	2-R	¼ tempered	B	WD	2-R	2	2	2	6	KA-2	
	213	3-0	7-0	1¾	B	SC WD	2-R	¼ tempered	B	WD	2-R	2	2	2	16	—	
	214	3-0	7-0	1¾	B	SC WD	2-R	¼ tempered	B	WD	2-R	2	2	2	16	—	
	215 A	3-0	7-0	1¾	D	SC WD	2-R	¼ tempered	B	WD	2-R	2	2	2	6	KA-2	SIGNS: "UTILITIES" & "PUBLIC WORKS"
	215 B	3-0	7-0	1⅜	C	HC WD	2-R	—	B	WD	2-R	2	2	2	16	—	
	216	3-0	7-0	1¾	C	SC WD	2-R	—	B	WD	2-R	2	2	1	6	KA-3	1 HOUR RATING (2) △

AS BUILT
DATE JAN. 27 1977

NOTES:

1. 2x DENOTES 2 DOORS AT THAT OPENING.
2. △ 32x22" LOUVER ABOVE DOOR.
3. SEE SHEET A-5 FOR FINISHES AND ABBREVIATIONS.
4. SEE SPECIFICATION SECTION 8A FOR HARDWARE SETS.
5. PAINT DOOR BUTT HINGES TO MATCH FRAME.
6. KEY GROUP "KA-2" TO PASS "KA-1"; KA-4 TO PASS "KA-1" & "KA-2."
7. DOOR SIGNS: BEST MANUFACTURING CO. PLASTIC SERIES "EC" 1" HIGH WHITE LETTERS ON 2" HIGH BROWN BACKGROUND. ATTACH TO DOORS WITH PHILLIPS HEAD SCREWS.

STATE OF ALASKA 49TH — Registered Professional Engineer — No. 5311

CH2M HILL ALASKA

DES. JJP
DR. CH
CHK. JMY
APPD. EAH

NO.	DATE	REVISION	BY	APPD.
2	12.17.76	AS BUILT		
1	2-6-76	MISCELLANEOUS REVISIONS	GEB	JJP

DOOR AND FRAME SCHEDULE AND DETAILS

BASIC BID NO. 1 & ALTERNATIVE "A"

CITY HALL FOR HOME, ALASKA

SHEET OF 7 A-6
PROJ. NO. K9327.1
DATE 27 JUNE 75
DWG. NO. C9327-1

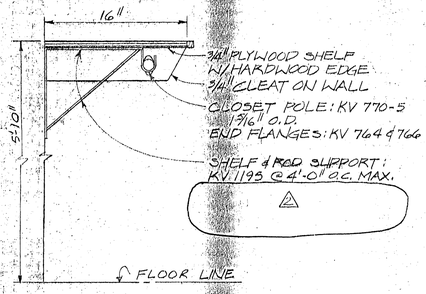

(5) A-1 | A-7 SHELF & ROD DETAIL

1½" = 1'-0"

FINISH SHELF AND SUPPORTS W/ PAINT SYSTEM 1.

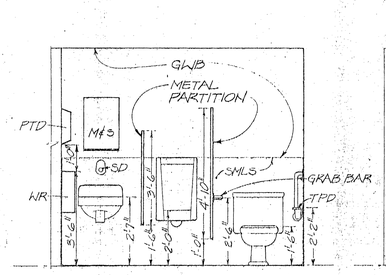

(D) A-1 | A-7 TYPICAL TOILET RM.

3/8" = 1'-0"

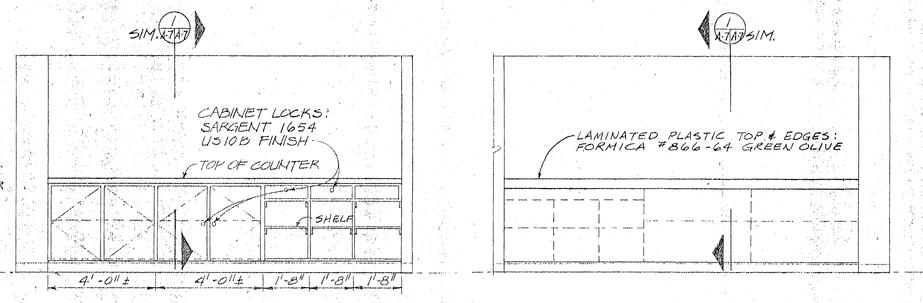

(C) A-1 | A-7 CITY CLERK COUNTER 105

3/8" = 1'-0"

(B) A-1 | A-7 CITY CLERK COUNTER 103

3/8" = 1'-0"

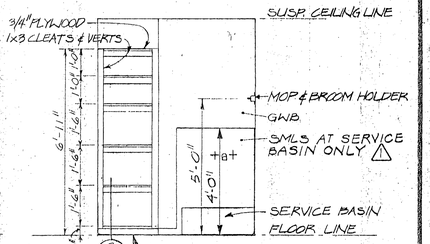

(A) A-2 | A-7 JANITOR RM. 208

3/8" = 1'-0"

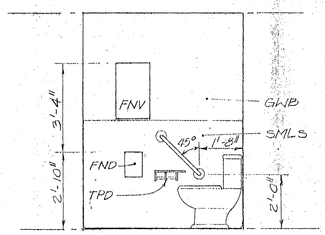

(E) A-1 | A-7 TOILET RM. 106

3/8" = 1'-0"

FOR "ROOM ACCESSORIES" LIST SEE SHEET A-5

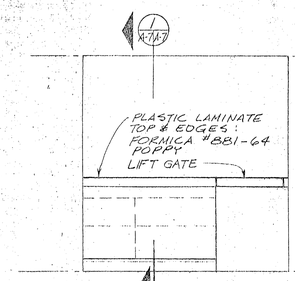

(F) A-1 | A-7 POLICE COUNTER 121

3/8" = 1'-0" ALTERNATIVE "A" ⚠

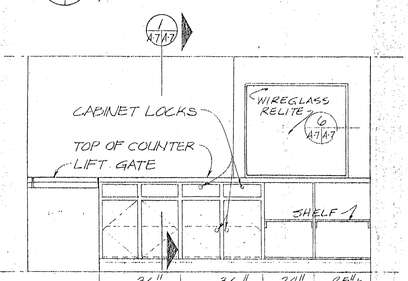

(G) A-1 | A-7 POLICE COUNTER 117

3/8" = 1'-0" ALTERNATIVE "A" ⚠

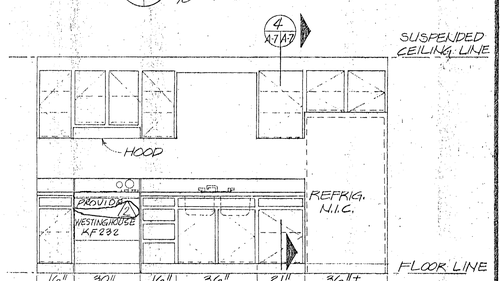

(H) A-1 | A-7 KITCHEN 109

3/8" = 1'-0"

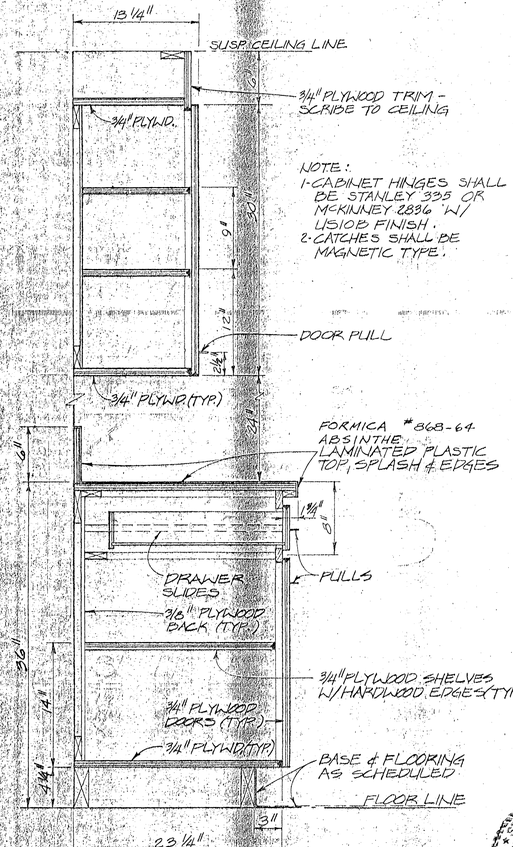

(4) A-7 | A-7 KITCHEN CABINETS

1½" = 1'-0"

FINISH EXPOSED FACES WITH PAINT SYSTEM 2.

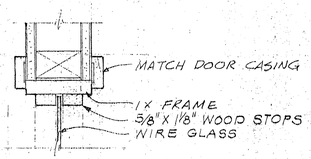

(6) A-7 | A-7 RELITE JAMB

3" = 1'-0"

HEAD SIMILAR

FINISH WOOD TO MATCH DOOR FRAMES.

NOTE: WIRE GLASS SHALL BE POLISHED ¼" BAROQUE MISSISSIPPI WIRE GLASS ⚠

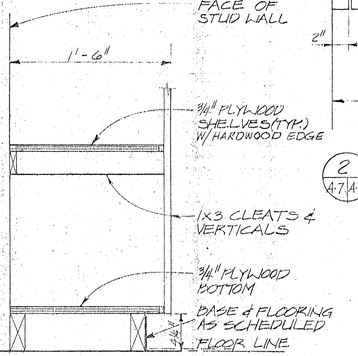

(3) A-7 | A-7 SECTION

1½" = 1'-0"

FINISH WITH SYSTEM 1. COLOR TO MATCH WALL.

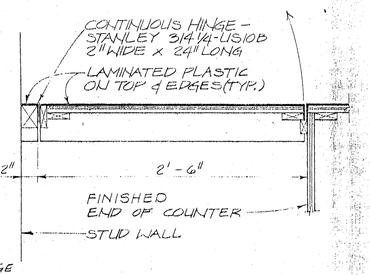

(2) A-7 | A-7 LIFT GATE @ POLICE COUNTER

1½" = 1'-0"

NOTE: FINISH EXPOSED FACES OF COUNTERS & KITCHEN CABINETS WITH PAINT SYSTEM 2, COLOR "R". ⚠

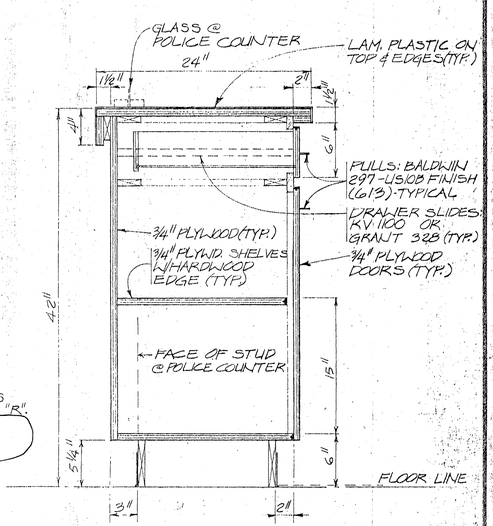

(1) A-7 | A-7 TYPICAL COUNTER

1½" = 1'-0"

STATE OF ALASKA 49TH — Raymond A. Lawson — NO. 1031-A — REGISTERED PROFESSIONAL ENGINEER

AS BUILT DATE JAN 27 1977

CH2M HILL	DES. JJP				
	DR.				
	CHK. JMY	⚠	12-17-76	AS BUILT	
	APPD. ~~SAH~~	⚠	2-6-76	MISCELLANEOUS REVISIONS	GEB JJP
		NO.	DATE	REVISION	BY APPD.

INTERIOR ELEVATIONS AND DETAILS

BASIC BID NO. 1 & ALTERNATIVE "A"

CITY HALL FOR HOME, ALASKA

SHEET OF A-7
PROJ. NO. K9327.1
DATE 27 JUNE 75
DWG. NO. C9327-1

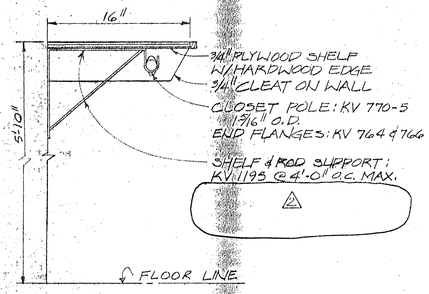

5 SHELF & ROD DETAIL
A-1 | A-7
1½" = 1'-0"
FINISH SHELF AND SUPPORTS W/ PAINT SYSTEM 1.

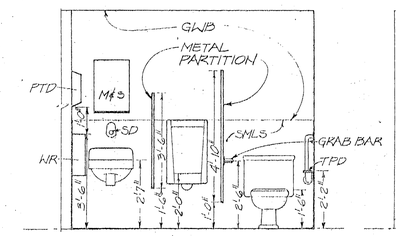

D TYPICAL TOILET RM.
A-1 | A-7
3/8" = 1'-0"

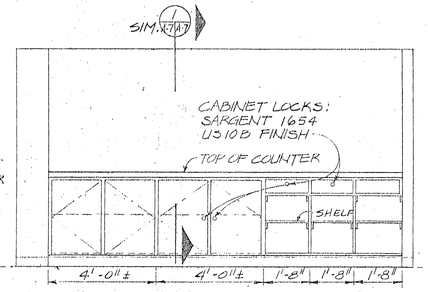

C CITY CLERK COUNTER 105
A-1 | A-7
3/8" = 1'-0"

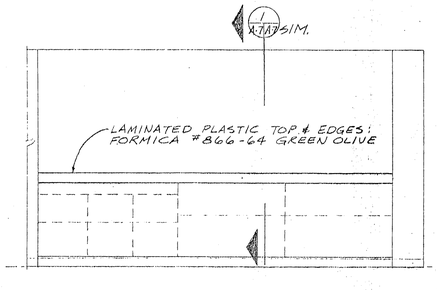

B CITY CLERK COUNTER 103
A-1 | A-7
3/8" = 1'-0"

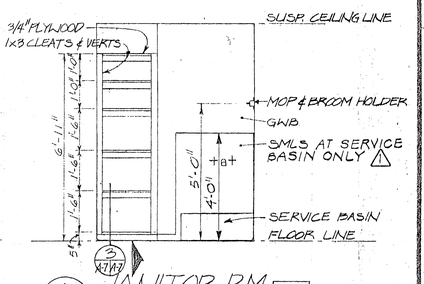

A JANITOR RM. 208
A-2 | A-7
3/8" = 1'-0"

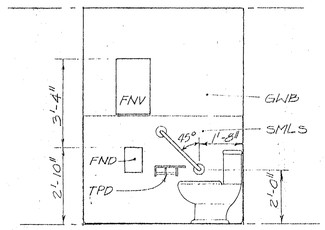

E TOILET RM. 106
A-1 | A-7
3/8" = 1'-0"
FOR ROOM ACCESSORIES LIST SEE SHEET A-5

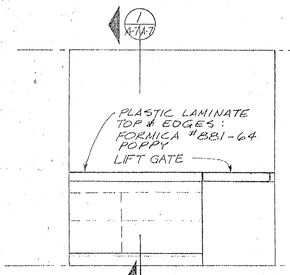

F POLICE COUNTER 121
A-1 | A-7
3/8" = 1'-0" ALTERNATIVE "A" 1

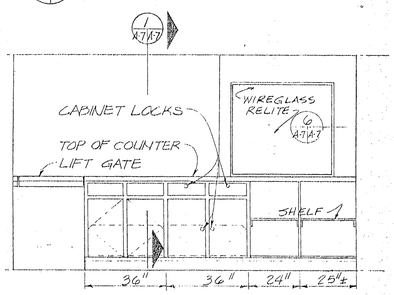

G POLICE COUNTER 117
A-1 | A-7
3/8" = 1'-0" ALTERNATIVE "A" 1

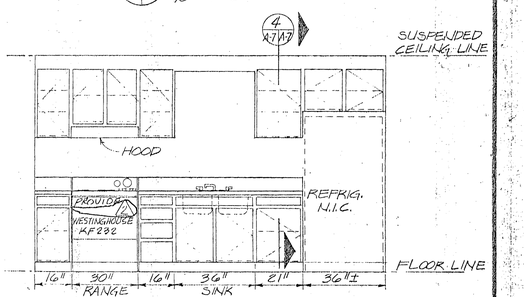

H KITCHEN 109
A-1 | A-7
3/8" = 1'-0"

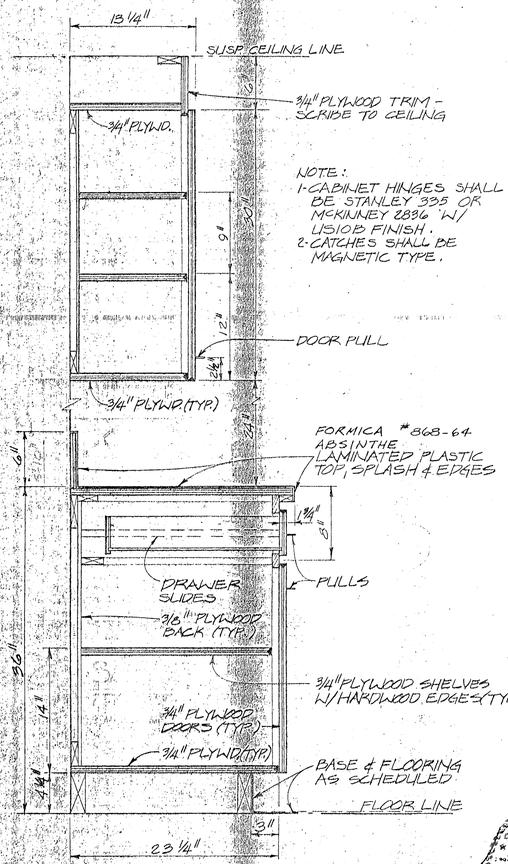

4 KITCHEN CABINETS
A-7 | A-7
1½" = 1'-0"
FINISH EXPOSED FACES WITH PAINT SYSTEM 2.

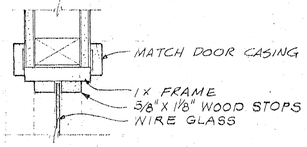

6 RELITE JAMB
A-7 | A-7
3" = 1'-0" HEAD SIMILAR
FINISH WOOD TO MATCH DOOR FRAMES.

NOTE: WIRE GLASS SHALL BE POLISHED ¼" BAROQUE MISSISSIPPI WIRE GLASS 1

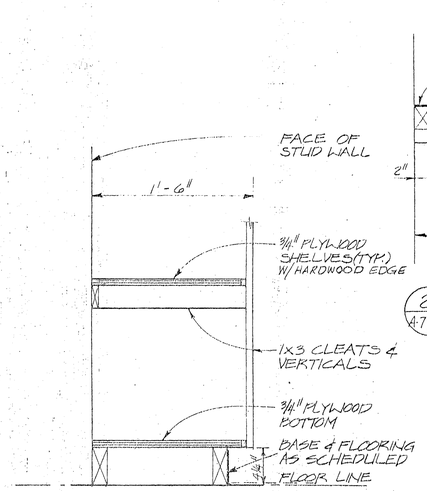

2 LIFT GATE @ POLICE COUNTER
A-7 | A-7
1½" = 1'-0"
NOTE: FINISH EXPOSED FACES OF COUNTERS & KITCHEN CABINETS WITH PAINT SYSTEM 2, COLOR "R" 2

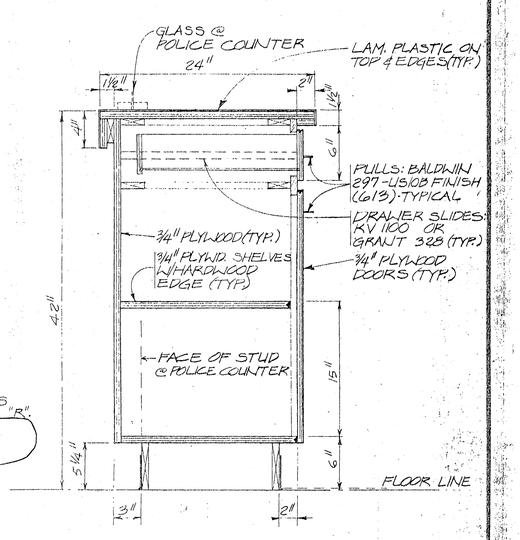

1 TYPICAL COUNTER
A-7 | A-7
1½" = 1'-0"

3 SECTION
A-7 | A-7
1½" = 1'-0"
FINISH WITH SYSTEM 1, COLOR TO MATCH WALL.

STATE OF ALASKA 49TH — Raymond A. Lawson NO. 1931-A — REGISTERED PROFESSIONAL ENGINEER

AS BUILT DATE JAN 27 1977

NO.	DATE	REVISION	BY	APPD.
2	12.17.76	AS BUILT		
1	2-6-76	MISCELLANEOUS REVISIONS	GEB	JJP

CH2M HILL — DES. JJP — DR. — CHK. JMY — APPD. EAH

INTERIOR ELEVATIONS AND DETAILS

BASIC BID NO. 1 & ALTERNATIVE "A"

CITY HALL FOR HOME, ALASKA

SHEET OF A-7
PROJ. NO. K9327.1
DATE 27 JUNE 75
DWG. NO. C9327-1

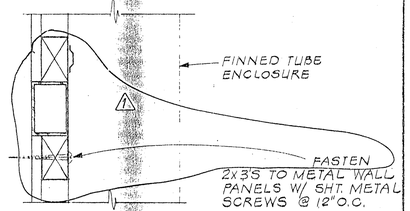

DETAIL 6
3" = 1'-0"

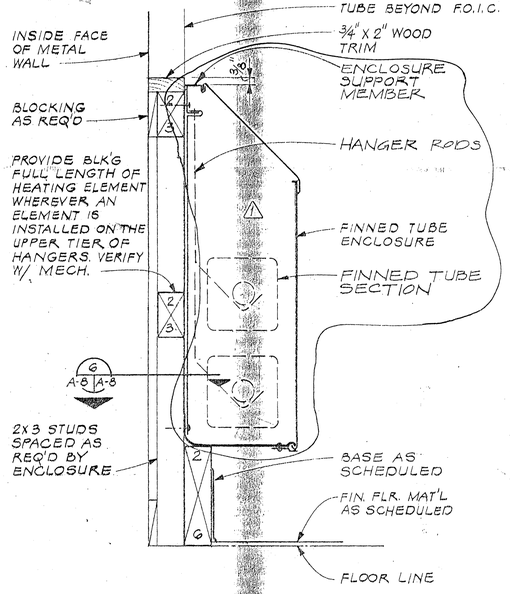

DETAIL 5
3" = 1'-0"

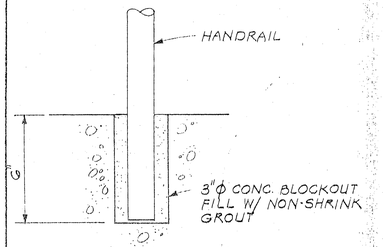

DETAIL 4
3" = 1'-0"

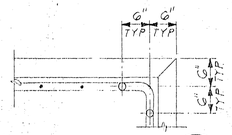

SECTION 8
3/4" = 1'-0"

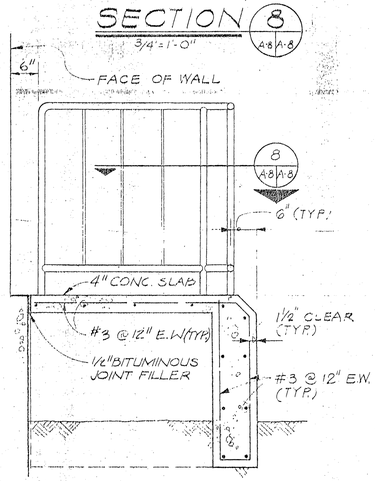

DETAIL 3
3/4" = 1'-0"

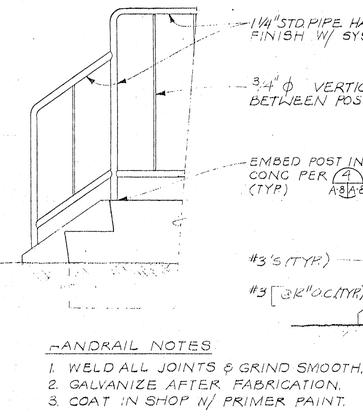

HANDRAIL NOTES
1. WELD ALL JOINTS & GRIND SMOOTH.
2. GALVANIZE AFTER FABRICATION.
3. COAT IN SHOP W/ PRIMER PAINT.

DETAIL 2
3/4" = 1'-0"

DETAIL 1
3/4" = 1'-0"

BASIC BID No. 1

BASIC BID No. 2

AS BUILT
DATE JAN 27 1977

STATE OF ALASKA
49TH
Registered Professional Engineer

CH2M HILL

DES.	JJP
DR.	
CHK.	JMY
APPD.	EAH

NO.	DATE	REVISION	BY	APPD.
1	12-21-76	AS BUILT		

DETAILS

CITY HALL FOR NOME, ALASKA

SHEET OF	A-8
PROJ. NO.	K9327.1
DATE	6 FEB 76
DWG. NO.	C9327-1

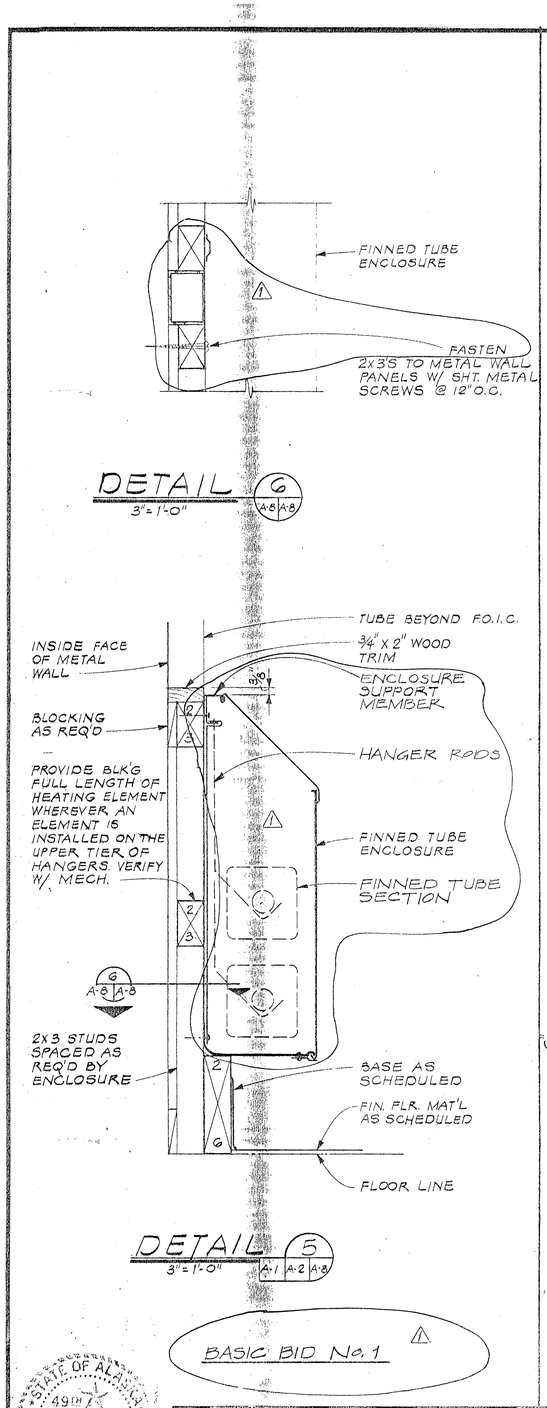

DETAIL 6 (A-8 | A-8)
3" = 1'-0"

DETAIL 5 (A-1 | A-2 | A-8)
3" = 1'-0"

BASIC BID No. 1

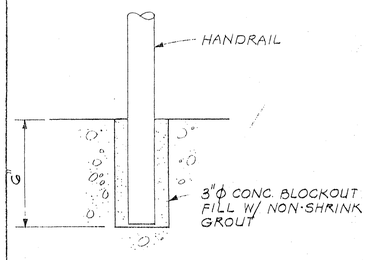

DETAIL 4 (A-8 | A-8)
3" = 1'-0"

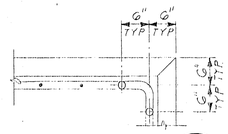

SECTION 8 (A-8 | A-8)
3" = 1'-0"

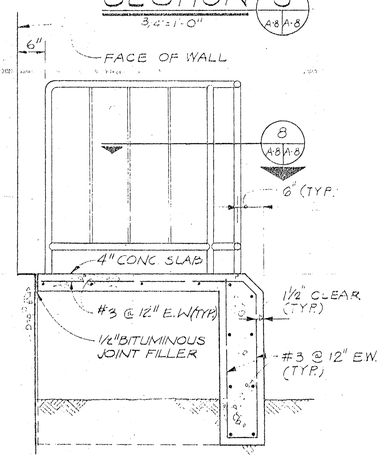

DETAIL 3 (A-10 | A-8)
3/4" = 1'-0"

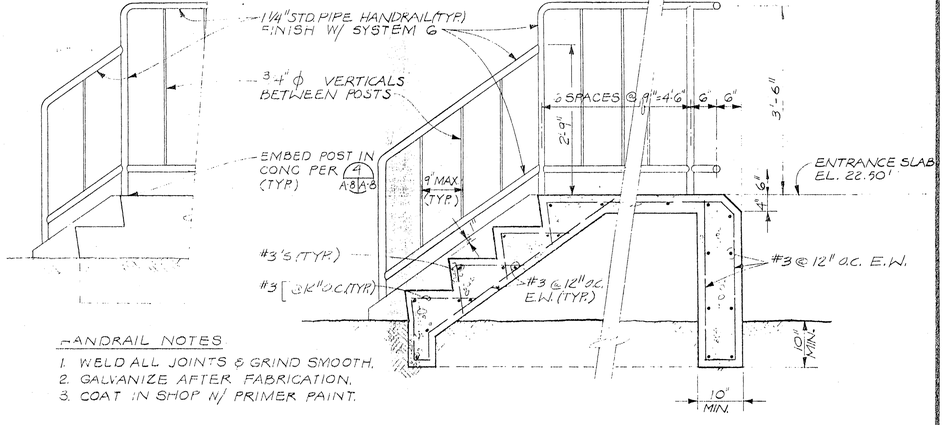

HANDRAIL NOTES
1. WELD ALL JOINTS & GRIND SMOOTH.
2. GALVANIZE AFTER FABRICATION.
3. COAT IN SHOP W/ PRIMER PAINT.

DETAIL 2 (A-10 | A-8)
3/4" = 1'-0"

BASIC BID No. 2

DETAIL 1 (A-10 | A-8)
3/4" = 1'-0"

AS BUILT
DATE JAN 27 1977

STATE OF ALASKA 49TH

CH2M HILL

DES.	JJP
DR.	
CHK.	JMY
A'PD.	EAH

NO.	DATE	REVISION	BY	APPD.
1	12.21.76	AS BUILT		

DETAILS

CITY HALL FOR NOME, ALASKA

SHEET OF	A-8
PROJ. NO.	K9327.1
DATE	6 FEB 76
DWG. NO.	C9327-1

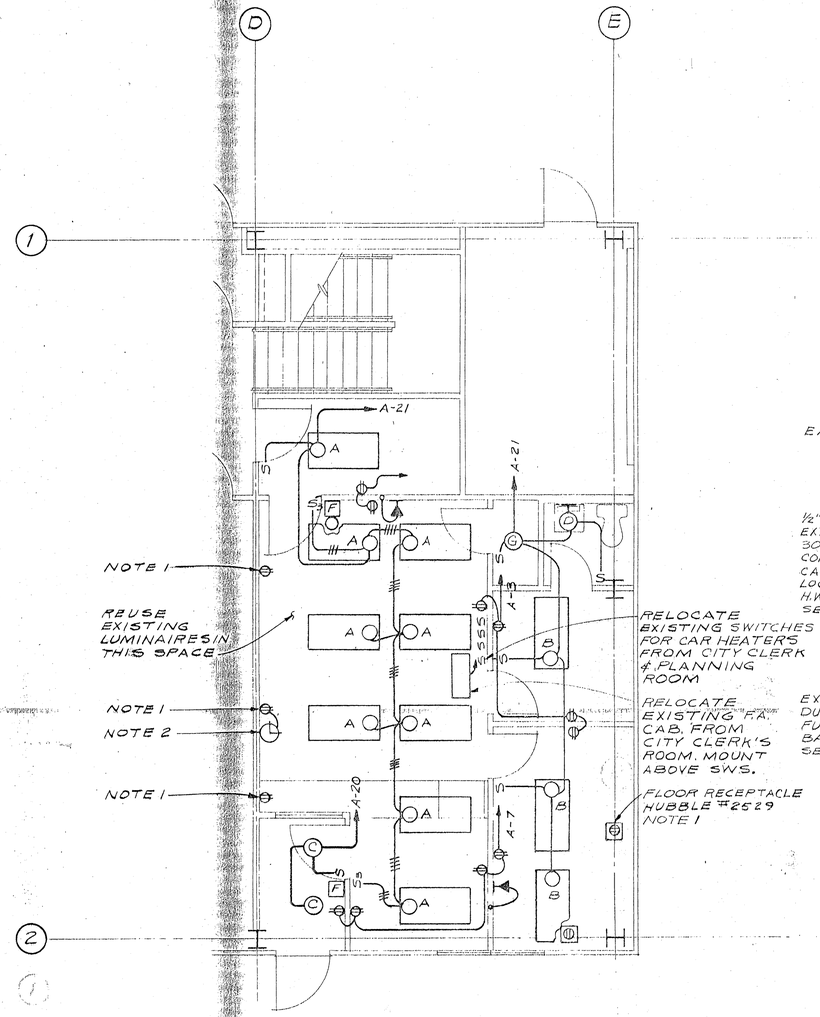

ELECTRICAL PLAN

1/4"=1'-0"

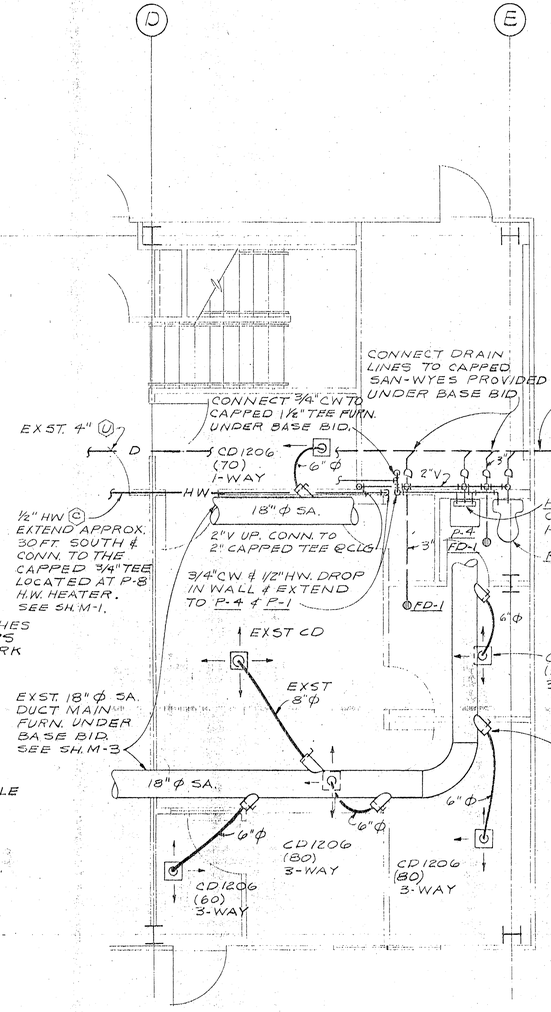

PLUMBING & HEATING PLAN

1/4"=1'-0"

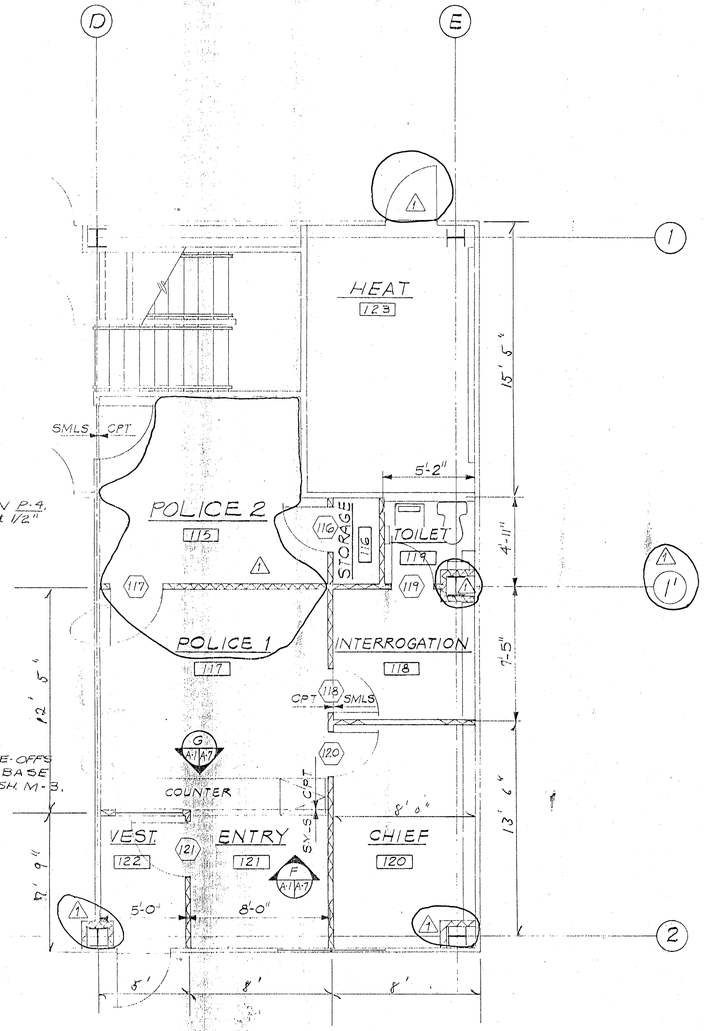

FLOOR PLAN

1/4"=1'-0"

NOTES:

1. INSTALL RECEPTACLE IN EXISTING J-BOX.
2. INSTALL CLOCK HANGER OUTLET IN EXISTING J-BOX.

PROJECT NORTH

AS BUILT
DATE JAN 2 7 1977

STATE OF ALASKA — REGISTERED PROFESSIONAL ENGINEER — 5780 E

CH2M HILL — ALASKA

DES.	JJP
DR.	GEB/SDG
CHK.	JMY
APPD.	EAH

NO.	DATE	REVISION	BY	APPD.
1	12-14-76	AS BUILT		

POLICE FLOOR PLAN

ALTERNATIVE 'A'

CITY HALL FOR NOME, ALASKA

SHEET OF A-9
PROJ. NO. K9327.1
DATE 6 FEB '76
DWG. NO. C9327-1

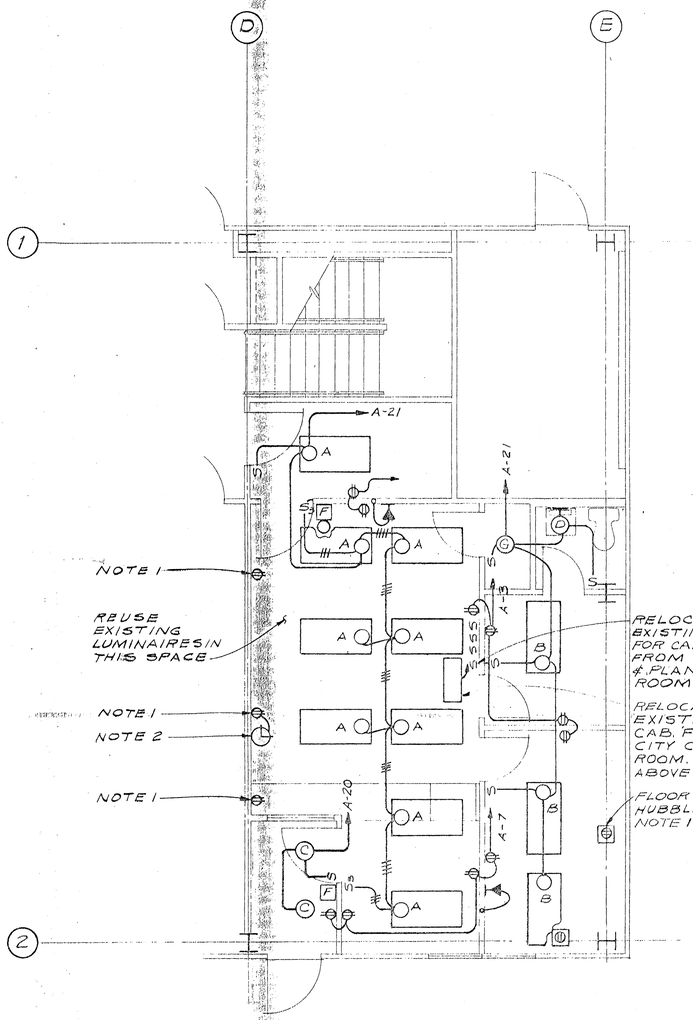

ELECTRICAL PLAN

1/4"=1'-0"

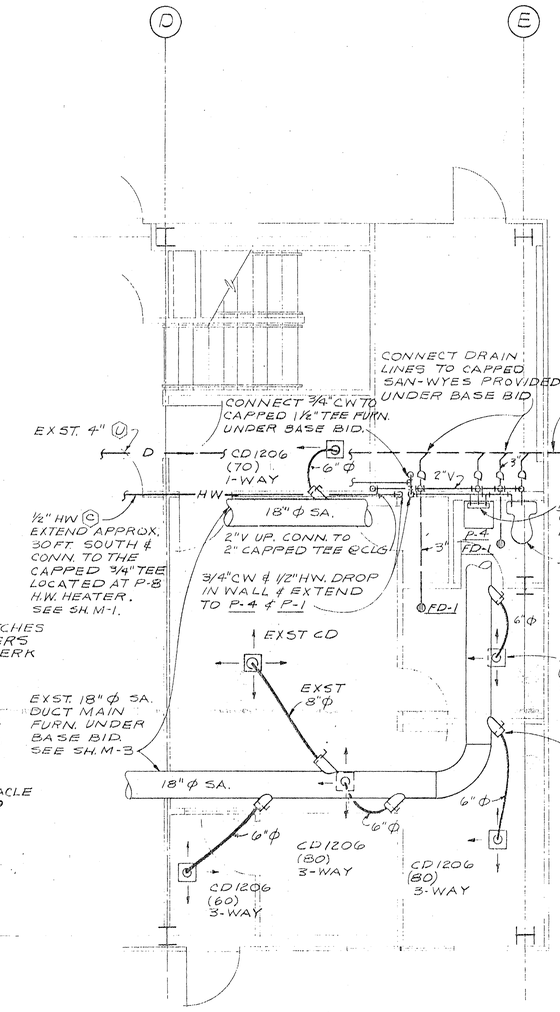

PLUMBING & HEATING PLAN

1/4"=1'-0"

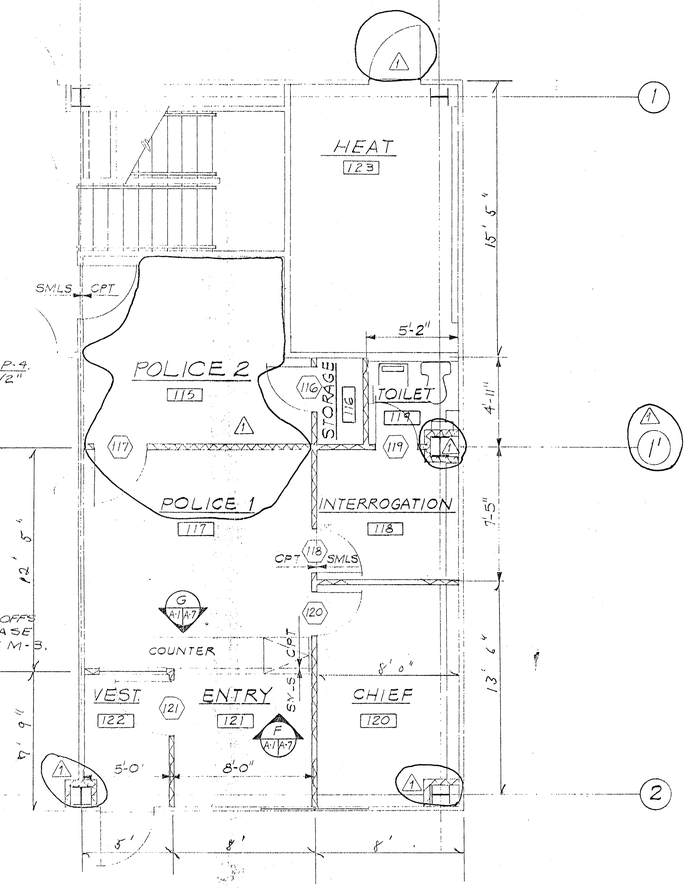

FLOOR PLAN

1/4"=1'-0"

NOTES:

1. INSTALL RECEPTACLE IN EXISTING J-BOX.
2. INSTALL CLOCK HANGER OUTLET IN EXISTING J-BOX.

PROJECT NORTH

AS BUILT
DATE JAN 27 1977

STATE OF ALASKA — REGISTERED PROFESSIONAL ENGINEER

CH2M HILL ALASKA

DES.	JJP
DR.	GEB/SDG
CHK.	JMY
APPD.	EAH

NO.	DATE	REVISION	BY	APPD.
1	12-14-76	AS BUILT	DH	

POLICE FLOOR PLAN

ALTERNATIVE "A"

CITY HALL FOR NOME, ALASKA

SHEET OF A-9
PROJ. NO. K9327.1
DATE 6 FEB '76
DWG. NO. C9327-1

8.23 ± INV. SEWER @ INTERSECTION OF FRONT ST. & BERING ST. WATER @ EL. 10.98 ±

EXISTING WOOD BUILDING

19.07 @BW · 19.35 · 20.55 · N 71° 29' E · 22.55 · 22.45

18.17 @BW · 18.73 TC.

⚠ FUTURE CONCRETE DRIVEWAY CURB CUT TO CITY OF NOME STANDARDS N.I.C.

UTILIDOR

FRONT STREET

EXISTING CONCRETE CURB, GUTTER, & SIDEWALK

GRADE TO 2" BELOW SIDEWALK

N 70° 37' W

18.92 · 20.00 · 18.95 · 5'-0" · 20.50 · 20.77 · 22.50 · 22.00 · 22.50

6" THICK GRAVEL SURFACE

SWALE

FILL PIPE

FUEL TANK ⚠ SEE (4) C1 No.1

22.0

MATCH EXIST. GRADE

B C1 S3

FOR CONN. SEE DETAIL G C1 S3

Ø P. POLE W/TRANSFORMER

CITY HALL BUILDING

FIRST FLOOR LINE EL. 23.0'

FUEL TANK VENT

⚠ UTILIDUCT 15"ø

3 C1 S3

41'-4"

CONC. WALKWAY

SWALE

S 70° 37' E

22.50 · 15'-0" · 83'-4" · 20.00 · 20.50 · 22.375 · 20.50 · 22.50 · 22.375 · 22.77 · 22.84 · 21.96

10'-6"

18.94 @BW · Ø P. POLE · 20.85 · S 19° 23' W 150' · 21.45 · 22.85 · 22.05

18.76 TC. · ⚠ FUTURE FLAGPOLE & BASE N.I.C. · 20.75 · FUTURE CONCRETE CURB, GUTTER, & SIDEWALK N.I.C. ⚠ · 21.95 Ø P. POLE

19.07 TOP RIM · C.B. · 20.95 · EXIST. DITCH LINE

9.21 ± INV. SEWER

Ø B.M. EL. 18.24' SPIKE IN NORTH SIDE OF POWER POLE 1'-0" ± ABOVE SIDEWALK

⚠ 30'-0"

19.36 · 17.97 · 23.05

⚠ 45'-0"

℄ DIVISION STREET

℄ EAST 1ST AVENUE

C.B.

PROJECT NORTH

MAGNETIC NORTH

AS BUILT
DATE JAN 2 7 1977

STATE OF ALASKA · 4914 · Edward A. North · 5780 C · Registered Professional Engineer

LEGEND

18.75 ⊕	EXISTING GRADE
20.50 ⊕	FINISHED GRADE
BM	BENCH MARK
TC	TOP OF CURB
G	GUTTER
BW	BACK OF WALK
FH	FIRE HYDRANT
EL.	ELEVATION
	CONC. WALKWAY (ALT. "D")
	GRAVEL SURFACE (ALT. "E")

NOTES:

1) DATUM FOR THIS PLAN IS BASED ON USC&G BRASS CAP #7 1969 IN BASE OF FLAG POLE SOUTH SIDE OF FRONT STREET AT FEDERAL WAY. ASSUMED ELEVATION 16.85'
2) UNDER ANOTHER CONTRACT EXISTING BUILDINGS, FOUNDATIONS & ON-SITE UTILITIES WILL BE REMOVED BUT NO GRADING WILL BE ACCOMPLISHED.
3) UNDERGROUND UTILITIES: KNOWN UTILITIES & STRUCTURES EXPECTED TO BE ADJACENT TO OR ENCOUNTERED IN THE WORK ARE SHOWN ON THE PLANS. IT IS EXPECTED THAT THERE MAY BE SOME DISCREPANCIES & OMISSIONS IN THE LOCATIONS & QUANTITIES OF UTILITIES & STRUCTURES SHOWN. THOSE SHOWN ARE FOR THE CONVENIENCE OF THE CONTRACTOR ONLY AND NO RESPONSIBILITY IS ASSUMED BY EITHER THE OWNER OR THE ENGINEER FOR THEIR ACCURACY OR COMPLETENESS.
4) ALTERNATIVE "E" INCLUDES ALL SITE AND UTILITY WORK FROM ⚠2 5'-0" OUTSIDE OF BUILDING PERIMETER, EXCEPT UTILIDUCT WHICH BEGINS AT FOUNDATION WALL.

CH2M HILL

DES.	JJP
DR.	PWS
CHK.	EAH
APPD.	EAH

NO.	DATE	REVISION	BY	APPD.
⚠2	12-10-76	AS BUILT	GEB	JJP
⚠1	2-6-76	ADD FUEL TANK.	JJP	EAH

SITE PLAN 1" = 10'

BASIC BID NO. 1 & ALTERNATIVES "D" & "E"

CITY HALL FOR NOME, ALASKA

SHEET OF 2 C-1
PROJ. NO. K9327.1
DATE 27 JUNE 75
DWG. NO. C9327-1

18.28 ± INV. SEWER @ INTERSECTION OF FRONT ST. & BERING ST. WATER @ EL. 10.98 ±

EXISTING WOOD BUILDING

19.07 TOP RIM

19.35

20.55

N 19° 23' E

22.55

22.45

18.17 @ BW

18.73 TC

FUTURE CONCRETE DRIVEWAY CURB CUT TO CITY OF NOME STANDARDS N.I.C.

19.02

6" THICK GRAVEL SURFACE

SWALE

MATCH EXIST. GRADE

UTILIDOR

FRONT STREET

EXISTING CONCRETE CURB, GUTTER, & SIDEWALK

17.90

20.77

22.50

22.50

22.50

FUEL TANK VENT

FUEL FILL PIPE

FUEL TANK #1 SEE CITY-1

20.00

20.50

18.95

N 70° 57' W

GRADE TO 2" BELOW SIDEWALK

5'-0"

CITY HALL BUILDING

FIRST FLOOR LINE EL. 23.0'

UTILIDUCT 15'-0"

22.0

B C1 | S3

FOR CONN. SEE DETAIL G C1 | S3

3 C1 | S3

41'-4"

EAST 1ST AVENUE

UTILIDOR

22.50

83'-4"

15'-0"

20.00

20.50

22.375

22.30

22.375

22.17

21.96

MATCH EXIST. GRADE

22.65

22.05

10'-6"

18.94 @ BW

Ø P. POLE

20.85

S 19° 23' W

150'

21.45

18.76 T.C.

FUTURE FLAGPOLE & BASE N.I.C.

20.75

FUTURE CONCRETE CURB, GUTTER, & SIDEWALK N.I.C.

Ø P POLE

19.07 TOP RIM

C.B.

20.95

21.95

EXIST. DITCH LINE

9.21 ± INV. SEWER

Ø P POLE W/TRANSFORMER

Ø B.M. EL. 18.24' SPIKE IN NORTH SIDE OF POWER POLE 1'-0" ± ABOVE SIDEWALK

30'-0"

19.36

17.97

23.05

℄ DIVISION STREET

45'-0"

C.B.

PROJECT NORTH

MAGNETIC NORTH

AS BUILT
DATE JAN 27 1977

STATE OF ALASKA 49TH
Edward A. Hill

LEGEND

18.75	EXISTING GRADE
20.50	FINISHED GRADE
BM.	BENCH MARK
TC	TOP OF CURB
G	GUTTER
BW	BACK OF WALK
FH	FIRE HYDRANT
EL.	ELEVATION
	CONC. WALKWAY (ALT. "D")
	GRAVEL SURFACE (ALT. "E")

NOTES:

1) DATUM FOR THIS PLAN IS BASED ON USC&G BRASS CAP #7 1969 IN BASE OF FLAG POLE SOUTH SIDE OF FRONT STREET AT FEDERAL WAY. ASSUMED ELEVATION 16.85'
2) UNDER ANOTHER CONTRACT EXISTING BUILDINGS, FOUNDATIONS, & ON-SITE UTILITIES WILL BE REMOVED BUT NO GRADING WILL BE ACCOMPLISHED.
3) UNDERGROUND UTILITIES; KNOWN UTILITIES & STRUCTURES EXPECTED TO BE ADJACENT TO OR ENCOUNTERED IN THE WORK, ARE SHOWN ON THE PLANS. IT IS EXPECTED THAT THERE MAY BE SOME DISCREPANCIES & OMISSIONS IN THE LOCATIONS & QUANTITIES OF UTILITIES & STRUCTURES SHOWN. THOSE SHOWN ARE FOR THE CONVENIENCE OF THE CONTRACTOR ONLY, AND NO RESPONSIBILITY IS ASSUMED BY EITHER THE OWNER OR THE ENGINEER FOR THEIR ACCURACY OR COMPLETENESS.
4) ALTERNATIVE "E" INCLUDES ALL SITE AND UTILITY WORK FROM Δ 8'-0" OUTSIDE OF BUILDING PERIMETER, EXCEPT UTILIDUCT WHICH BEGINS AT FOUNDATION WALL.

CH2M HILL ALASKA

DES.	J.J.P.
DR.	P.W.S.
CHK.	E.A.H.
APPD.	E.A.H.

NO.	DATE	REVISION	BY	APPD.
Δ	12-10-76	AS BUILT	GEB	JJP
Δ	2-6-76	ADD FUEL TANK	JJP	EAH

SITE PLAN 1" = 10'

BASIC BID NO. 1 & ALTERNATIVES "D" & "E"

CITY HALL FOR NOME, ALASKA

SHEET OF 2 C-1
PROJ. NO. K9327.1
DATE 27 JUNE 75
DWG. NO. C9327-1

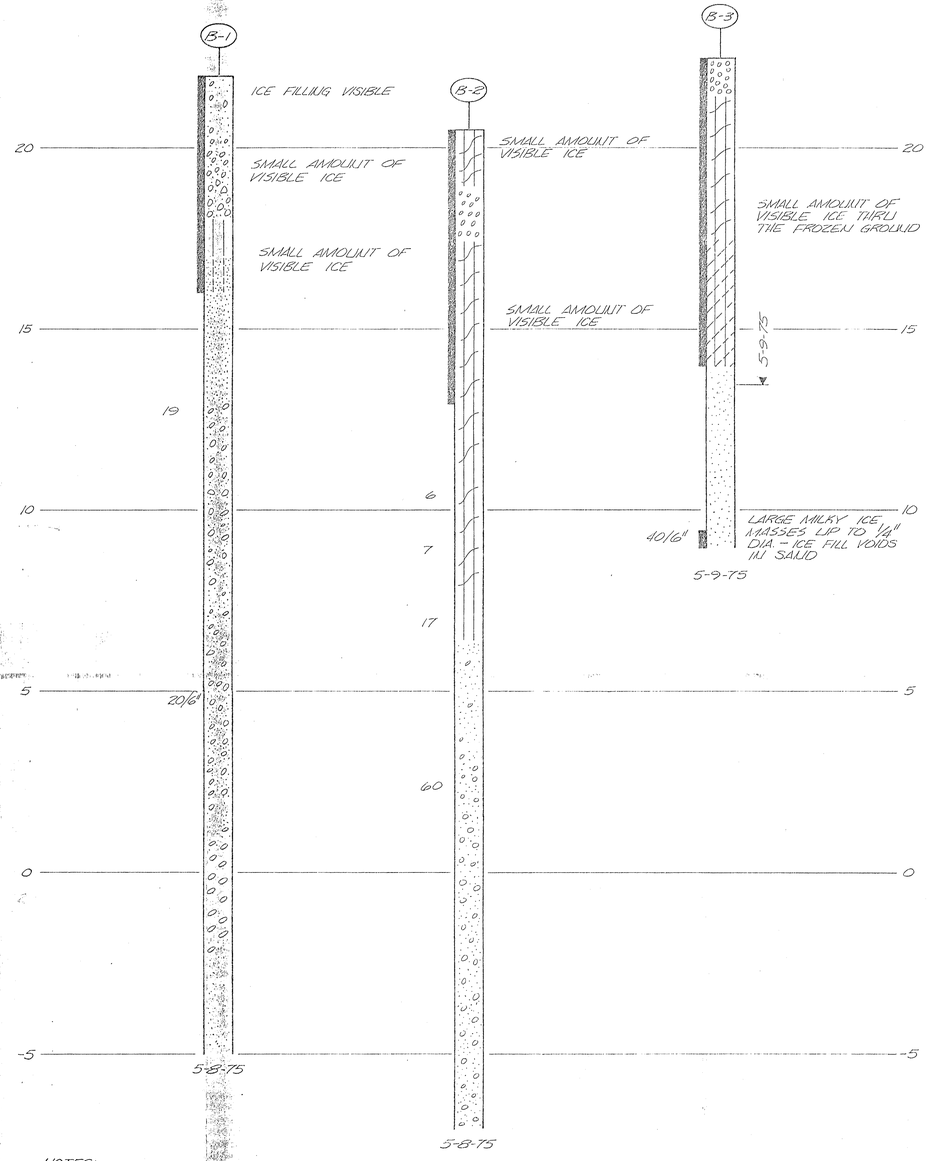

NOTES:
1. TESTS MADE WITH 1-2' OF SNOW ON GROUND.
2. ALL BORINGS MADE WITH A MOBILE DRILL, MODEL B-38 USING 6" DIA. CONTINUOUS FLIGHT AUGER.
3. GROUND WATER TABLE AUTICIPATED TO BE BETWEEN ELEVATION 5 & 2 IN BORING 1 & 2.

2' 1' 0 1' 2' 3' 4'
VERT. 1"=2'

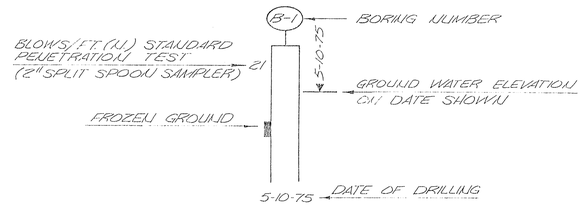

NOTE:
THIS LOG REPRESENTS ONLY THE OPINION OF THE GEOLOGIST AS TO THE CHARACTER OF MATERIALS ENCOUNTERED IN THE TEST HOLES. NO WARRANTY EXPRESSED OR IMPLIED IS GIVEN IN REGARD TO ANY VARIATIONS WHICH MAY OCCUR BETWEEN TEST HOLE SITES.

SAND | SILT | GRAVELLY CLAY | ORGANIC SILT
SILTY SAND | SANDY SILT | GRAVEL
GRAVELLY SAND | CLAYEY SILT | SANDY GRAVEL

STANDARD BORING LOG SYMBOLS AND LEGEND

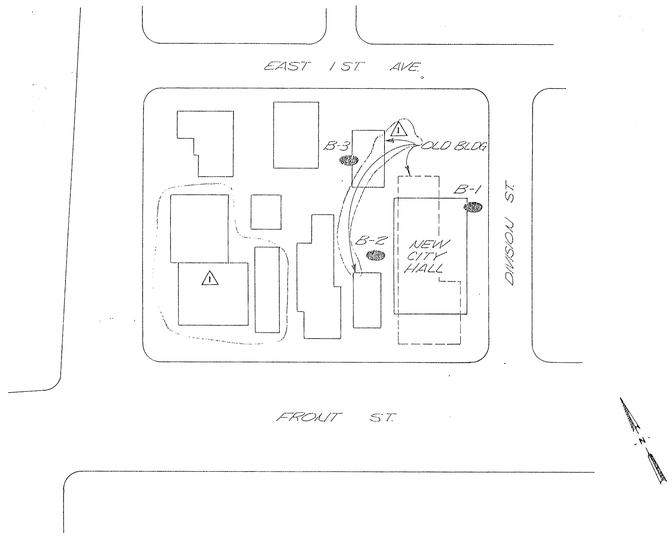

LOCATION MAP
N.T.S.

AS BUILT
DATE JAN 27 1977

CH2M HILL	DES. MKWR						
	DR. MTBP						
	CHK.						
	APPD.	NO.	DATE	REVISION	BY	APPD.	
		1	12-10-76	AS BUILT	GEB	JJP	

BORING LOGS

BASIC BID NO. 1

CITY HALL FOR NOME, ALASKA

SHEET C-2 OF 2
DATE 7 JULY 75
DWG. NO. C 9327-1

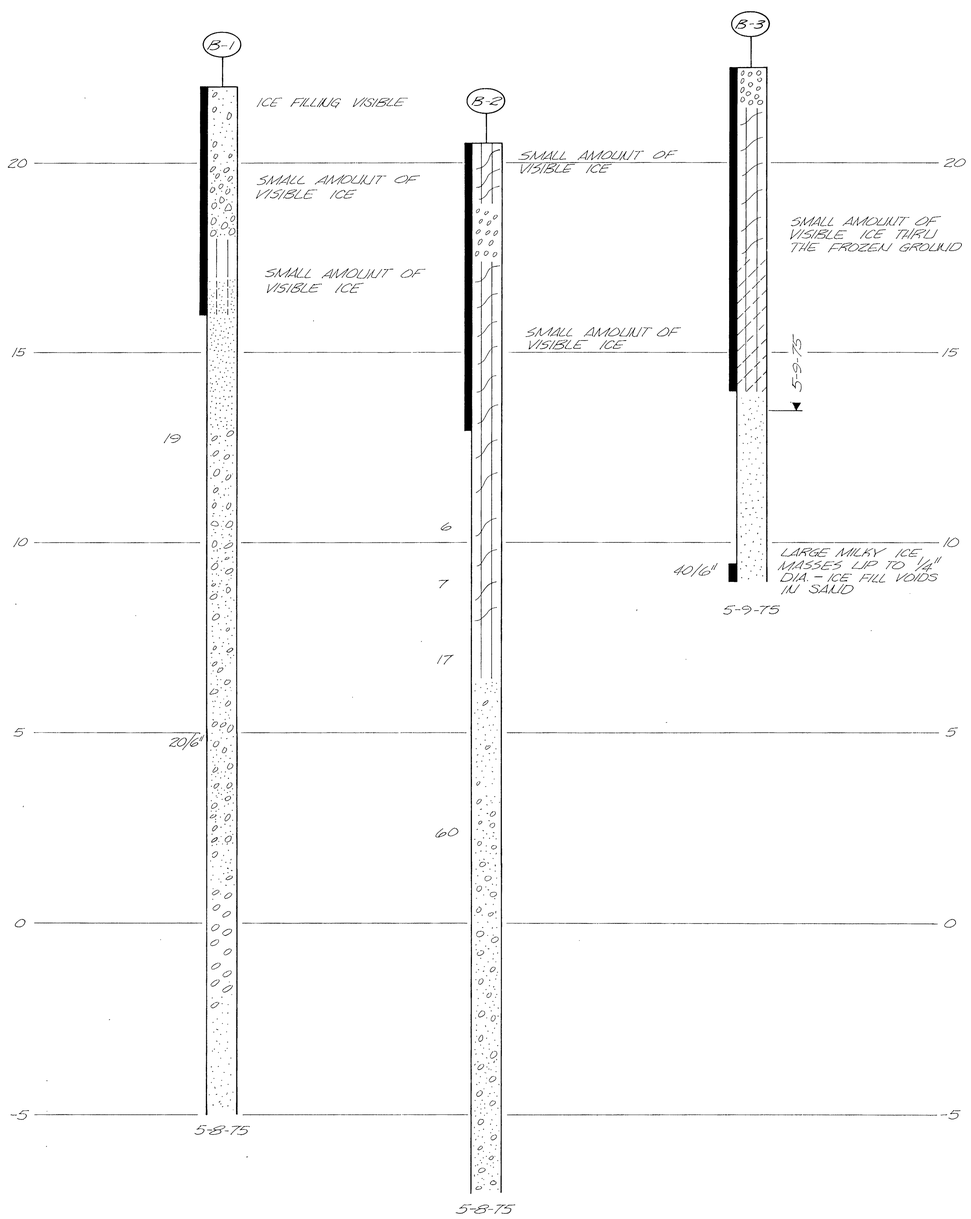

NOTES:
1. TESTS MADE WITH 1'-2' OF SNOW ON GROUND.
2. ALL BORINGS MADE WITH A MOBILE DRILL, MODEL B-38 USING 6" DIA. CONTINUOUS FLIGHT AUGER.
3. GROUND WATER TABLE ANTICIPATED TO BE BETWEEN ELEVATION 5 & 2 IN BORING 1 & 2.

2' 1' 0 1' 2' 3' 4'
VERT. 1"=2'

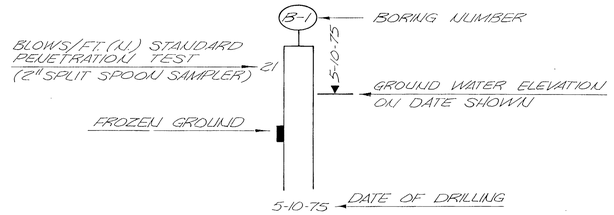

NOTE:
THIS LOG REPRESENTS ONLY THE OPINION OF THE GEOLOGIST AS TO THE CHARACTER OF MATERIALS ENCOUNTERED IN THE TEST HOLES. NO WARRANTY EXPRESSED OR IMPLIED IS GIVEN IN REGARD TO ANY VARIATIONS WHICH MAY OCCUR BETWEEN TEST HOLE SITES.

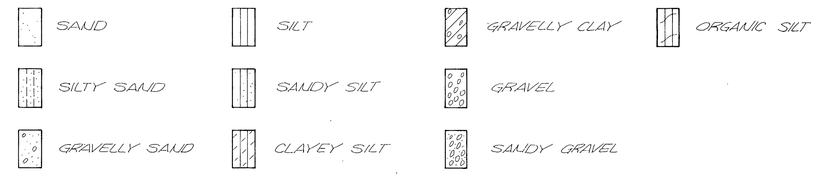

STANDARD BORING LOG SYMBOLS AND LEGEND

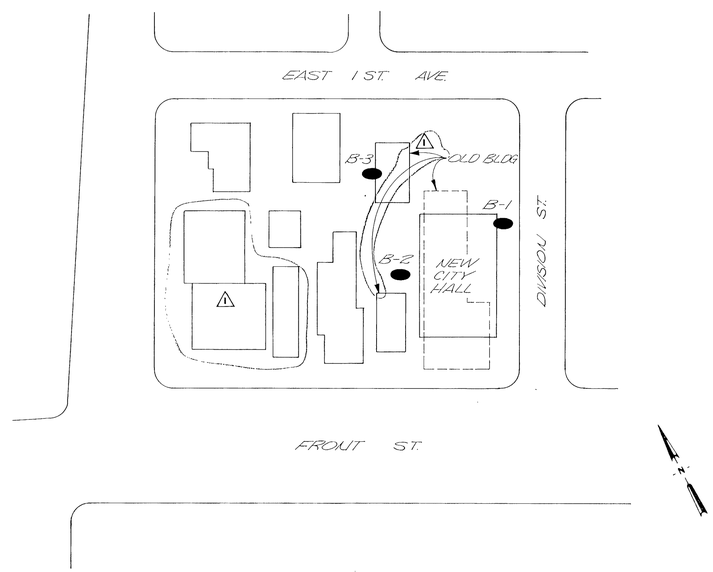

LOCATION MAP
N.T.S.

AS BUILT
DATE JAN 27 1977

CH2M HILL	DES. MKVR					
	DR. MTBP					
	CHK.					
	APPD.	⚠	12-10-76	AS BUILT	GEB	JJP
		NO.	DATE	REVISION	BY	APPD.

BORING LOGS

BASIC BID NO. 1

CITY HALL FOR NOME, ALASKA

SHEET C-2
OF 2
DATE 7 JULY 75
DWG. NO. C9327-1

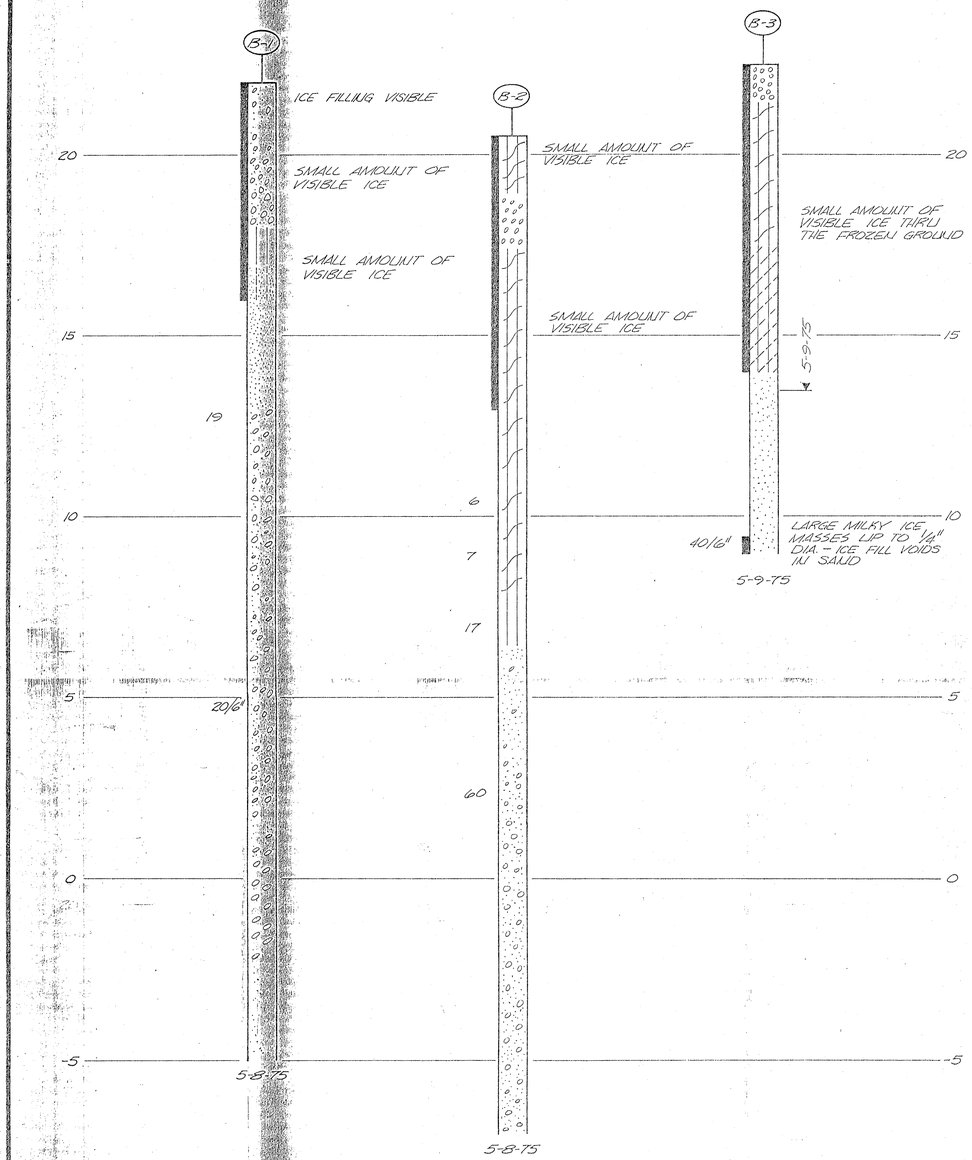

NOTES:
1. TESTS MADE WITH 1'-2' OF SNOW ON GROUND.
2. ALL BORINGS MADE WITH A MOBILE DRILL MODEL B-38 USING 6" DIA. CONTINUOUS FLIGHT AUGER.
3. GROUND WATER TABLE ANTICIPATED TO BE BETWEEN ELEVATION 5 & 2 IN BORING 1 & 2.

2' 1' 0 1' 2' 3' 4'
VERT. 1"=2'

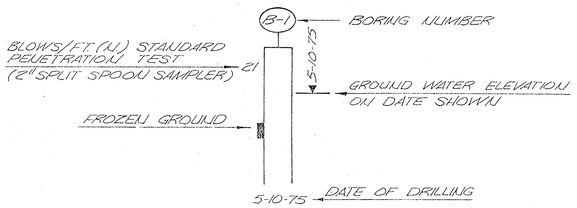

NOTE:
THIS LOG REPRESENTS ONLY THE OPINION OF THE GEOLOGIST AS TO THE CHARACTER OF MATERIALS ENCOUNTERED IN THE TEST HOLES. NO WARRANTY EXPRESSED OR IMPLIED IS GIVEN IN REGARD TO ANY VARIATIONS WHICH MAY OCCUR BETWEEN TEST HOLE SITES.

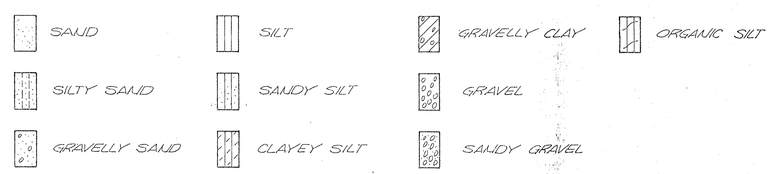

STANDARD BORING LOG SYMBOLS AND LEGEND

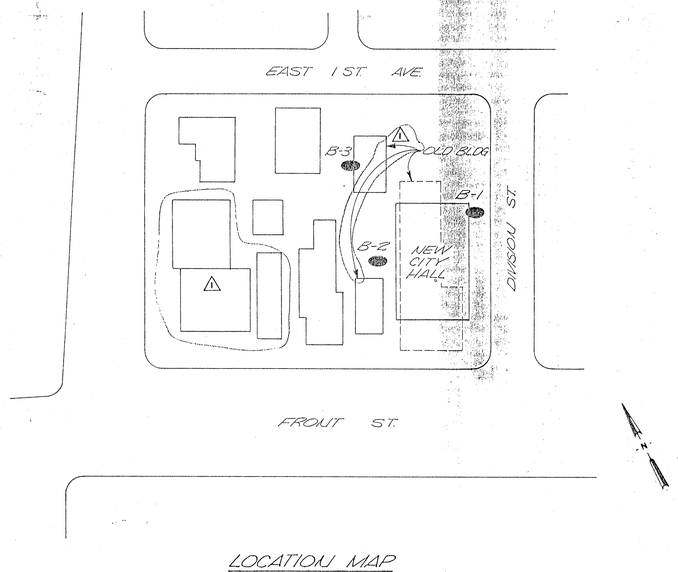

LOCATION MAP
N.T.S.

AS BUILT
DATE JAN 27 1977

CH2M HILL	DES. MKWR					
	DR. MTBP					
	CHK.					
	APPD.					
		NO.	DATE	REVISION	BY	APPD.
		1	12-10-76	AS BUILT	GEB	JJP

BORING LOGS

BASIC BID NO. 1

CITY HALL FOR NOME, ALASKA

SHEET C-2 OF 2
DATE 7 JULY 75
DWG. NO. C 9327-1

CITY HALL for NOME, ALASKA

AND

REPAIR BOWLING ALLEY BUILDING

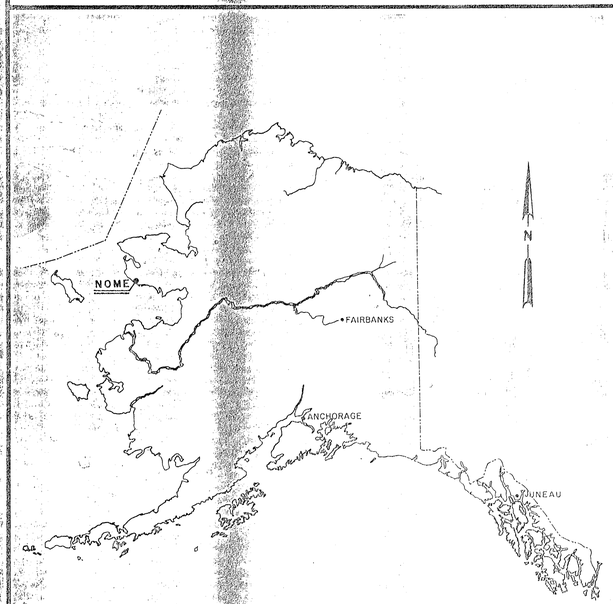

MAP OF ALASKA

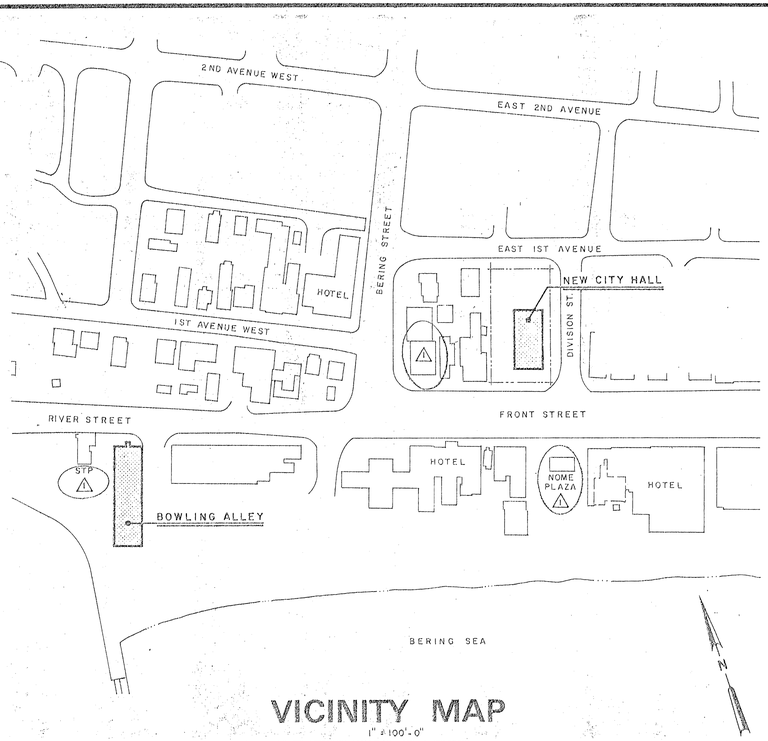

VICINITY MAP

1" = 100'-0"

INDEX TO DRAWINGS

ALASKA

CITY HALL, BASIC BID NO. 1

CIVIL

C-1 SITE PLAN
C-2 SOIL BORING LOGS

STRUCTURAL

S-1 FOUNDATION PLAN
S-2 FOUNDATION DETAILS
S-3 FOUNDATION DETAILS

ARCHITECTURAL

A-1 FIRST FLOOR PLAN
A-1a FIRST FLOOR REFLECTED CEILING PLAN
A-2 SECOND FLOOR PLAN
A-2a SECOND FLOOR REFLECTED CEILING PLAN
A-3 ELEVATIONS AND SECTION
A-4 STAIR AND WALL SECTIONS AND DETAILS
A-5 ROOM FINISH SCHEDULE
A-6 DOOR AND FRAME SCHEDULE AND DETAILS
A-7 INTERIOR ELEVATIONS AND DETAILS
A-8 ENTRANCE PORCH PLAN AND DETAILS
A-9 POLICE FLOOR PLAN

MECHANICAL

M-1 FIRST FLOOR PLUMBING PLAN
M-2 SECOND FLOOR PLUMBING PLAN
M-3 FIRST FLOOR HEATING AND VENTILATING
M-4 SECOND FLOOR HEATING AND VENTILATING
M-5 FIRST FLOOR PIPING PLAN AND ELEVATIONS
M-6 SECOND FLOOR PIPING PLAN
M-7 DETAILS AND SECTIONS
M-8 DETAILS AND SECTIONS

ELECTRICAL

E-1 SCHEDULES AND DIAGRAMS
E-2 FIRST FLOOR POWER PLAN
E-3 FIRST FLOOR LIGHTING PLAN
E-4 SECOND FLOOR POWER PLAN
E-5 SECOND FLOOR LIGHTING PLAN
E-6 DETAILS

REPAIR BOWLING ALLEY, BASIC BID NO. 2

ARCHITECTURAL

A-10 FLOOR PLAN AND ELEVATIONS
A-11 PARTIAL FLOOR PLANS
A-12 ROOM FINISH SCHEDULE AND DOOR SCHEDULE
A-13 MISCELLANEOUS DETAILS

MECHANICAL

M-9 FLOOR PLAN - MECHANICAL
M-10 PARTIAL FLOOR PLAN

ELECTRICAL

E-7 LIGHTING AND POWER PLANS
E-8 PARTIAL PLAN - ELECTRICAL
E-9 MISCELLANEOUS ELECTRICAL DETAILS

AS BUILT
DATE JAN 27 1977

△ AS BUILT 12-10-76

CITY HALL

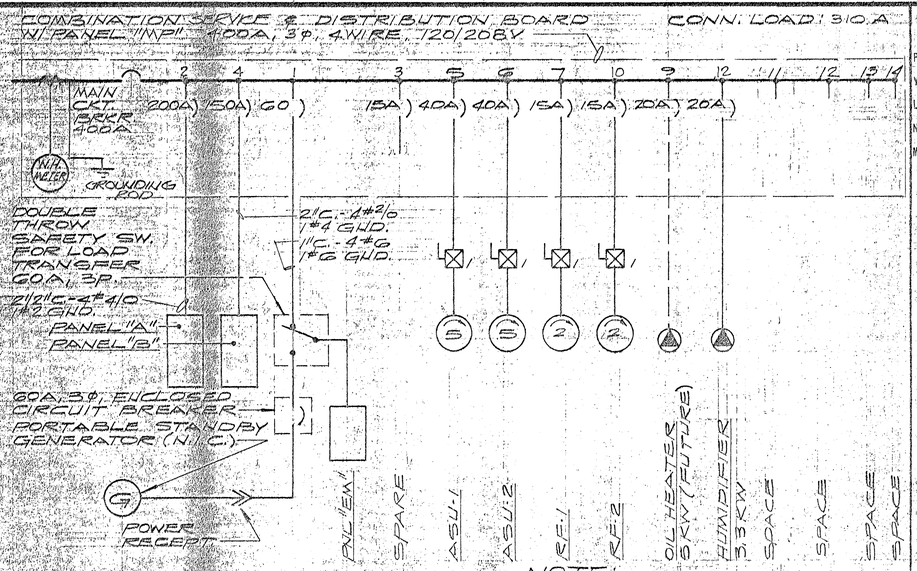

ONE LINE DIAGRAM

N.T.S.

NOTE: SEE SHT. E-6 FOR ELEVATION OF COMBINATION SERVICE & DISTRIBUTION BOARD.

PANEL: "B"
VOLTAGE: 120/208
LOAD: 100A
NEUTRAL: FULL
MOUNTING: SURFACE

LOCATION: MECHANICAL ROOM SECOND FLOOR
PHASE: 3 WIRE: 4
MAINS SIZE: 225A TYPE: NQO
FEEDER SIZE: 3#2/0 TOP/BOT: BOTTOM

LOAD - WATTS A	B	C	CIRCUIT DESCRIPTION	BRKR. AMP/ POLE	BRKR. NO.		BRKR. AMP/ POLE	CIRCUIT DESCRIPTION	LOAD - WATTS A	B	C
800			RECEPT - RM 212, 213	20/1	1	2	20/1	RECEPT - PUB WKS FLR	1000		
	400		RECEPT - NORTH END FLR	20/1	3	4	20/1	RECEPT, EXIT LIGHTS		1200	
		1000	RECEPT - WEST WALL FLR	20/1	5	6	20/1	RECEPT (GFI CKT. BRKR.)			400
800			RECEPT - RM 211,121	20/1	7	8	20/1	RECEPT - RM 202	1200		
	800		RECEPT - RM 214	20/1	9	10	20/1	RECEPT - EAST WALL FLR		600	
		800	RECEPT, CLOCK	20/1	11	12	20/1	RECEPT - RM 203, 205			1200
			SPARE	20/1	13	14	20/1	SPARE			
	700		LIGHTING - NORTH END	20/1	15	16	20/1	LIGHTING - SW CORNER		1200	
		1600	LIGHTING - NE CORNER	20/1	17	18	20/1	LIGHTING - SE CORNER			1000
1400			LIGHTING - PUBLIC WORKS	20/1	19	20	20/1	LIGHTING - RM 203	1500		
	1000		LIGHTING - BATHROOMS	20/1	21	22	20/1	LIGHTING - (LEAVE ON)		500	
			SPARE	20/1	23	24	20/1	FLR RECEPT - SOUTH WALL			1000
3960			XEROX MACHINE	30/2	25	26	20/1	COMM.CTR.-PUBLIC WORKS	1080		
	3960		-		-	28	20/1	EXHAUST FAN 1/3 HP		864	
		2700	SPARE	20/1	27	30	20/1	CONTROLS - ASU'S			
			RECEPT - RM 203, 205	20/1	29	32		SPACE			
			SPARE		31	34		SPACE			
			SPACE		35	36		SPACE			
			SPACE		37	38		SPACE			
			SPACE		39	40		SPACE			
			SPARE	20/1	41	42		SPACE			
6960	6960	6100							4,700	4,364	3,600

PANEL: "A"
VOLTAGE: 120/208
LOAD: 128A
NEUTRAL: FULL
MOUNTING: SURFACE

LOCATION: BOILER ROOM - FIRST FLOOR
PHASE: 3 WIRE: 4
MAINS SIZE: 225A TYPE: NQO
FEEDER SIZE: 3#4/0 TOP/BOT: TOP

LOAD - WATTS A	B	C	CIRCUIT DESCRIPTION	BRKR. AMP/ POLE	BRKR. NO.		BRKR. AMP/ POLE	CIRCUIT DESCRIPTION	LOAD-WATTS A	B	C
6000			RANGE	50/2	1	2	30/2	H.W. HEATER	2255		
	6000									2255	
		800	RECEPT-POLICE INT.RM	20/1	3	4	20/1	RECEPT-STOR.RM & TIME CLK			1000
800			RECEPT-POLICE RM	20/1	5	6	20/1	RECEPT-LOBBY	1000		
	1000		RECEPT-POLICE CHIEF	20/1	7	8	20/1	RECEPT-TEL RM		1000	
		1700	EXIT LIGHT-COUNCIL CHAMB	20/1	9	10	20/1	FLR RECEPT-COUNDIL CHAMB			1000
1000			REFRIGERATOR	20/1	11	12		-			
	1000		RECEPT-KITCHEN	20/1	13	14	20/1	FLR RECEPT-POLICE RM		1000	
			GFI BRKR			16	20/1	RECEPT-BOILER RM			800
			SPACE	20/1	15	18		SPACE			
1000			RECEPT-CITY CLERK	20/1	17	20	20/1	LIGHTING-NORTH ENTRANCE		600	
	1100		DISPOSAL	20/1	19	22	20/1	LIGHTING-KITCHEN, CORRIDOR			1300
		1400	LIGHTING-POLICE DEPT	20/1	21	24	20/1	LIGHTING-COUNCIL CHAMB	1600		
1700			LIGHTING-CITY CLERK	20/1	23	26	20/1	RECEPT-BATHROOMS		600	
	1200		LIGHTING-EXTERIOR	20/1	25			GFI BRKR			
		200	CUH-1	20/1	27	28	20/1	RECEPT-RANGE HOOD			500
1500			RECEPT-AUTO ENG HTR	20/1	29	30	20/1	RECEPT-AUTO ENG HTR	1500		
			GFI BRKR					GFI BRKR			
	1500		RECEPT-AUTO ENG HTR	20/1	31	32	20/1	RECEPT-AUTO ENG HTR		1500	
			GFI BRKR					GFI BRKR			
			SPARE	20/1	33	34		SPACE			
			SPACE		35	36		SPACE			
			SPACE		37	38		SPACE			
			SPACE		39	40		SPACE			
12,000	11,800	3,100							6,355	6,955	4,600

PANEL: "EM"
VOLTAGE: 120/208V
LOAD: 50A
NEUTRAL: FULL
MOUNTING: SURFACE

LOCATION: BOILER ROOM FIRST FLOOR
PHASE: 3 WIRE: 4
MAINS SIZE: 100A TYPE: NQO
FEEDER SIZE: 3#6 TOP/BOT: TOP

LOAD - WATTS A	B	C	CIRCUIT DESCRIPTION	BRKR. AMP/ POLE	BRKR. NO.		BRKR. AMP/ POLE	CIRCUIT DESCRIPTION	LOAD - WATTS A	B	C
			SPARE	20/3	1	2	15/3	UNIT HEATER	1000		
			-					-		1000	
			-					-			1000
498			CIRC. PUMP NO. 2	15/3	3	4	15/3	CIRC. PUMP NO. 3	498		
	498		-							498	
		498	-								498
1840			CIRC. PUMP NO. 1	30/1	5	6	20/1	BOILER RM. LIGHTS	600		
	1000		FIRE ALARM PANEL	20/1	7	8	20/1	ZONE VALVE, 1st FLR			
			ZONE VALVE, 2nd FLR	20/1	9	10	20/1	BOILER FEED NO. 1		864	
			ZONE VALVE, 1st FLR	20/1	11	12	20/1	BOILER FEED NO. 2	864		
			SPACE		13	14		SPACE			
			SPACE		15	16		SPACE			

ELECTRICAL SYMBOL LEGEND

- S — WALL SWITCH
- S_3 — WALL SWITCH - THREE WAY
- S_M — MANUAL MOTOR STARTER SWITCH
- S_K — KEYED SWITCH
- EXIT LIGHT - SEE SCHEDULE
- LUMINAIRE - SEE SCHEDULE
- WALL MOUNTED LUMINAIRE - SEE SCHEDULE
- LUMINAIRE - SEE SCHEDULE
- CLOCK HANGER OUTLET AND RECEPTACLE
- CONVENIENCE RECEPTACLE - DUPLEX UNLESS OTHERWISE SPECIFIED
- 30 — RECEPTACLE - 208V 1φ, AMPERAGE INDICATED
- DUPLEX CONVENIENCE RECEPTACLE FLUSH IN FLOOR
- 30 — RECEPTACLE, SPECIAL PURPOSE - AMPERAGE IS INDICATED
- CONNECTION POINT TO EQUIPMENT SPECIFIED. FURNISHED AND INSTALLED UNDER OTHER SPECIFICATION SECTIONS AND CONNECTED UNDER THIS SECTION
- TELEPHONE RECEPTACLE (OUTLET BOX ONLY) FLUSH IN WALL
- TELEPHONE RECEPTACLE (OUTLET BOX ONLY) FLUSH IN FLOOR
- STARTER MAGNETIC WITH MAG ONLY CIRCUIT BREAKER NEMA SIZE INDICATED, NEMA 1 ENCLOSURE
- STARTER MAGNETIC NEMA SIZE INDICATED, NEMA 1 ENCLOSURE UNLESS OTHERWISE INDICATED
- 5 — MOTOR, SQUIRREL CAGE INDUCTION - HORSEPOWER INDICATED
- UH-1 — UNIT HEATER NO. 1
- B-16 — HOME RUN DESTINATION SHOWN
- CONCEALED CONDUIT AND CONDUCTORS. "G" INDICATES GROUND WIRE.
- 3G — CONDUIT BELOW GRADE AND CONDUCTORS
- CONDUIT, DOWN
- CONDUIT, UP
- METERING FACILITIES
- 400 — CIRCUIT BREAKER, THERMAL MAGNETIC TRIP, FRAME SIZE SHOWN, 3 POLE UNLESS OTHERWISE INDICATED
- GROUND
- BRANCH CIRCUIT PANEL
- F — FIRE ALARM STATION MANUAL
- FA — FIRE ALARM STATION AUTOMATIC HEAT DETECTOR
- F — FIRE ALARM BELL
- I — AIR DUCT IONIZATION DETECTOR
- P.B. PUSH BUTTON

AS BUILT
DATE JAN 27 1977

CH2M HILL ALASKA
DES. LLR.
DR. LAF.
CHK. RWB.
APPD. ALH.

NO.	DATE	REVISION	BY	APPD.

ONE LINE DIA., PNL SCHEDULES
ELEC SYMBOL LEGEND N.T.S.

BASIC BID NO. 1

CITY HALL FOR
NOME, ALASKA

SHEET E-1 OF
PROJ. NO. K9327.1
DATE 6 FEB. 76
DWG. NO. C9327-1

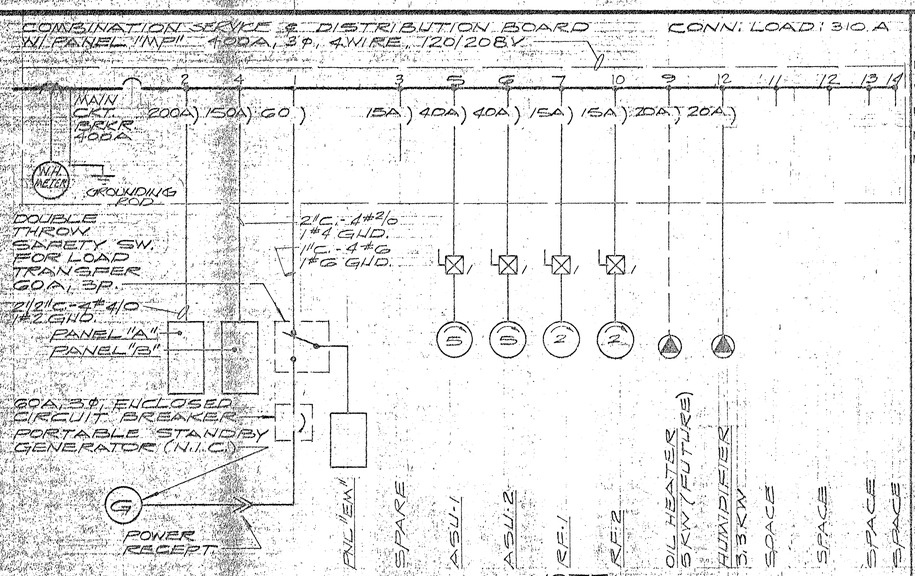

ONE LINE DIAGRAM

N.T.S.

NOTE: SEE SHT. E-6 FOR ELEVATION OF COMBINATION SERVICE & DISTRIBUTION BOARD.

PANEL: "B" — LOCATION: MECHANICAL ROOM SECOND FLOOR
VOLTAGE: 120/208 — PHASE: 3 — WIRE: 4
LOAD: 100A — MAINS SIZE: 225A — TYPE: NQO
NEUTRAL: FULL — FEEDER SIZE: 3#2/0 — TOP/BOT: BOTTOM
MOUNTING: SURFACE

LOAD - WATTS A	B	C	CIRCUIT DESCRIPTION	BRKR. AMP/ POLE	BRKR. NO.		BRKR. AMP/ POLE	CIRCUIT DESCRIPTION	LOAD - WATTS A	B	C
900			RECEPT - RM 212, 213	20/1	1	2	20/1	RECEPT - PUB WKS FLR	1000		
	400		RECEPT - NORTH END FLR	20/1	3	4	20/1	RECEPT, EXIT LIGHTS		1200	
		1000	RECEPT - WEST WALL FLR	20/1	5	6	20/1	RECEPT (GFI CKT. BRKR.)			400
800			RECEPT - RM 211,121	20/1	7	8	20/1	RECEPT - RM 202	1200		
	800		RECEPT - RM 214	20/1	9	10	20/1	RECEPT - EAST WALL FLR		600	
		800	RECEPT, CLOCK	20/1	11	12	20/1	RECEPT - RM 203, 205			1200
			SPARE	20/1	13	14	20/1	SPARE			
	700		LIGHTING - NORTH END	20/1	15	16	20/1	LIGHTING - SW CORNER		1200	
		1600	LIGHTING - NE CORNER	20/1	17	18	20/1	LIGHTING - SE CORNER			1000
1400			LIGHTING - PUBLIC WORKS	20/1	19	20	20/1	LIGHTING - RM 203	1500		
	1000		LIGHTING - BATHROOMS	20/1	21	22	20/1	LIGHTING - (LEAVE ON)		500	
			SPARE	20/1	23	24	20/1	FLR RECEPT - SOUTH WALL			1000
3960			XEROX MACHINE	30/2	25	26	20/1	COMM. CTR. - PUBLIC WORKS	1080		
	3060		-	-		28	20/1	EXHAUST FAN 1/3 HP		864	
		2700	SPARE	20/1	27	30	20/1	CONTROLS - ASU'S			-
			RECEPT - RM 203, 205	20/1	29	32		SPACE			
			SPARE		31	34		SPACE			
			SPACE		35	36		SPACE			
			SPACE		37	38		SPACE			
			SPACE		39	40		SPACE			
			SPARE	20/1	41	42		SPACE			
6960	6960	6100							4,780	4,364	3,600

PANEL: "A" — LOCATION: BOILER ROOM - FIRST FLOOR
VOLTAGE: 120/208 — PHASE: 3 — WIRE: 4
LOAD: 128A — MAINS SIZE: 225A — TYPE: NQO
NEUTRAL: FULL — FEEDER SIZE: 3#4/0 — TOP/BOT: TOP
MOUNTING: SURFACE

LOAD - WATTS A	B	C	CIRCUIT DESCRIPTION	BRKR. AMP/ POLE	BRKR. NO.		BRKR. AMP/ POLE	CIRCUIT DESCRIPTION	LOAD-WATTS A	B	C
6000			RANGE	50/2	1	2	30/2	H.W. HEATER	2255		
	6000									2255	
		800	RECEPT-POLICE INT. RM	20/1	3	4	20/1	RECEPT-STOR. RM & TIME CLK			1000
800			RECEPT-POLICE RM	20/1	5	6	20/1	RECEPT-LOBBY	1000		
	1000		RECEPT-POLICE CHIEF	20/1	7	8	20/1	RECEPT-TEL RM		1000	
		700	EXIT LIGHT-COUNCIL CHAMB	20/1	9	10	20/1	FLR RECEPT-COUNDIL CHAMB			1000
1000			REFRIGERATOR	20/1	11	12					
	1000		RECEPT-KITCHEN	20/1	13	14	20/1	FLR RECEPT-POLICE RM		1000	
			GFI BRKR			16	20/1	RECEPT-BOILER RM			800
			SPACE	20/1	15	18		SPACE			
1000			RECEPT-CITY CLERK	20/1	17	20	20/1	LIGHTING-NORTH ENTRANCE		600	
	1100		DISPOSAL	20/1	19	22	20/1	LIGHTING-KITCHEN, CORRIDOR			1300
		1400	LIGHTING-POLICE DEPT	20/1	21	24	20/1	LIGHTING-COUNCIL CHAMB	1600		
1700			LIGHTING-CITY CLERK	20/1	23	26	20/1	RECEPT-BATHROOMS		600	
	1200		LIGHTING-EXTERIOR	20/1	25			GFI BRKR			
		200	CUH-1	20/1	27	28	20/1	RECEPT-RANGE HOOD			500
1500			RECEPT-AUTO ENG HTR GFI BRKR	20/1	29	30	20/1	RECEPT-AUTO ENG HTR GFI BRKR	1500		
	1500		RECEPT-AUTO ENG HTR GFI BRKR	20/1	31	32	20/1	RECEPT-AUTO ENG HTR GFI BRKR		1500	
			SPARE	20/1	33	34		SPACE			
			SPACE		35	36		SPACE			
			SPACE		37	38		SPACE			
			SPACE		39	40		SPACE			
12,000	11,800	3,100							6,355	6,955	4,600

PANEL: "EM" — LOCATION: BOILER ROOM FIRST FLOOR
VOLTAGE: 120/208V — PHASE: 3 — WIRE: 4
LOAD: 50A — MAINS SIZE: 100A — TYPE: NQO
NEUTRAL: FULL — FEEDER SIZE: 3/6 — TOP/BOT: TOP
MOUNTING: SURFACE

LOAD - WATTS A	B	C	CIRCUIT DESCRIPTION	BRKR. AMP/ POLE	BRKR. NO.		BRKR. AMP/ POLE	CIRCUIT DESCRIPTION	LOAD - WATTS A	B	C
			SPARE	20/3	1	2	15/3	UNIT HEATER	1000		
			-					-		1000	
			-					-			1000
498			CIRC. PUMP NO. 2	15/3	3	4	15/3	CIRC. PUMP NO. 3	498		
	498		-							498	
		498	-								498
1840			CIRC. PUMP NO. 1	30/1	5	6	20/1	BOILER RM LIGHTS	600		
	1000		FIRE ALARM PANEL	20/1	7	8	20/1	ZONE VALVE, 1st FLR			
			ZONE VALVE, 2nd FLR	20/1	9	10	20/1	BOILER FEED NO. 1			864
			ZONE VALVE, 1st FLR	20/1	11	12	20/1	BOILER FEED NO. 2	864		
			SPACE		13	14		SPACE			
			SPACE		15	16		SPACE			

ELECTRICAL SYMBOL LEGEND

- S — WALL SWITCH
- S_3 — WALL SWITCH - THREE WAY
- S_M — MANUAL MOTOR STARTER SWITCH
- S_K — KEYED SWITCH
- EXIT LIGHT - SEE SCHEDULE
- (1) — LUMINAIRE - SEE SCHEDULE
- (2)H — WALL MOUNTED LUMINAIRE - SEE SCHEDULE
- (3) — LUMINAIRE - SEE SCHEDULE
- CLOCK HANGER OUTLET AND RECEPTACLE
- CONVENIENCE RECEPTACLE - DUPLEX UNLESS OTHERWISE SPECIFIED
- 30 — RECEPTACLE - 208V 1Φ, AMPERAGE INDICATED
- DUPLEX CONVENIENCE RECEPTACLE FLUSH IN FLOOR
- 30A — RECEPTACLE, SPECIAL PURPOSE - AMPERAGE IS INDICATED
- A — CONNECTION POINT TO EQUIPMENT SPECIFIED. FURNISHED AND INSTALLED UNDER OTHER SPECIFICATION SECTIONS AND CONNECTED UNDER THIS SECTION
- TELEPHONE RECEPTACLE (OUTLET BOX ONLY) FLUSH IN WALL
- TELEPHONE RECEPTACLE (OUTLET BOX ONLY) FLUSH IN FLOOR
- STARTER MAGNETIC WITH MAG ONLY CIRCUIT BREAKER NEMA SIZE INDICATED, NEMA 1 ENCLOSURE
- STARTER MAGNETIC NEMA SIZE INDICATED, NEMA 1 ENCLOSURE UNLESS OTHERWISE INDICATED
- (5) — MOTOR, SQUIRREL CAGE INDUCTION - HORSEPOWER INDICATED
- UH-1 — UNIT HEATER NO. 1
- B-16 — HOME RUN DESTINATION SHOWN
- CONCEALED CONDUIT AND CONDUCTORS. "G" INDICATES GROUND WIRE.
- 3/4"G — CONDUIT BELOW GRADE AND CONDUCTORS
- CONDUIT, DOWN
- CONDUIT, UP
- METERING FACILITIES
- 400 — CIRCUIT BREAKER, THERMAL MAGNETIC TRIP, FRAME SIZE SHOWN, 3 POLE UNLESS OTHERWISE INDICATED
- GROUND
- BRANCH CIRCUIT PANEL
- F — FIRE ALARM STATION MANUAL
- FA — FIRE ALARM STATION AUTOMATIC HEAT DETECTOR
- F — FIRE ALARM BELL
- I — AIR DUCT IONIZATION DETECTOR
- P.B. — PUSH BUTTON

AS BUILT
DATE JAN 27 1977

CH2M HILL
DES. KLR.
DR. LAF.
CHK. RWB.
APPD. ALH.

NO.	DATE	REVISION	BY	APPD.

ONE LINE DIA., PNL. SCHEDULES
ELEC. SYMBOL LEGEND N.T.S.

BASIC BID NO. 1

CITY HALL FOR NOME, ALASKA

SHEET OF E-1
PROJ. NO. K 9327.1
DATE 6 FEB 76
DWG. NO. C9327-1

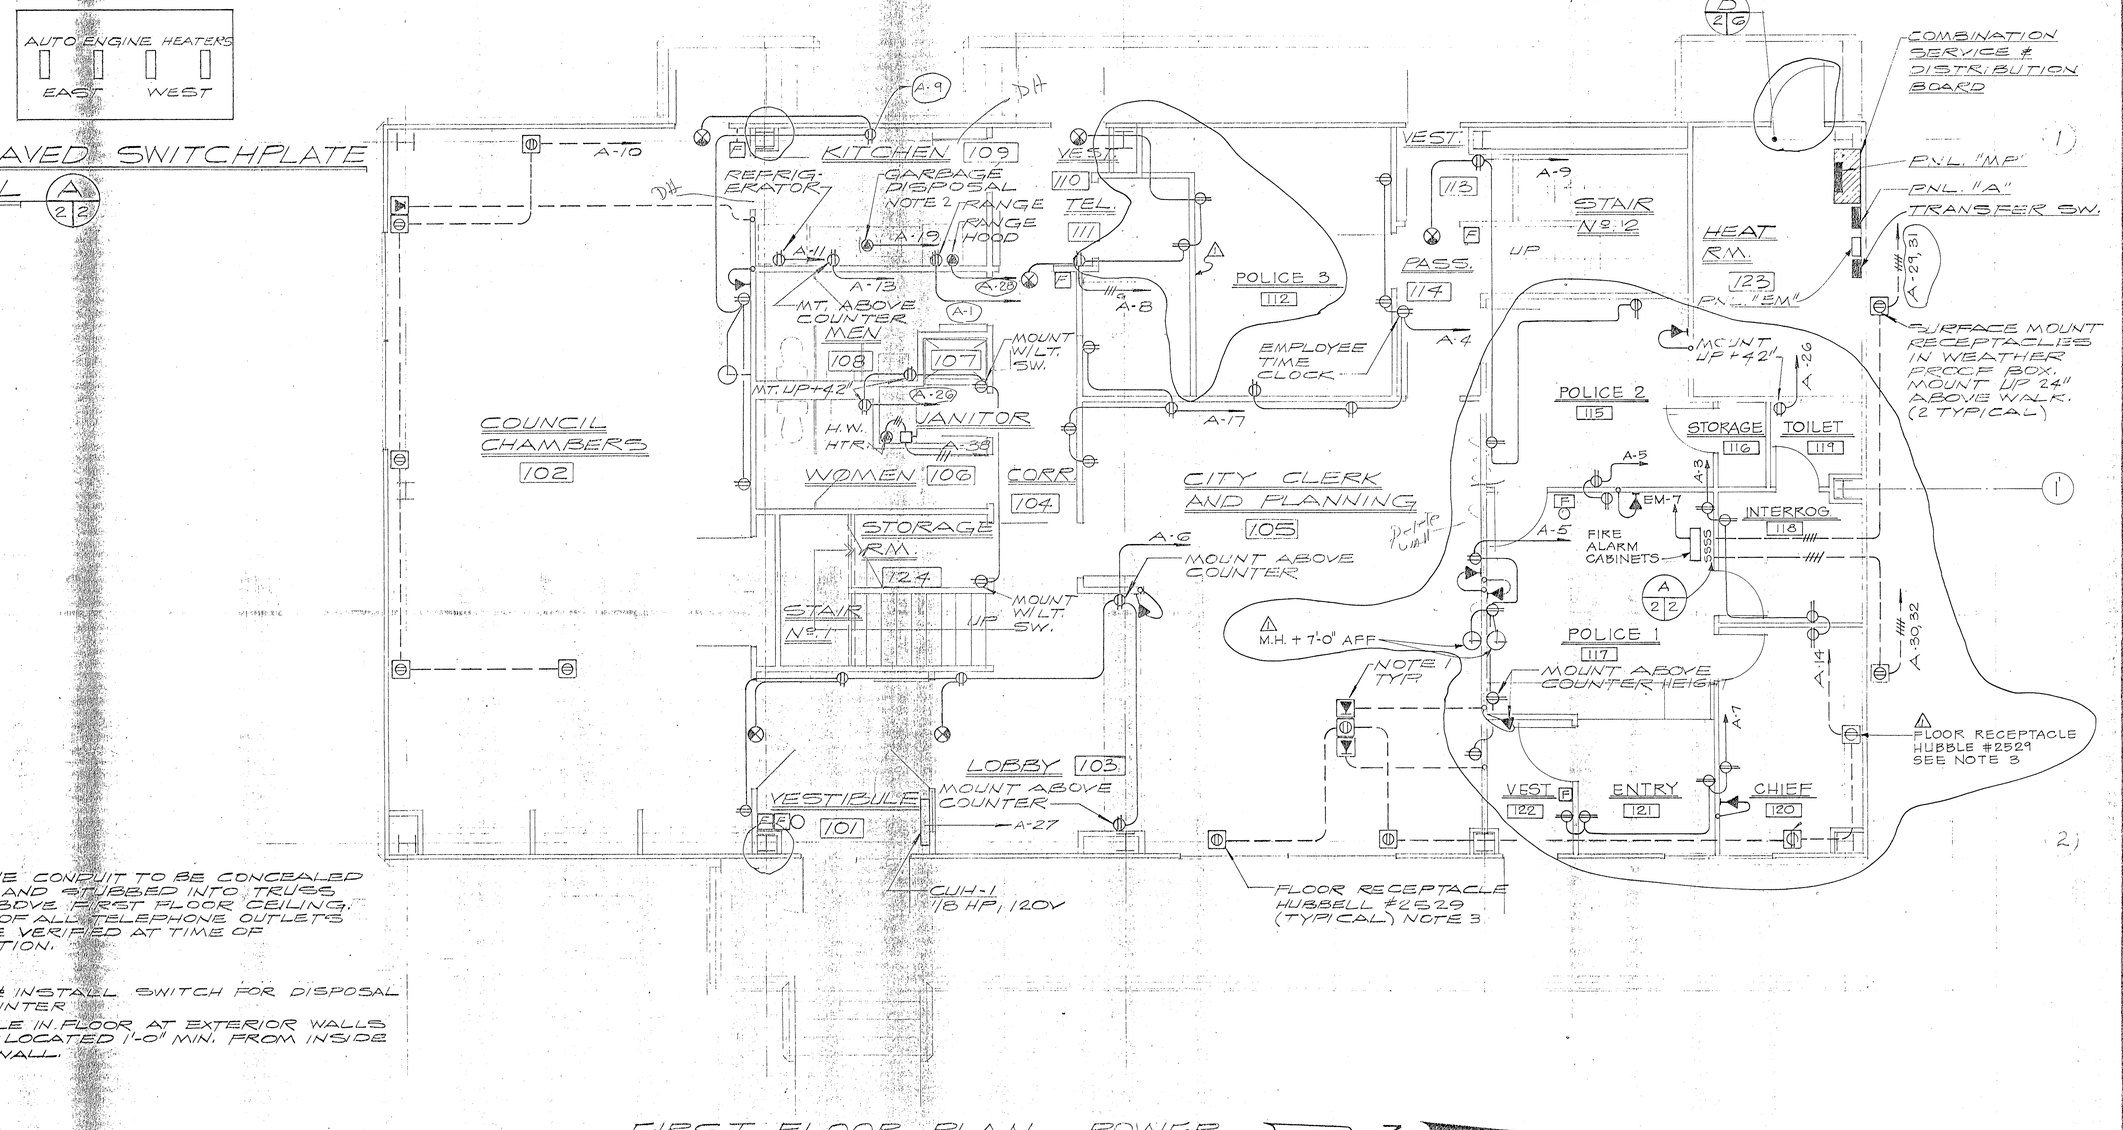

NOTES:

1. TELEPHONE CONDUIT TO BE CONCEALED IN WALLS AND STUBBED INTO TRUSS SPACE ABOVE FIRST FLOOR CEILING. LOCATION OF ALL TELEPHONE OUTLETS SHALL BE VERIFIED AT TIME OF INSTALLATION.
2. FURNISH & INSTALL SWITCH FOR DISPOSAL ABOVE COUNTER.
3. RECEPTACLE IN FLOOR AT EXTERIOR WALLS SHALL BE LOCATED 1'-0" MIN. FROM INSIDE FACE OF WALL.

FIRST FLOOR PLAN — POWER

SCALE: 1/4" = 1'-0"

PROJECT NORTH

AS BUILT
DATE JAN. 27, 1977

STATE OF ALASKA 49TH
ADMIT L. HUNNICUTT No. 1119-E
REGISTERED PROFESSIONAL ENGINEER

CH2M HILL

DES. LLR.
DR. LAF.
CHK. RWB.
APPD. ALH.

NO.	DATE	REVISION	BY	APPD.
1	12-16-76	AS BUILT	GnB	

FIRST FLOOR PLAN 1/4"=1'-0"

BASIC BID NO 1

CITY HALL FOR NOME, ALASKA

SHEET OF E-2
PROJ. NO. C9327.1
DATE 6 FEB. '76
DWG. NO. C9327-1

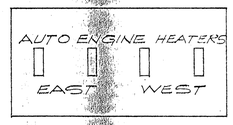

ENGRAVED SWITCHPLATE DETAIL (A 2/2)

N.T.S.

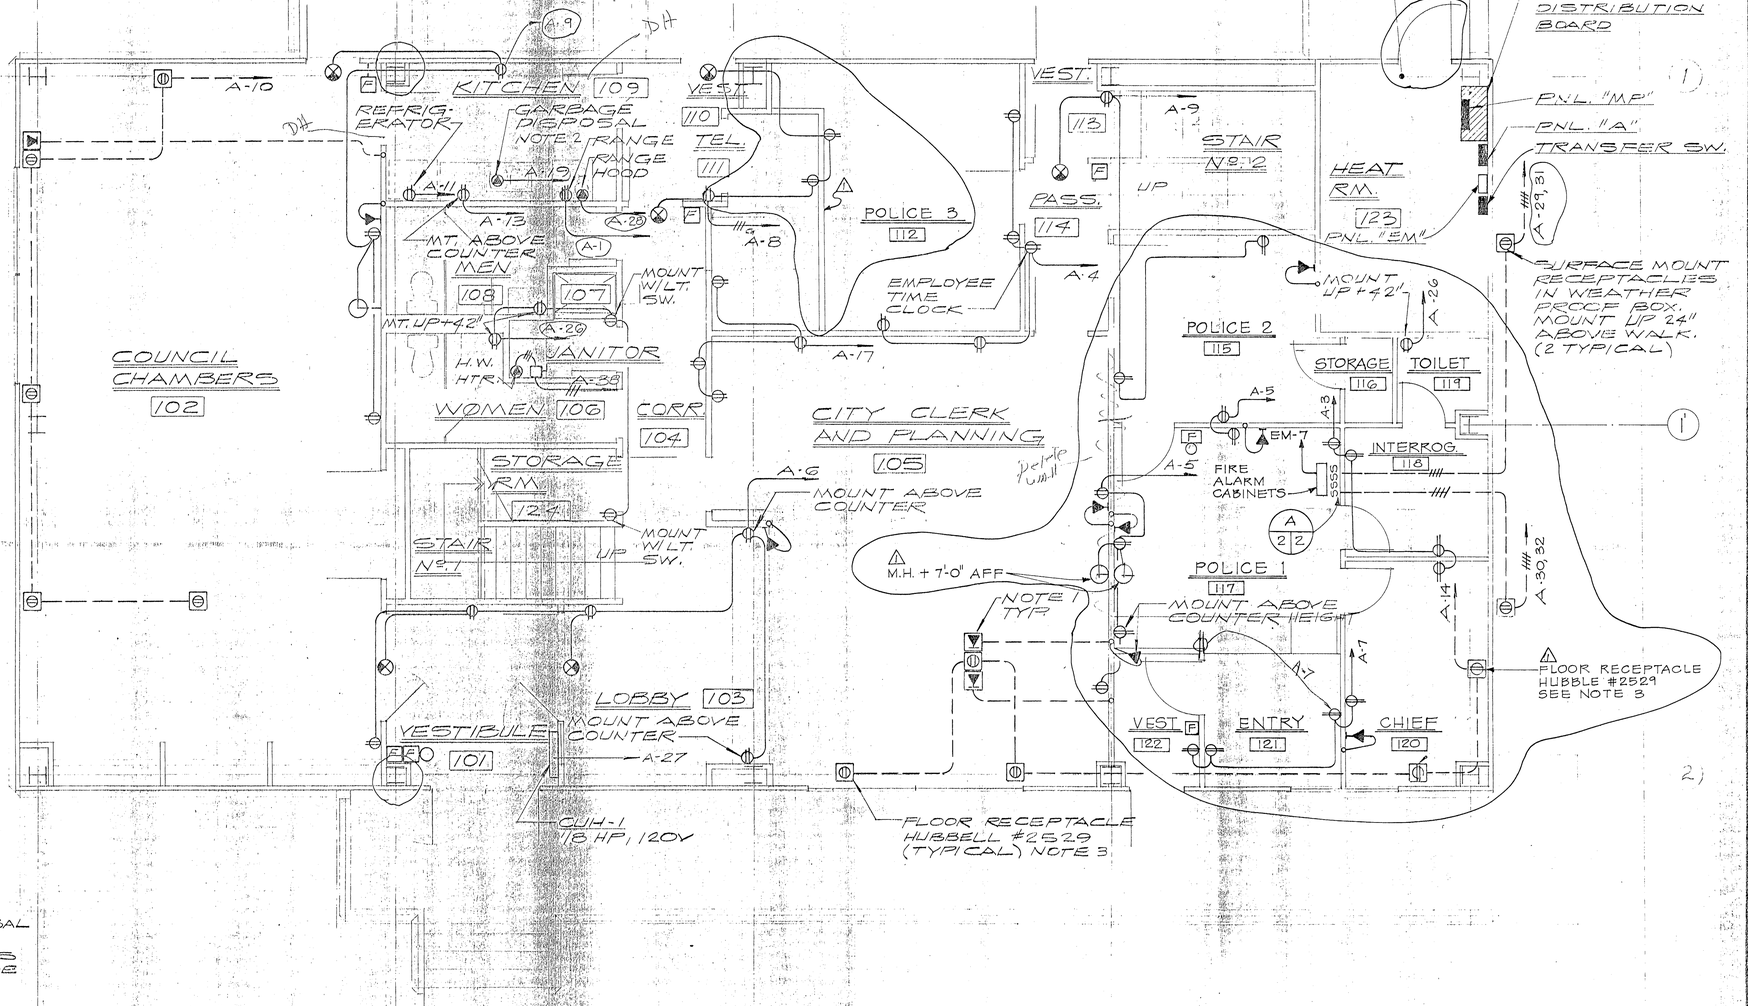

NOTES:

1. TELEPHONE CONDUIT TO BE CONCEALED IN WALLS AND STUBBED INTO TRUSS SPACE ABOVE FIRST FLOOR CEILING. LOCATION OF ALL TELEPHONE OUTLETS SHALL BE VERIFIED AT TIME OF INSTALLATION.
2. FURNISH & INSTALL SWITCH FOR DISPOSAL ABOVE COUNTER.
3. RECEPTACLE IN FLOOR AT EXTERIOR WALLS SHALL BE LOCATED 1'-0" MIN. FROM INSIDE FACE OF WALL.

FIRST FLOOR PLAN — POWER

SCALE: 1/4" = 1'-0"

PROJECT NORTH

AS BUILT
DATE JAN. 27, 1977

STATE OF ALASKA 49TH
ALAN L. HUNNICUTT
No. 11119-E
REGISTERED PROFESSIONAL ENGINEER

CH2M HILL ALASKA

DES. LLR.
DR. LAF.
CHK. RWB.
APPD. ALH.

NO.	DATE	REVISION	BY	APPD.
1	12-16-76	AS BUILT	SLB	

FIRST FLOOR PLAN 1/4" = 1'-0"

BASIC BID NO 1

CITY HALL FOR NOME, ALASKA

SHEET OF E-2
PROJ. NO. C9327.1
DATE 6 FEB. 76
DWG. NO. C9327-1

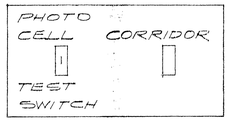

ENGRAVED SWITCHPLATE DETAIL (F 3|3)

N.T.S.

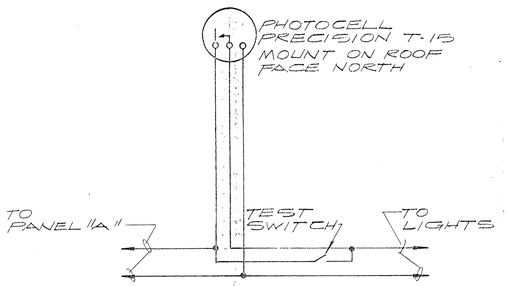

EXTERIOR LIGHTING CONTROL DIAGRAM (B 3|3)

N.T.S

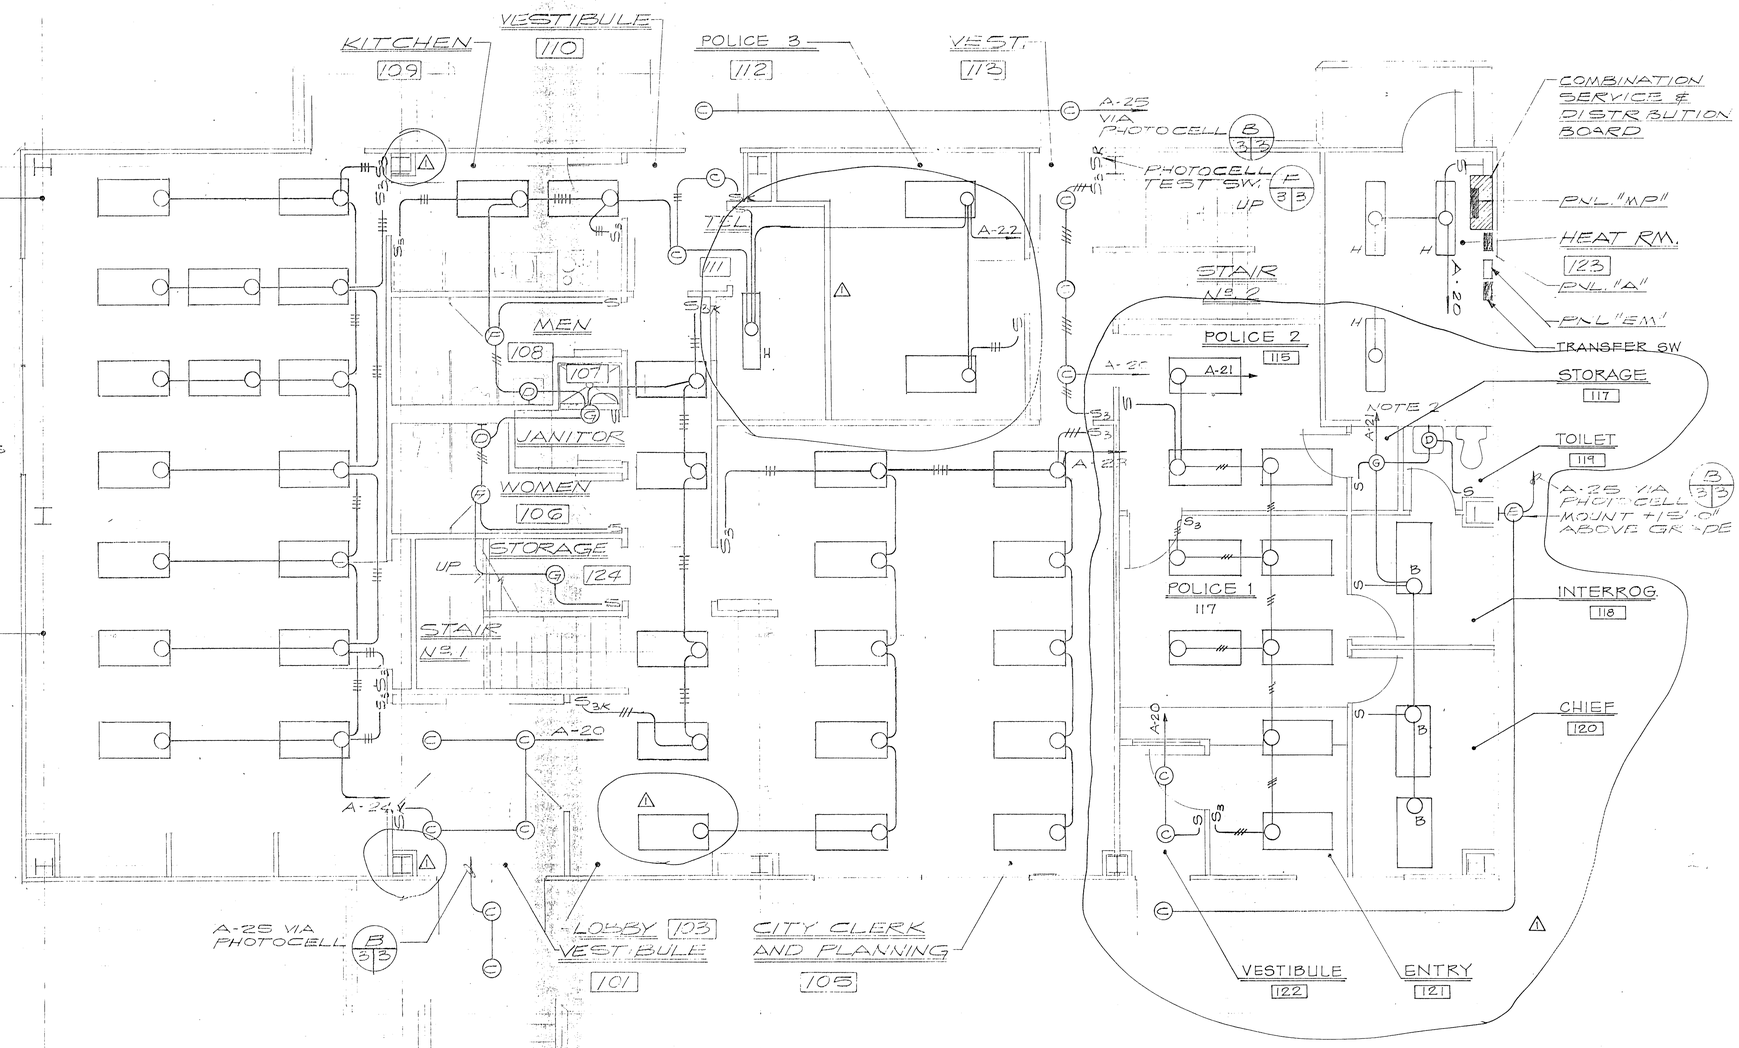

NOTES:

1. ALL LUMINAIRES ARE TYPE "A" UNLESS OTHERWISE NOTED ON PLAN.
2. PENDANT MOUNT LUMINAIRES TYPE "H" Δ 6'-0" MIN FROM FINISHED FLOOR, EXACT LOCATION TO BE COORDINATED WITH MECHANICAL EQUIPMENT.

FIRST FLOOR PLAN - LIGHTING

SCALE: 1/4" = 1'-0"

PROJECT NORTH

AS BUILT
DATE JAN 27 1977

STATE OF ALASKA 49TH
JUAN L. HONNOLD
No. 11196
REGISTERED PROFESSIONAL ENGINEER

CH: LLF. DR: LAT CHK. RWS APD. ALL	Δ 12-27-76 AS BUILT	NO.	DATE	REVISION	BY	APPD.	FIRST FLOOR PLAN 1/4" = 1'-0"

BASIC BID NO 1

CITY HALL FOR NOME, ALASKA

SHEET OF E-3
PROJ. NO. 4327.1
DATE 2 FEB. '76
DWG. NO. C4327-1

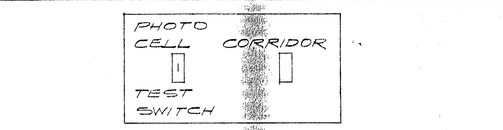

ENGRAVED SWITCHPLATE DETAIL (F 3|3)

N.T.S.

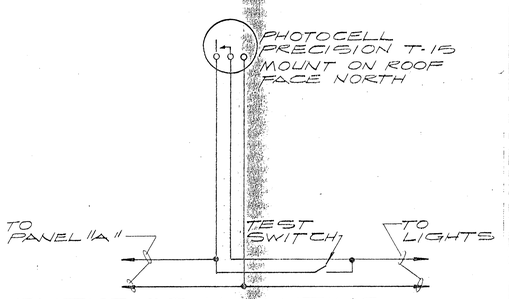

EXTERIOR LIGHTING CONTROL DIAGRAM (B 3|3)

N.T.S

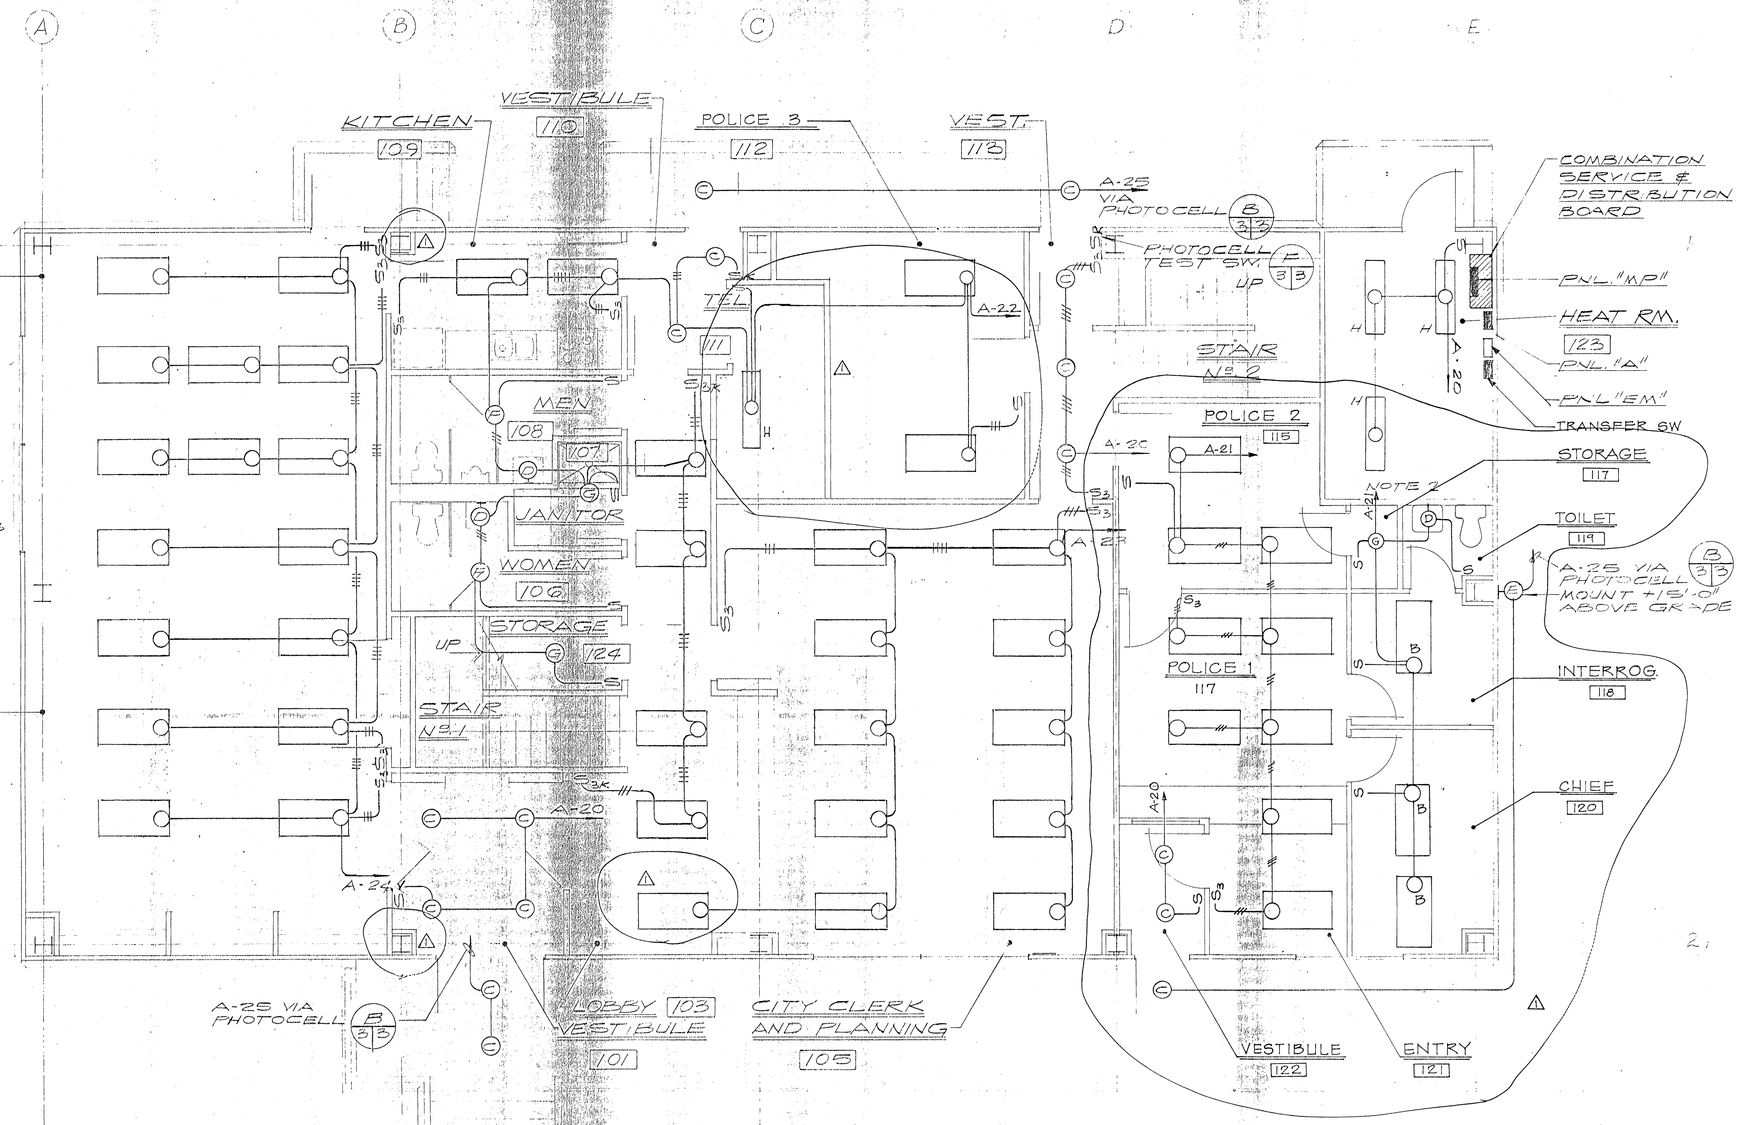

NOTES:

1. ALL LUMINAIRES ARE TYPE "A" UNLESS OTHERWISE NOTED ON PLAN.
2. PENDANT MOUNT LUMINAIRES TYPE "H" Δ 6'-0" MIN FROM FINISHED FLOOR, EXACT LOCATION TO BE COORDINATED WITH MECHANICAL EQUIPMENT.

FIRST FLOOR PLAN - LIGHTING

SCALE: 1/4" = 1'-0"

PROJECT NORTH

AS BUILT
DATE JAN 27 1977

STATE OF ALASKA 49TH
ALAN L. HUNNICUTT
No. 1110-E
REGISTERED PROFESSIONAL ENGINEER

CH2M HILL ALASKA

DES. LLR.					
DR. LAF.					
CHK. RWB.					
APPD. ALH.					
NO.	DATE	REVISION	BY	APPD.	
Δ	12-17-76	AS BUILT	BoB		

FIRST FLOOR PLAN 1/4" = 1'-0"

BASIC BID NO 1

CITY HALL FOR NOME, ALASKA

SHEET OF E-3
PROJ. NO. 4327.1
DATE 4 FEB. '76
DWG. NO. C4327-1

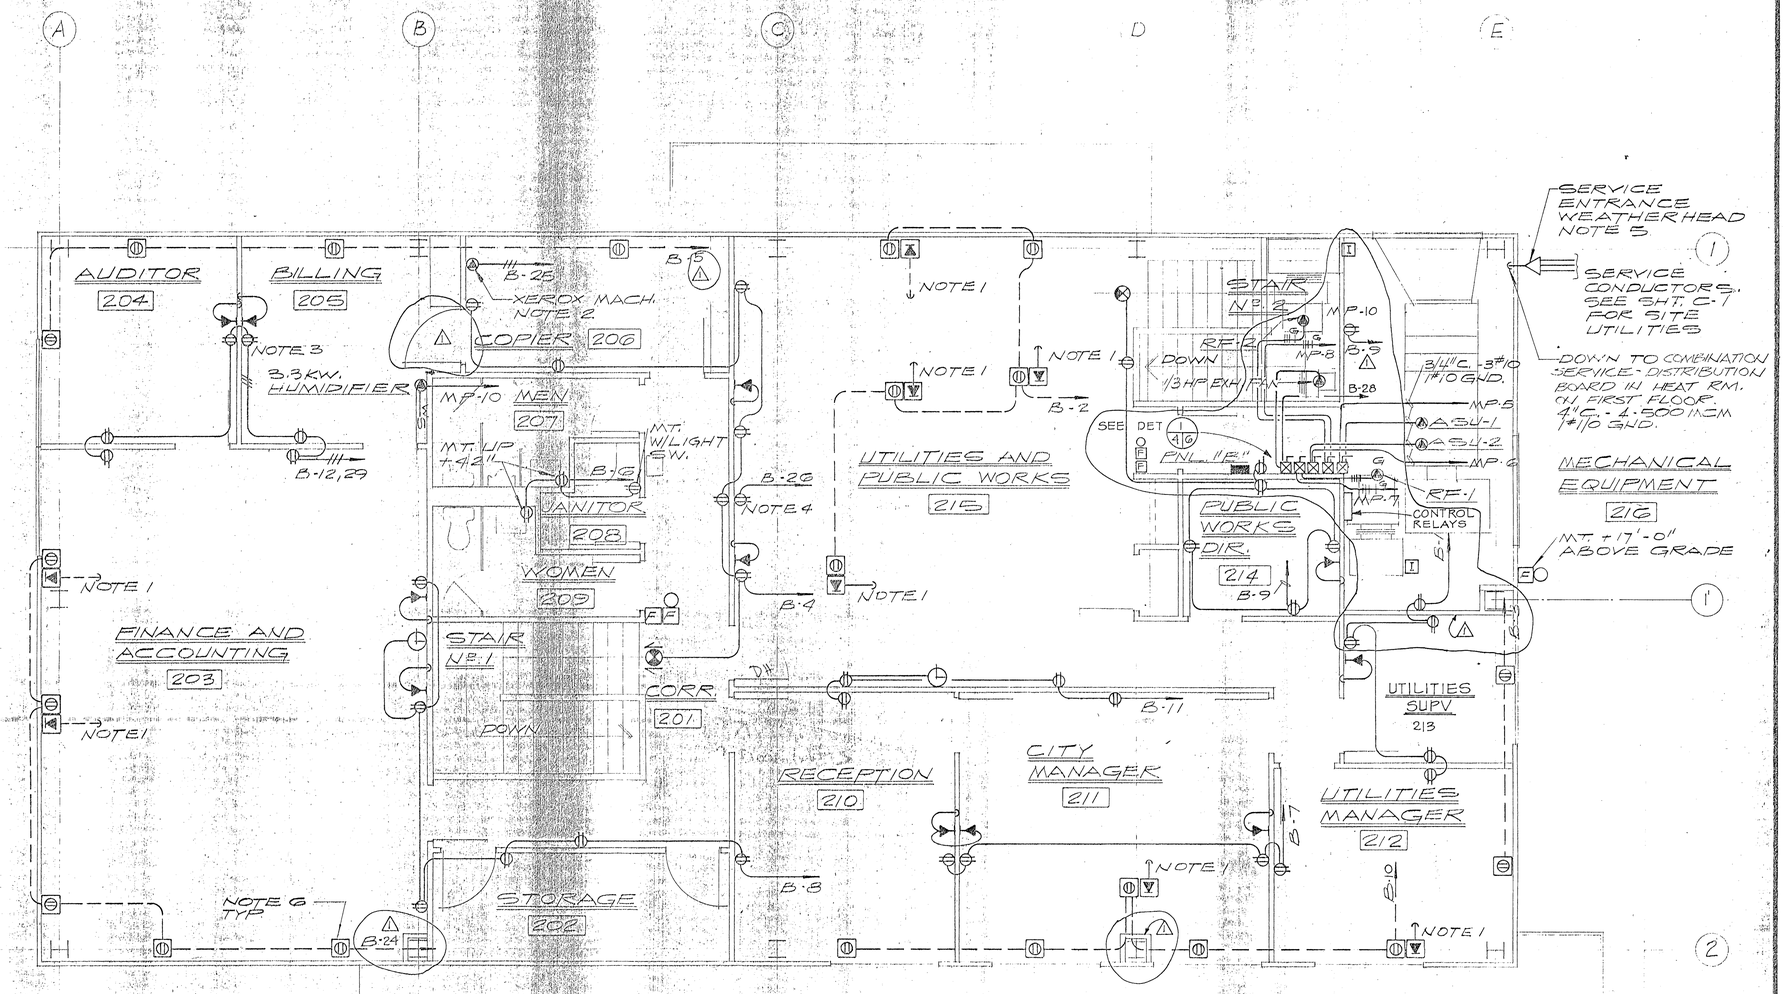

NOTES:

1. STUB TELEPHONE CONDUIT INTO TRUSS SPACE BELOW. TYPICAL ALL TELEPHONE CONDUITS ON SECOND FLOOR. LOCATION OF ALL TELEPHONE OUTLETS SHALL BE VERIFIED AT THE TIME OF INSTALLATION.
2. XEROX MACHINE RECEPTACLE TO MATCH EXISTING PLUG ON MACHINE.
3. BILLING MACHINE RECEPTACLE TO MATCH EXISTING PLUG ON MACHINE. VERIFY LOCATION.
4. OUTLET FOR COMMUNICATIONS CENTER TO BE LOCATED +36" FROM FLOOR.
5. SERVICE ENTRANCE CONDUIT SHALL EXTEND THROUGH ROOF TO A POINT 24" ABOVE THE ROOF. USE SERVICE ENTRANCE FITTING SIMILAR TO APPLETON #K400.
6. RECEPTACLES IN FLOOR AT EXTERIOR WALLS SHALL BE LOCATED 1'-0" MIN. FROM INSIDE FACE OF WALL.

CONTINUED AT RIGHT

NOTES CONTINUED FROM LEFT

7. CONDUIT & WIRING FROM MECHANICAL EQUIPMENT TO TERMINAL CONNECTIONS IN START-STOP SW. SHALL BE FURNISHED & INSTALLED BY ELECTRICAL CONTRACTOR.
8. CONTROL CONDUIT & WIRING FROM CONTROL POINTS TO PILOT DEVICES, SUCH AS T-STATS, HUMIDIFIERS & FLOW SWITCHES SHALL BE SUPPLIED AND INSTALLED BY MECHANICAL CONTRACTOR.

SECOND FLOOR PLAN — POWER

SCALE 1/4" = 1'-0"

PROJECT NORTH

AS BUILT
DATE JAN 27 1977

STATE OF ALASKA 49TH
ALAN C. HUNNICUTT No. 1119-E REGISTERED PROFESSIONAL ENGINEER
12-7-76

CH2M HILL

DES. LLR.					
DR. LAF.					
CHK. RWB.					
APPD. ALH.					
NO.	DATE	REVISION	BY	APPD.	
1	12-17-76	AS BUILT	GaB		

SECOND FLOOR PLAN 1/4"=1'-0"

BASIC BID NO. 1

CITY HALL FOR NOME, ALASKA

SHEET OF E-4
PROJ. NO. K9327.1
DATE 6 FEB. '76
DWG. NO. C9327-1

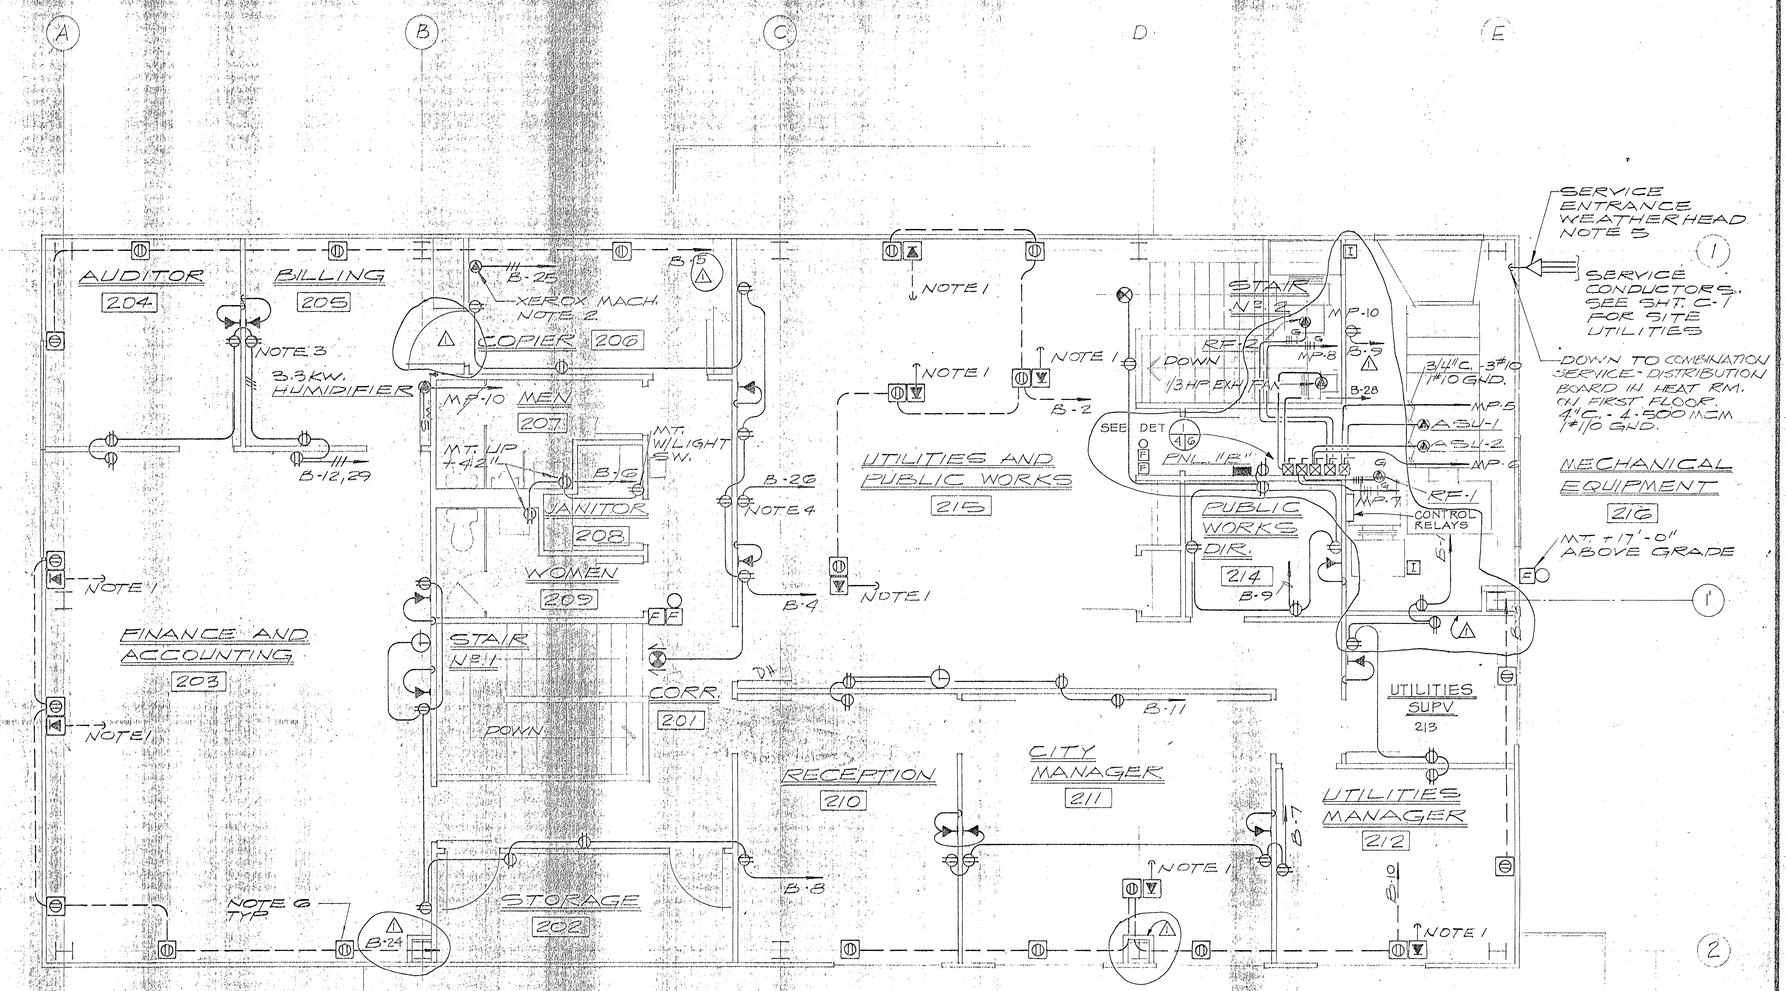

NOTES:

1. STUB TELEPHONE CONDUIT INTO TRUSS SPACE BELOW. TYPICAL ALL TELEPHONE CONDUITS ON SECOND FLOOR. LOCATION OF ALL TELEPHONE OUTLETS SHALL BE VERIFIED AT THE TIME OF INSTALLATION.
2. XEROX MACHINE RECEPTACLE TO MATCH EXISTING PLUG ON MACHINE.
3. BILLING MACHINE RECEPTACLE TO MATCH EXISTING PLUG ON MACHINE. VERIFY LOCATION.
4. OUTLET FOR COMMUNICATIONS CENTER TO BE LOCATED +36" FROM FLOOR.
5. SERVICE ENTRANCE CONDUIT SHALL EXTEND THROUGH ROOF TO A POINT 24" ABOVE THE ROOF. USE SERVICE ENTRANCE FITTING, SIMILAR TO APPLETON #EK400.
6. RECEPTACLES IN FLOOR AT EXTERIOR WALLS SHALL BE LOCATED 1'-0" MIN. FROM INSIDE FACE OF WALL.

CONTINUED AT RIGHT

NOTES CONTINUED FROM LEFT

7. CONDUIT & WIRING FROM MECHANICAL EQUIPMENT TO TERMINAL CONNECTIONS IN START-STOP SW. SHALL BE FURNISHED & INSTALLED BY ELECTRICAL CONTRACTOR.
8. CONTROL CONDUIT & WIRING FROM CONTROL POINTS TO PILOT DEVICES, SUCH AS T-STATS, HUMIDIFIERS & FLOW SWITCHES SHALL BE SUPPLIED AND INSTALLED BY MECHANICAL CONTRACTOR.

SECOND FLOOR PLAN — POWER

SCALE: 1/4" = 1'-0"

PROJECT NORTH

AS BUILT
DATE JAN 27 1977

STATE OF ALASKA 49TH
Alan C. Hunnicutt
ALAN C. HUNNICUTT
No. 1119-E
REGISTERED PROFESSIONAL ENGINEER

CH2M HILL ALASKA

DES. LLR.
DR. LAF.
CHK. RWB.
APPD. ALH.

NO.	DATE	REVISION	BY	APPD.
1	12-17-76	AS BUILT	WB	

SECOND FLOOR PLAN 1/4"=1'-0"

BASIC BID NO. 1

CITY HALL FOR NOME, ALASKA

SHEET OF E-4
PROJ. NO. K9327.1
DATE 6 FEB. '76
DWG. NO. C9327-1

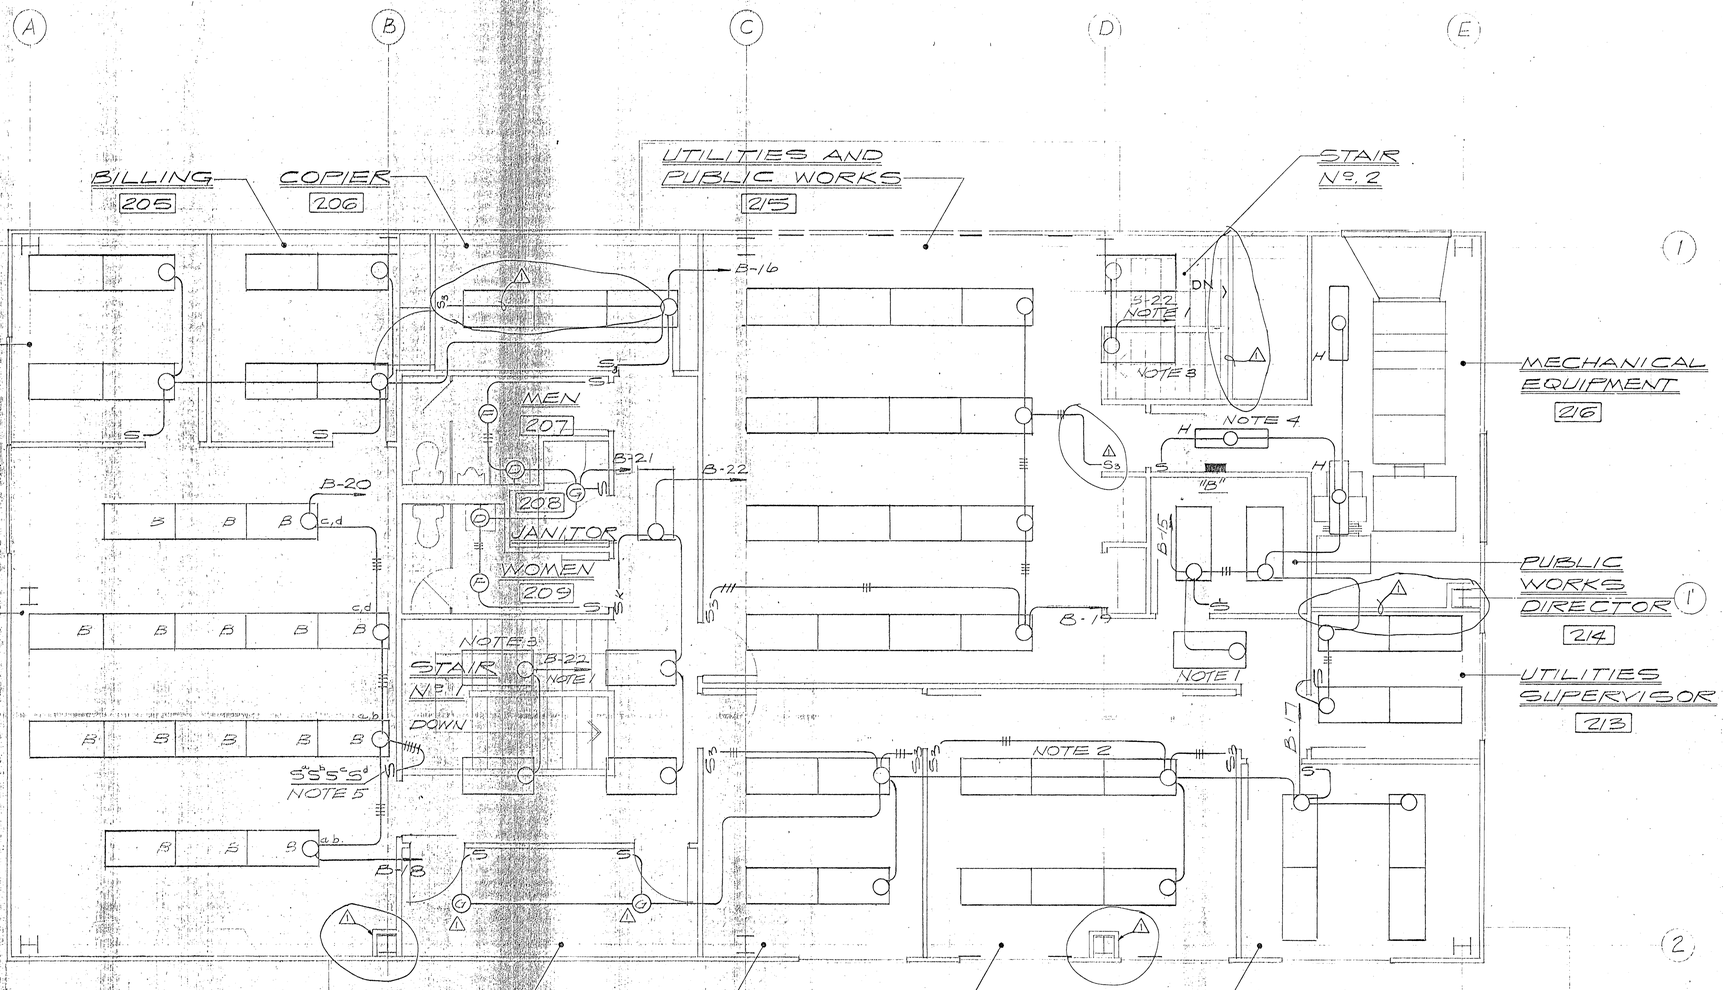

NOTES:

1. NIGHT LIGHT CONTROLLED BY CIRCUIT BREAKER ONLY.
2. ALL LUMINAIRES ARE TYPE "A" UNLESS OTHERWISE NOTED ON THE PLAN.
3. THIS LUMINAIRE SHALL BE EQUIPPED WITH A JEFFERSON Nº 400-201 EMERGENCY FLUORESCENT LIGHTING PACK. CONSULT MFR. FOR COMPATABILITY WITH OTHER MFR. BALLAST AS SUPPLIED W/LUMINAIRE. CURCUIT SUPPLYING STAIR LUMINAIRES MUST REMAIN ON TO INSURE CHARGE ON BATTERY FOR FULL 90 MIN. OPERATION.
4. PENDANT MOUNT LUMINAIRES TYPE "H" 8'-0" FROM FINISHED FLOOR.
5. IN TYPE "B" LUMINAIRE, 2 INSIDE LAMPS AND 2 OUTSIDE LAMPS TO BE SWITCHED SEPARATELY.

SECOND FLOOR PLAN LIGHTING

SCALE: 1/4" = 1'-0"

PROJECT NORTH

AS BUILT
DATE JAN 27 1977

STATE OF ALASKA 49TH
ALAN L. HUNNICUTT
No. 1119-E
REGISTERED PROFESSIONAL ENGINEER

CH2M HILL

DES. LLR.					
DR. LAF.					
CHK. RWB.	1	12-23-76	AS-BUILT	BeB	
APPD. ALH.	NO.	DATE	REVISION	BY	APPD.

SECOND FLOOR PLAN 1/4"-1'-0"

BASIC BID NO. 1

CITY HALL FOR NOME, ALASKA

SHEET OF E-5
PROJ. NO. K9327.1
DATE 6 FEB. '76
DWG. NO. C9327-1

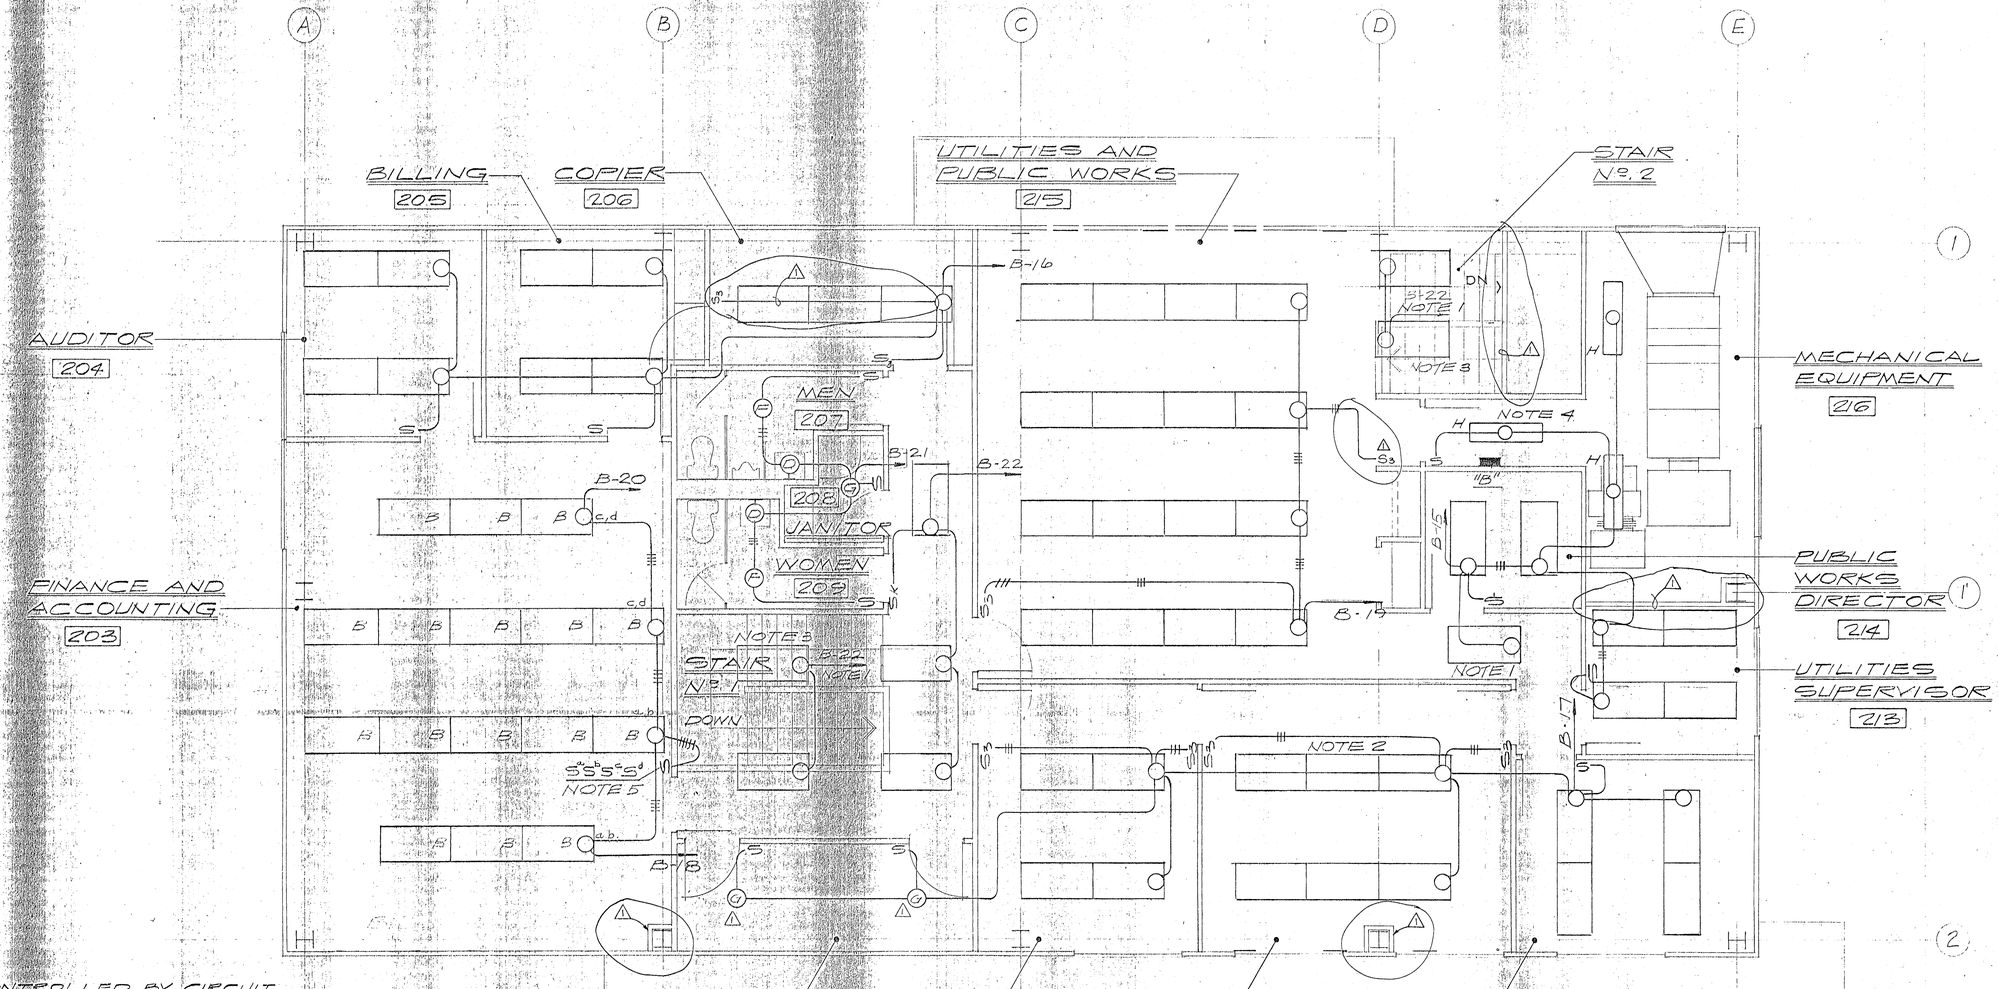

NOTES:

1. NIGHT LIGHT CONTROLLED BY CIRCUIT BREAKER ONLY.
2. ALL LUMINAIRES ARE TYPE "A" UNLESS OTHERWISE NOTED ON THE PLAN.
3. THIS LUMINAIRE SHALL BE EQUIPPED WITH A JEFFERSON Nº 400-201 EMERGENCY FLUORESCENT LIGHTING PACK. CONSULT MFR. FOR COMPATABILITY WITH OTHER MFR. BALLAST AS SUPPLIED W/LUMINAIRE. CURCUIT SUPPLYING STAIR LUMINAIRES MUST REMAIN ON TO INSURE CHARGE ON BATTERY FOR FULL 90 MIN. OPERATION.
4. PENDANT MOUNT LUMINAIRES TYPE "H" 8'-0" FROM FINISHED FLOOR.
5. IN TYPE "B" LUMINAIRE, 2 INSIDE LAMPS AND 2 OUTSIDE LAMPS TO BE SWITCHED SEPARATELY.

SECOND FLOOR PLAN LIGHTING

SCALE: 1/4" = 1'-0"

PROJECT NORTH

AS BUILT
DATE JAN. 2-7-1977

STATE OF ALASKA — 49TH — ALAN L. RUNNICUTT — No. 1119-E — REGISTERED PROFESSIONAL ENGINEER

CH2M HILL ALASKA

DES. LLR.
DR. LAF.
CHK. RWB.
APPD. ALH.

NO.	DATE	REVISION	BY	APPD.
1.	12-23-76	AS-BUILT	GeB	

SECOND FLOOR PLAN 1/4"=1'-0"

BASIC BID NO. 1

CITY HALL FOR NOME, ALASKA

SHEET OF E-5
PROJ. NO. K9327.1
DATE 6 FEB. '76
DWG. NO. C9327-1

LUMINAIRE SCHEDULE

SYMBOL	TYPE	VOLTAGE	DESCRIPTION	MANUFACTURER	CATALOG NO.	LAMPS	MOUNTING
A	FLUOR.	120	2'-X 4' FLUORESCENT LAY-IN WITH RECESSED LENS, HINGE AND LATCH FRAMES	SYLVANIA LIGHTOLIER	KEW-BD-2404 PLBAR-7372-48RS	(2)F40T12WW	LAY-IN
B	FLUOR.	120	SAME AS A EXCEPT 4 LAMP.	SYLVANIA LIGHTOLIER	KEW-BD-4404 PLBAR-7374-48RS	(4)F40T12WW	LAY-IN
C	INC.	120	6" NOM. DIAMETER DOWNLIGHT, SPECULAR ALZAK REFLECTOR, 45° ANGLE CUT-OFF, MINI-TRIM BAKE WHITE ENAMEL TRIM FINISH.	LIGHTOLIER GOTHAM	7707 R948	150WR40	WALL
D	INC.	120	EXTRUDED ALUMINUM HOUSING WALL BRACKET ACRYLIC LENS.	ART METAL GOTHAM	W-1001 215	2-60W A-19	WALL @ 6'-6"
E	HID	120	CAST ALUMINUM, WEATHERPROOF FULLY GASKETED, SPECULAR ALUMINUM REFLECTOR, PRISMATIC MOLDED THERMAL SHOCK-RESISTANT BOROSILICATE GLASS	ART METAL HOLOPHANE	MW88 580-120	BT28 250W	WALL WALL
F	INC.	120	12" SQUARE WHITE OPAL DRUM	LIGHTOLIER PRESCOLITE	G822 7012	2-100W - A-19	SURFACE
G	INC.	120	KEYLESS LAMPHOLDER	BRYANT G.E.	5228 5740-7	1-100W - A-19	SURFACE
H	INC.	120	FULLY AUTOMATIC SELF-CONTAINED EXIT SIGN. CAST ALUMINUM. STENCIL FACES UNIVERSAL ARROWS. 90 MINUTE OPERATION MIN. RED LETTERS. DOUBLE FACE.	DUAL-LITE TEAL	DRWWSG SGX-C-2-A	2-15W A.C. 2-5W D.C.	CEILING
J	INC.	120	SAME AS ABOVE EXCEPT SINGLE FACE	DUAL-LITE TEAL	SRWWSG SGX-C-1-A		CEILING
K	FLUOR.	120	INDUSTRIAL FLUOR. W/20 GA. STEEL CHANNEL AND REFLECTOR, WHITE ENAMEL FINISH, 10% UP LIGHT	BENJAMIN MILLER KEENE-SMITHCRAFT	FL-1024-4U 19-2191-04 SF12408E	F40T12-CW	PENDANT

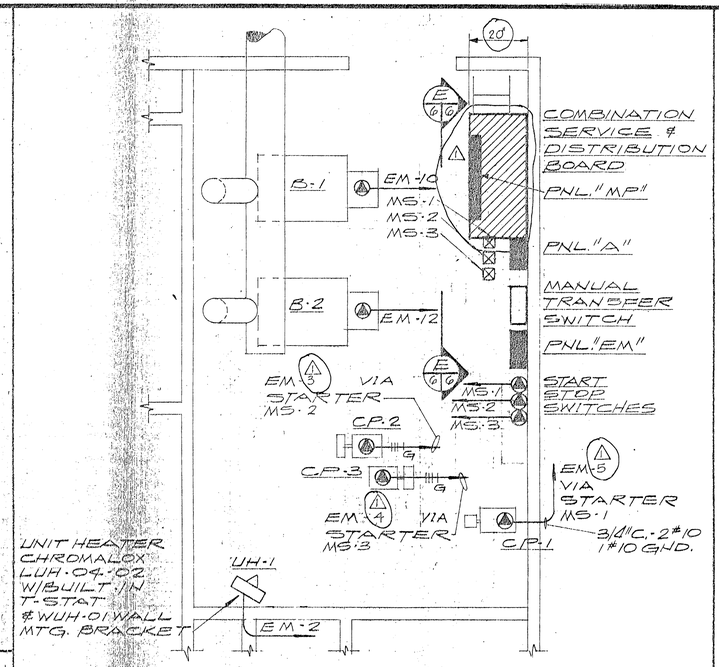

POWER HEAT ROOM D 2 G

1/2" = 1'-0"

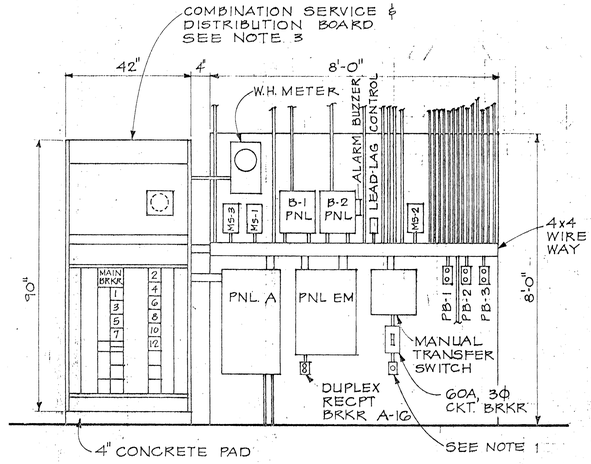

ELEVATION E G G

1/2" = 1'-0"

NOTE:

FIRE ALARM SYSTEM SHALL BE INSTALLED IN CONDUIT, CONDUIT SIZE, NUMBER & SIZE OF CONDUCTORS SHALL BE IN ACCORDANCE W/MANUFACTURERS INSTRUCTIONS.

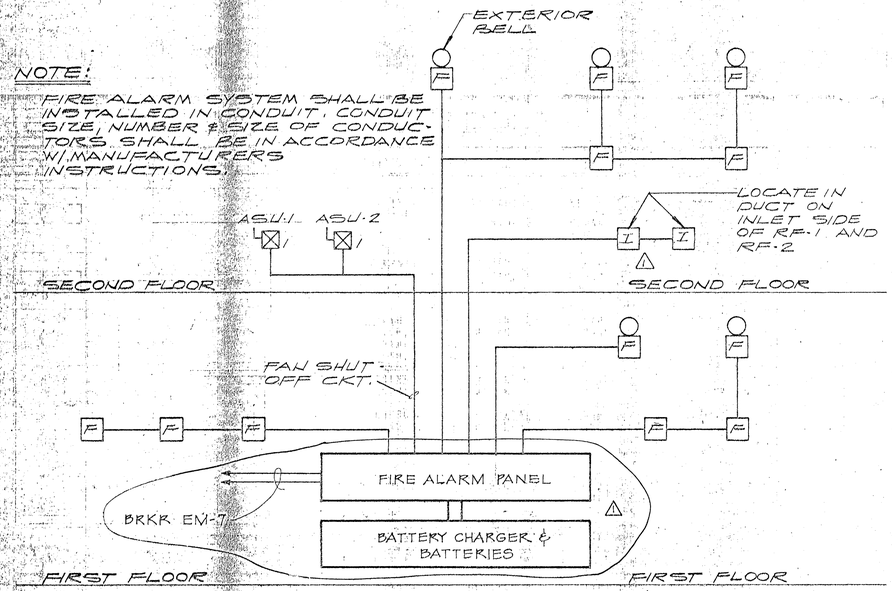

FIRE ALARM RISER DIAGRAM C 2 4 G

N.T.S.

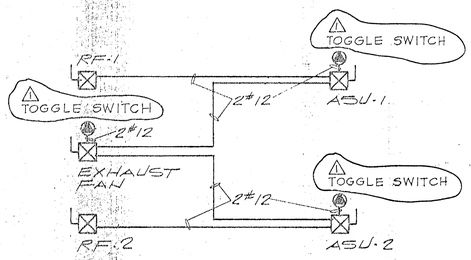

NOTE:

DIAGRAM SHOWS NUMBER OF WIRES BETWEEN DEVICES. RUN IN RIGID STEEL CONDUIT AS REQUIRED.

DETAIL 1 4 G

N.T.S.

NOTES:

1. POWER RECEPTACLE TO MATCH PLUG ON EXISTING PORTABLE STANDBY GENERATOR. VERIFY TYPE & SIZE WITH OWNER (CITY OF NOME).
2. CURRENT TRANSFORMERS SHALL BE SUPPLIED & INSTALLED BY PANEL BOARD MANUFACTURER. USE STANDARD 800:5 METERING C.T.'S.
3. COMBINATION SERVICE & DISTRIBUTION BOARD IS △ SQUARE D COMPANY, TYPE SW-1
4. CONDUIT & WIRING FROM MECHANICAL EQUIPMENT TO TERMINAL CONNECTIONS IN START-STOP SWITHES SHALL BE FURNISHED & INSTALLED BY ELECTRICAL CONTRACTOR.
5. CONTROL CONDUIT & WIRING FROM CONTROL POINTS TO PILOT DEVICES, SUCH AS T-STATS, HUMIDIFIERS & FLOW SWITCHES, BE SUPPLIED & INSTALLED BY MECHANICAL CONTRACTOR.
6. SEE MECHANICAL DRAWING M-8 FOR STARTER AUXILIARY CONTACTS.

AS BUILT
DATE JAN 27 1977 7-1977

STATE OF ALASKA 49TH
REGISTERED PROFESSIONAL ENGINEER
DIV. 1119-E

CH2M HILL

DES. LLR.				
DR. LAF.				
CHK. RWB.	△	12-27-76	AS-BUILT	LeB
APPD. ALH.	NO.	DATE	REVISION	BY APPD.

LUMINAIRE SCHEDULE AND MISCELANEOUS DETAILS

AS SHOWN

BASIC BID NO. 1

CITY HALL FOR NOME, ALASKA

SHEET OF E-6
PROJ. NO. K 9327.1
DATE 6 FEB. '76
DWG. NO. C9327-1

LUMINAIRE SCHEDULE

SYMBOL	TYPE	VOLTAGE	DESCRIPTION	MANUFACTURER	CATALOG NO.	LAMPS	MOUNTING
A	FLUOR.	120	2' x 4' FLUORESCENT LAY-IN WITH RECESSED LENS. HINGE AND LATCH FRAMES.	SYLVANIA LIGHTOLIER	KEW-80-2404 PLBAR-7372-4BRS	(2)F40T12WW	LAY-IN
B	FLUOR.	120	SAME AS A EXCEPT 4 LAMP.	SYLVANIA LIGHTOLIER	KEW-80-4404 PLBAR-7374-4BRS	(4)F40T12WW	LAY-IN
C	INC.	120	8" NOM. DIAMETER DOWNLIGHT, SPECULAR ALZAK REFLECTOR, 45° ANGLE CUT-OFF, MINI-TRIM BAKE WHITE ENAMEL TRIM FINISH.	LIGHTOLIER GOTHAM	7707 R948	150WR40	WALL
D	INC.	120	EXTRUDED ALUMINUM HOUSING WALL BRACKET ACRYLIC LENS.	ART METAL GOTHAM	W-1001 215	2-60W A-19	WALL @ 6'-6"
E	HID	120	CAST ALUMINUM, WEATHERPROOF FULLY GASKETED, SPECULAR ALUMINUM REFLECTOR, PRISMATIC MOLDED THERMAL SHOCK-RESISTANT BOROSILICATE GLASS	ART METAL HOLOPHANE	MWBB 588-120	BT28 250W	WALL WALL
F	INC.	120	12" SQUARE WHITE OPAL DRUM	LIGHTOLIER PRESCOLITE	GB22 7012	2-100W - A-19	SURFACE
G	INC.	120	KEYLESS LAMPHOLDER	BRYANT G.E.	5228 5740-7	1-100W - A-19	SURFACE
H	INC.	120	FULLY AUTOMATIC SELF-CONTAINED EXIT SIGN. CAST ALUMINUM. STENCIL FACES UNIVERSAL ARROWS. 90 MINUTE OPERATION MIN. RED LETTERS. DOUBLE FACE.	DUAL-LITE TEAL	DRWWSG SGX-C-2-A	2-15W A.C. 2-5W D.C.	CEILING
J	INC.	120	SAME AS ABOVE EXCEPT SINGLE FACE	DUAL-LITE TEAL	SRWWSG SGX-C-1-A		CEILING
K	FLUOR.	120	INDUSTRIAL FLUOR. W/20 GA. STEEL CHANNEL AND REFLECTOR, WHITE ENAMEL FINISH, 10% UP LIGHT	BENJAMIN MILLER KEENE-SMITHCRAFT	FL-1024-4U 10-2101-04 SF1240BE	F40T12-CW	PENDANT

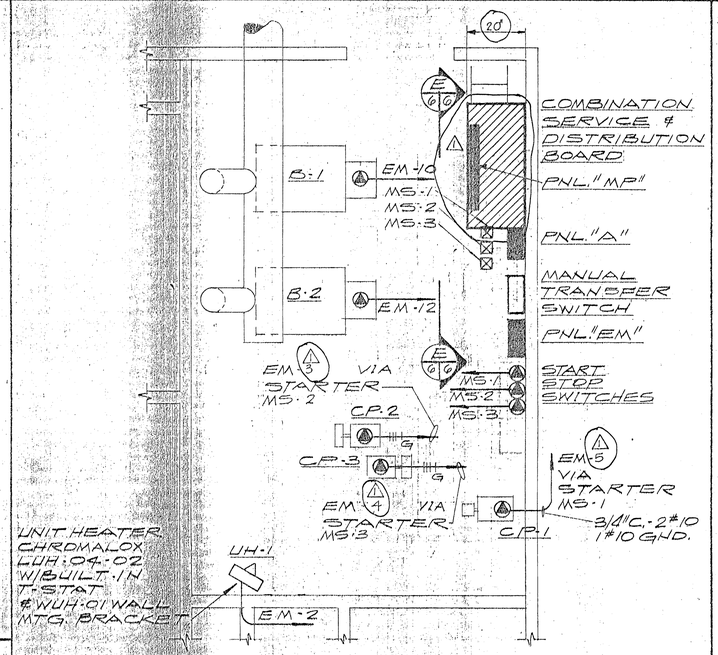

POWER HEAT ROOM (D/2/G)

1/2" = 1'-0"

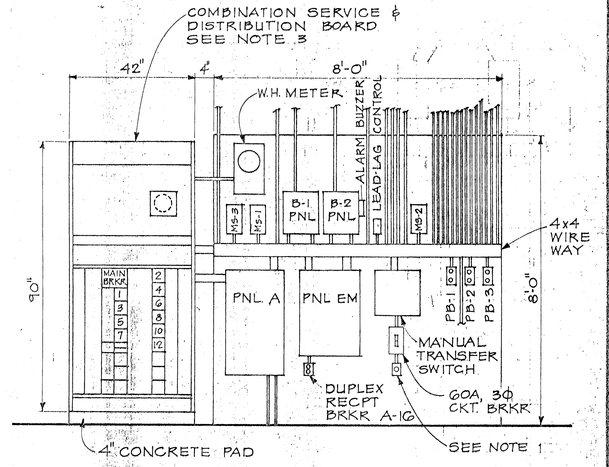

ELEVATION (E/G/G)

1/2" = 1'-0"

NOTE:

FIRE ALARM SYSTEM SHALL BE INSTALLED IN CONDUIT. CONDUIT SIZE, NUMBER & SIZE OF CONDUCTORS SHALL BE IN ACCORDANCE W/ MANUFACTURER'S INSTRUCTIONS.

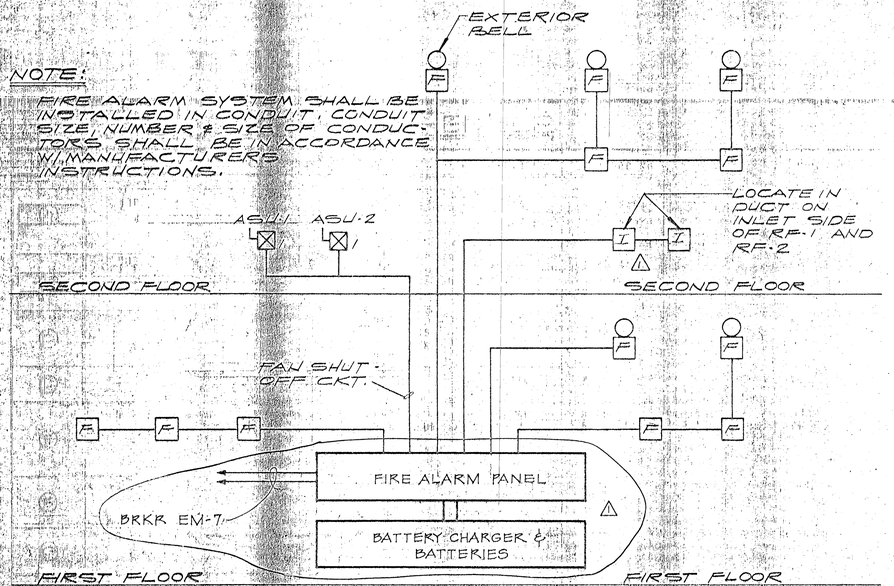

FIRE ALARM RISER DIAGRAM (C/12/G)

N.T.S.

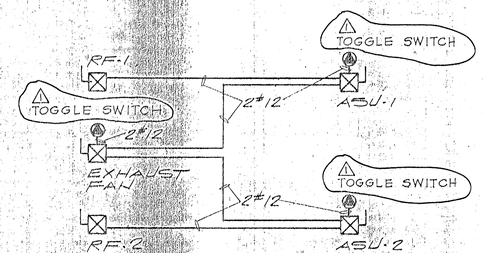

NOTE:

DIAGRAM SHOWS NUMBER OF WIRES BETWEEN DEVICES. RUN IN RIGID STEEL CONDUIT AS REQUIRED.

DETAIL (1/4/G)

N.T.S.

NOTES:

1. POWER RECEPTACLE TO MATCH PLUG ON EXISTING PORTABLE STANDBY GENERATOR. VERIFY TYPE & SIZE WITH OWNER (CITY OF NOME).
2. CURRENT TRANSFORMERS SHALL BE SUPPLIED & INSTALLED BY PANEL BOARD MANUFACTURER. USE STANDARD 800:5 METERING C.T.'S.
3. COMBINATION SERVICE & DISTRIBUTION BOARD IS SQUARE D COMPANY, TYPE, SW-1
4. CONDUIT & WIRING FROM MECHANICAL EQUIPMENT TO TERMINAL CONNECTIONS IN START-STOP SWITHES SHALL BE FURNISHED & INSTALLED BY ELECTRICAL CONTRACTOR.
5. CONTROL CONDUIT & WIRING FROM CONTROL POINTS TO PILOT DEVICES, SUCH AS T-STATS, HUMIDISTATS & FLOW SWITCHES, BE SUPPLIED & INSTALLED BY MECHANICAL CONTRACTOR.
6. SEE MECHANICAL DRAWING M-8 FOR STARTER AUXILIARY CONTACTS.

AS BUILT
DATE JAN 27 1977
7 1977

CH2M HILL ALASKA

DES. LLR. DR. LAF. CHK. RWB. APPD. ALH.

NO.	DATE	REVISION	BY	APPD.
1	12-27-76	AS-BUILT		

LUMINAIRE SCHEDULE AND MISCELANEOUS DETAILS

AS SHOWN

BASIC BID NO. 1

CITY HALL FOR NOME, ALASKA

SHEET OF E-6
PROJ. NO. K 9327.1
DATE 6 FEB. 76
DWG. NO. C9327-1

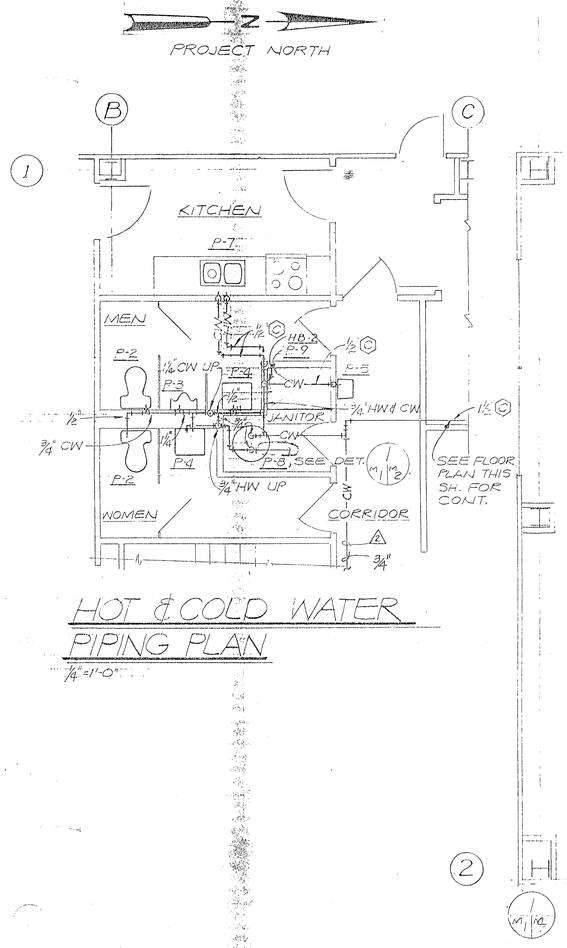

HOT & COLD WATER PIPING PLAN

1/4"=1'-0"

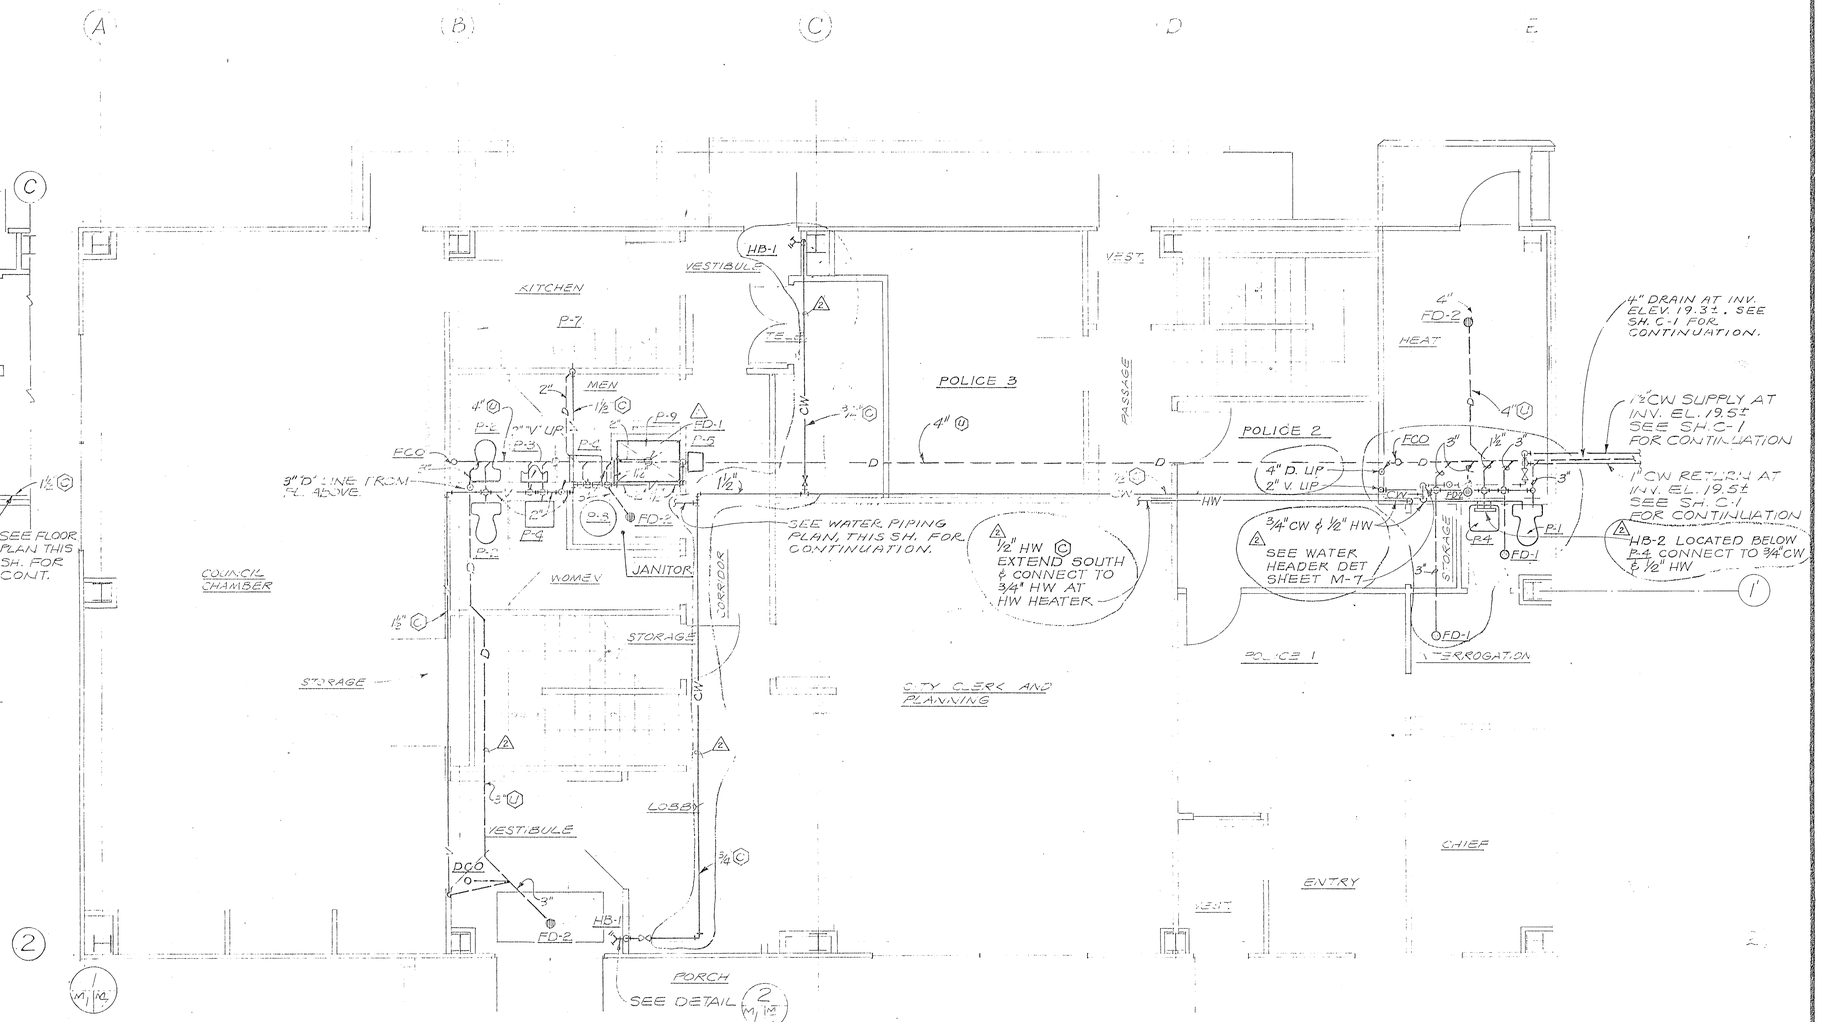

PLUMBING PLAN

AS BUILT
DATE JAN 27 1977

PLUMBING FIXTURE SCHEDULE

NO.	DESCRIPTION	W.	V.	C.W.	H.W.
P-1	WATER CLOSET	3	2	1/2	-
P-2	WATER CLOSET (HANDICAP)	3	2	1/2	-
P-3	URINAL	2	2	3/4	-
P-4	LAVATORY	1/2	1 1/2	1/2	1/2
P-5	DRINKING FOUNTAIN	1/2	1 1/2	1/2	-
P-6	SERVICE BASIN	3	2	1/2	1/2
P-7	KITCHEN SINK	2	1 1/2	1/2	1/2
P-8	WATER HEATER	-	-	3/4	3/4
P-9	SHOWER	2"	1 1/2"	1/2"	1/2"
HB-1	HYDRANT	-	-	3/4"	-
HB-2	MIXING HYDRANT	-	-	1/2"	1/2"

STATE OF ALASKA
49TH
ALAN L. WORCESTER
No. 1710-E
REGISTERED PROFESSIONAL ENGINEER

CH2M HILL

DES. JDH
DR. JDH
CHK. WAK/[illegible]
APP'D ALH

NO.	DATE	REVISION	BY	APP'D
1	12-15-[illegible]	AS BUILT	GEB	
2	2-6-[illegible]	MISCELLANEOUS REVISIONS	[illegible]	[illegible]

FIRST FLOOR PLAN 1/4"=1'-0"
AND FIXTURE SCHEDULE

BASIC BID NO. 1
ALTERNATIVE 'A & B

CITY HALL FOR
NOME, ALASKA

SHEET M-1 OF 10
PROJ. NO. KA3371
DATE [illegible] JUN 76
DWG. NO.

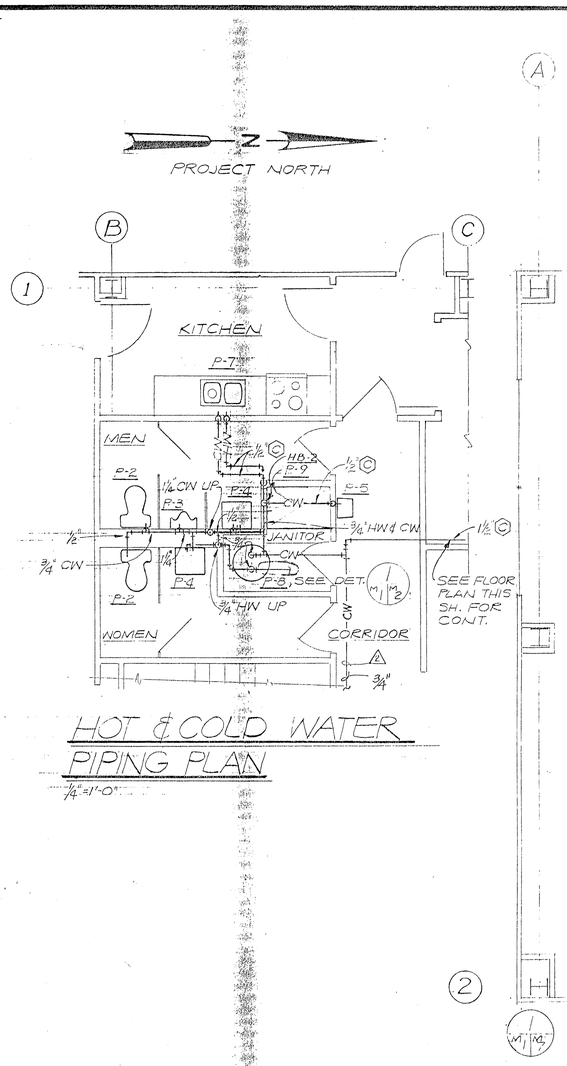

HOT & COLD WATER PIPING PLAN

1/4"=1'-0"

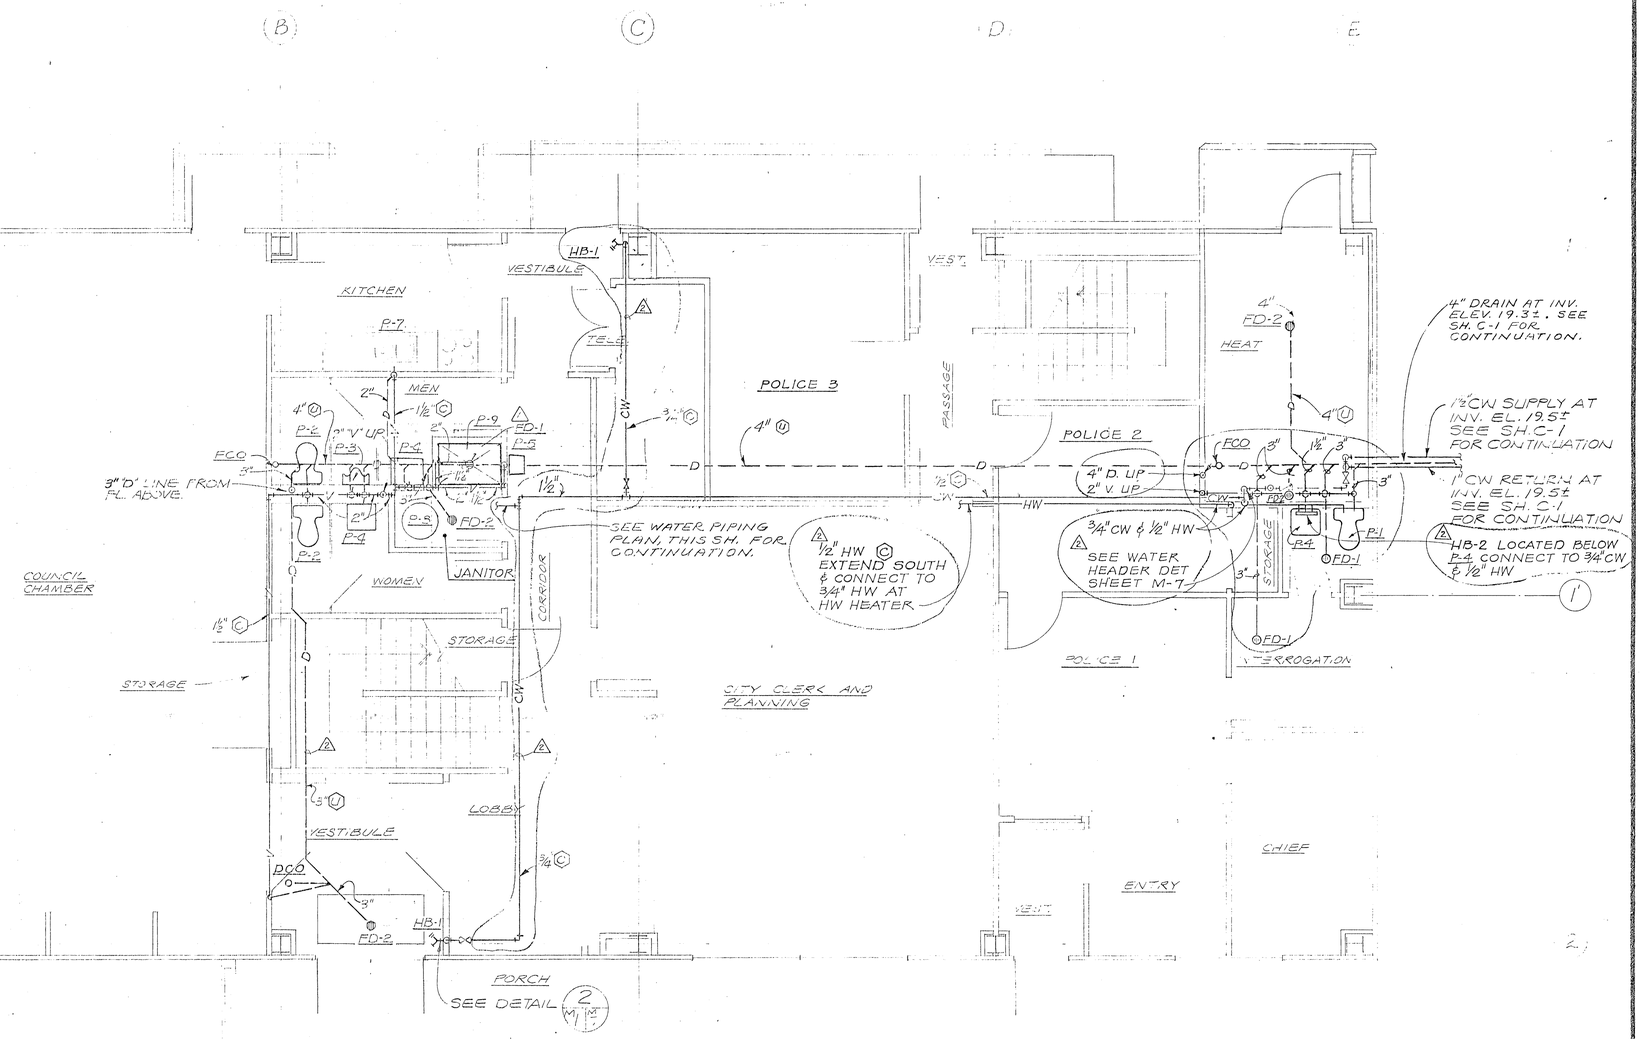

PLUMBING PLAN

AS BUILT
DATE JAN 27 1977

PLUMBING FIXTURE SCHEDULE

NO.	DESCRIPTION	W.	V.	C.W.	H.W.
P-1	WATER CLOSET	3	2	1/2	-
P-2	WATER CLOSET (HANDICAPPED)	3	2	1/2	-
P-3	URINAL	2	2	3/4	-
P-4	LAVATORY	1 1/2	1 1/2	1/2	1/2
P-5	DRINKING FOUNTAIN	1 1/2	1 1/2	1/2	-
P-6	SERVICE BASIN	3	2	1/2	1/2
P-7	KITCHEN SINK	2	1 1/2	1/2	1/2
P-8	WATER HEATER	-	-	3/4	3/4
P-9	SHOWER	2"	1 1/2"	1/2"	1/2"
HB-1	HYDRANT	-	-	3/4"	-
HB-2	MIXING HYDRANT	-	-	1/2"	1/2"

STATE OF ALASKA — 49TH — DANIEL PORTOUKALIAN — NO. 7776-E — REGISTERED PROFESSIONAL ENGINEER

CH2M HILL

NO.	DATE	REVISION	BY	APPD.
		DES. JDH		
		DR. JDH		
1	12-[illegible]-76	AS BUILT	GEB	
2	2-[illegible]-77	MISCELLANEOUS REVISIONS	VAR	JF
		CHK. WAK/[illegible]		
		APPD. ALH		

FIRST FLOOR PLAN 1/4"=1'-0"
AND FIXTURE SCHEDULE

BASIC BID NO. 1
ALTERNATIVE 'A' & 'B'

CITY HALL FOR
NOME, ALASKA

SHEET M-1 OF 13
PROJ. NO. K7327.1
DATE [illegible], JUN 76
DWG. NO.

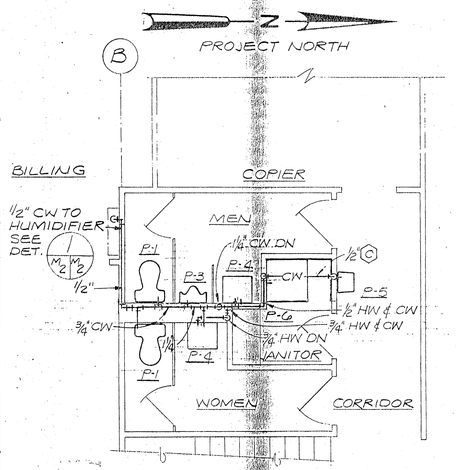

HOT & COLD WATER PIPING PLAN 1/4"=1'-0"

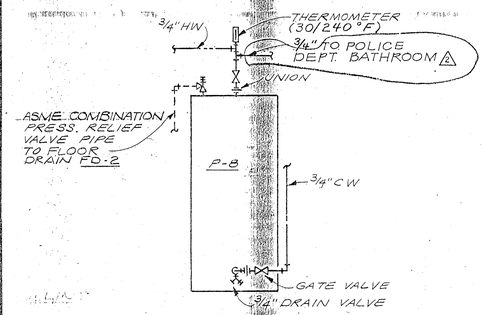

H.W. HEATER P-8 DETAIL M2/M2

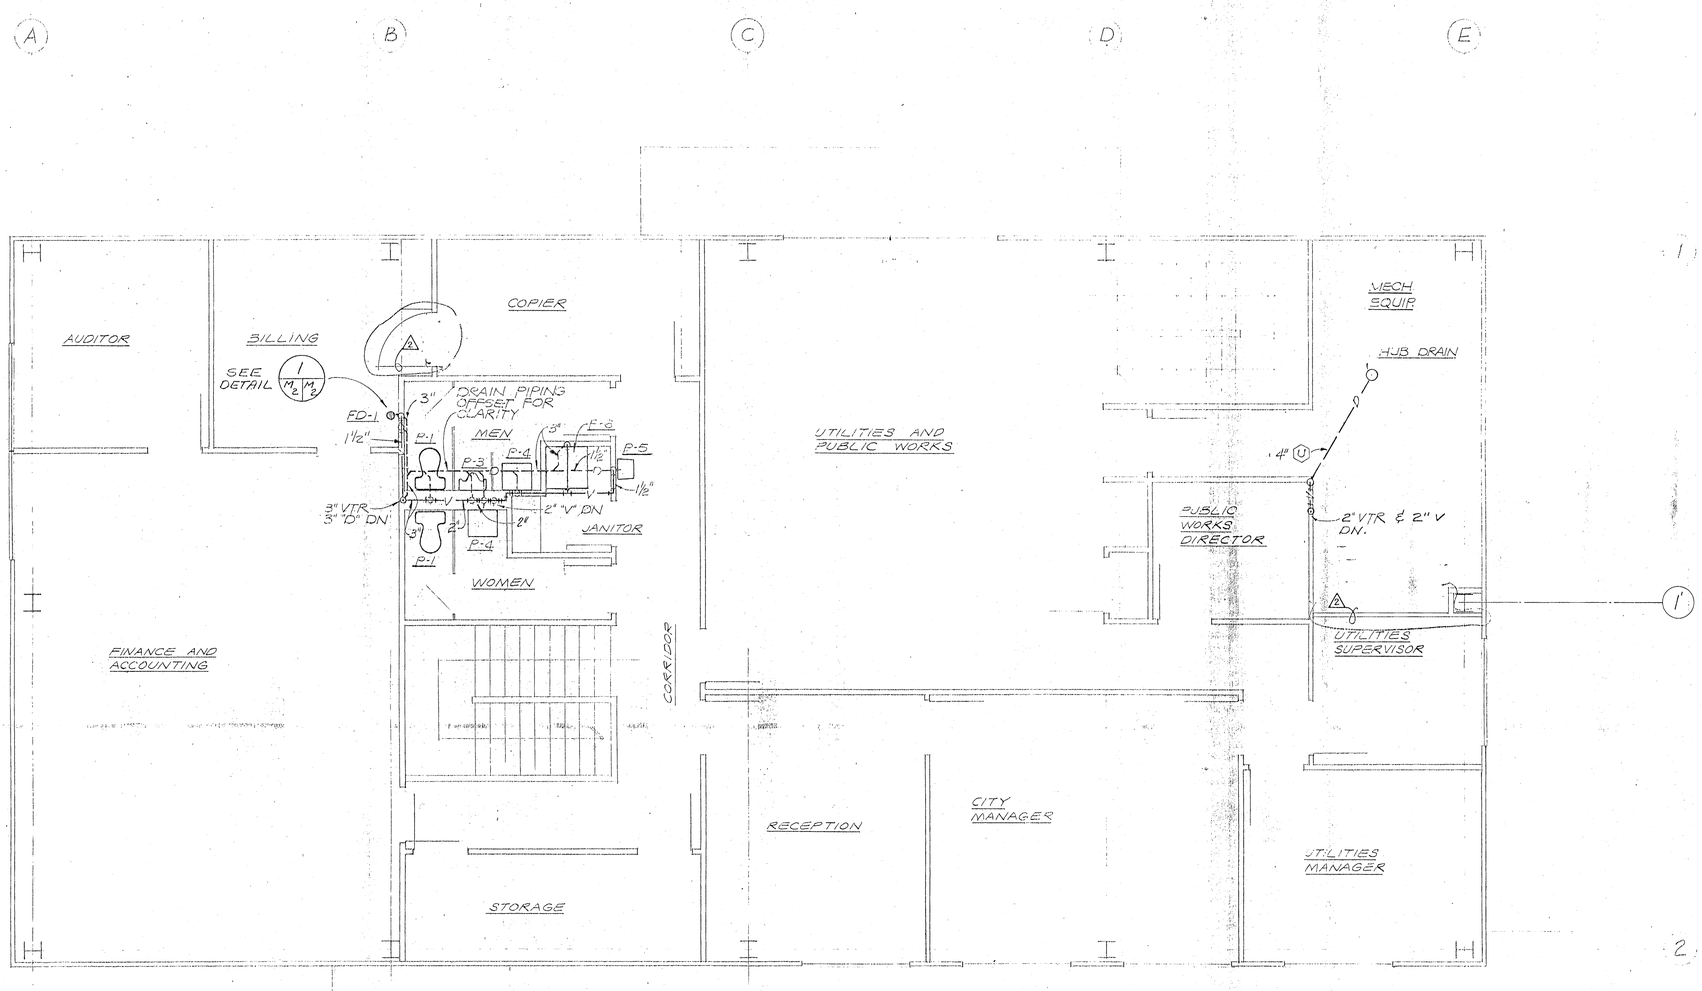

PLUMBING PLAN

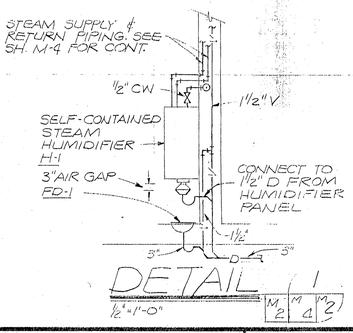

DETAIL 1 M2/M4/M2

1/2"=1'-0"

AS BUILT
DATE JAN 27 1977

STATE OF ALASKA 49TH
JOHN C. HOWICOTT
No. 1110-E
REGISTERED PROFESSIONAL ENGINEER

CH2M HILL

	DES.	DR.	CHK.	APPD.
	JDH	JDH	WAK/JWR	ALH

NO.	DATE	REVISION	BY	APPD.
2	12-15-76	AS BUILT	WAK	
1	2-6-76	MISCELLANEOUS REVISIONS	WAK	JJP

SECOND FLOOR PLAN 1/4" = 1'-0" AND DETAILS

BASIC BID NO. 1
ALTERNATIVE "C"

CITY HALL FOR NOME, ALASKA

SHEET OF M-2
PROJ. NO. K9327.1
DATE JUN '75
DWG. NO.

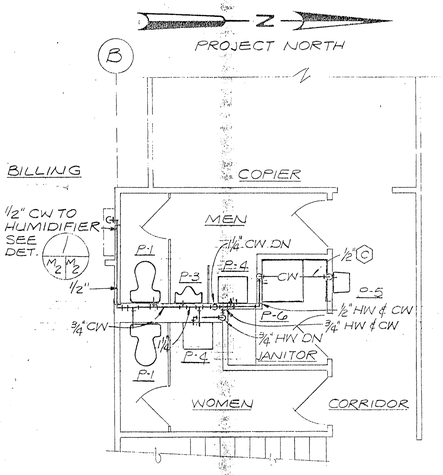

HOT & COLD WATER PIPING PLAN 1/4"=1'-0"

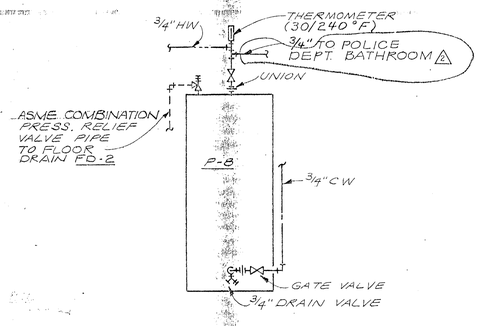

H.W. HEATER P-8 DETAIL 1/M1 M2

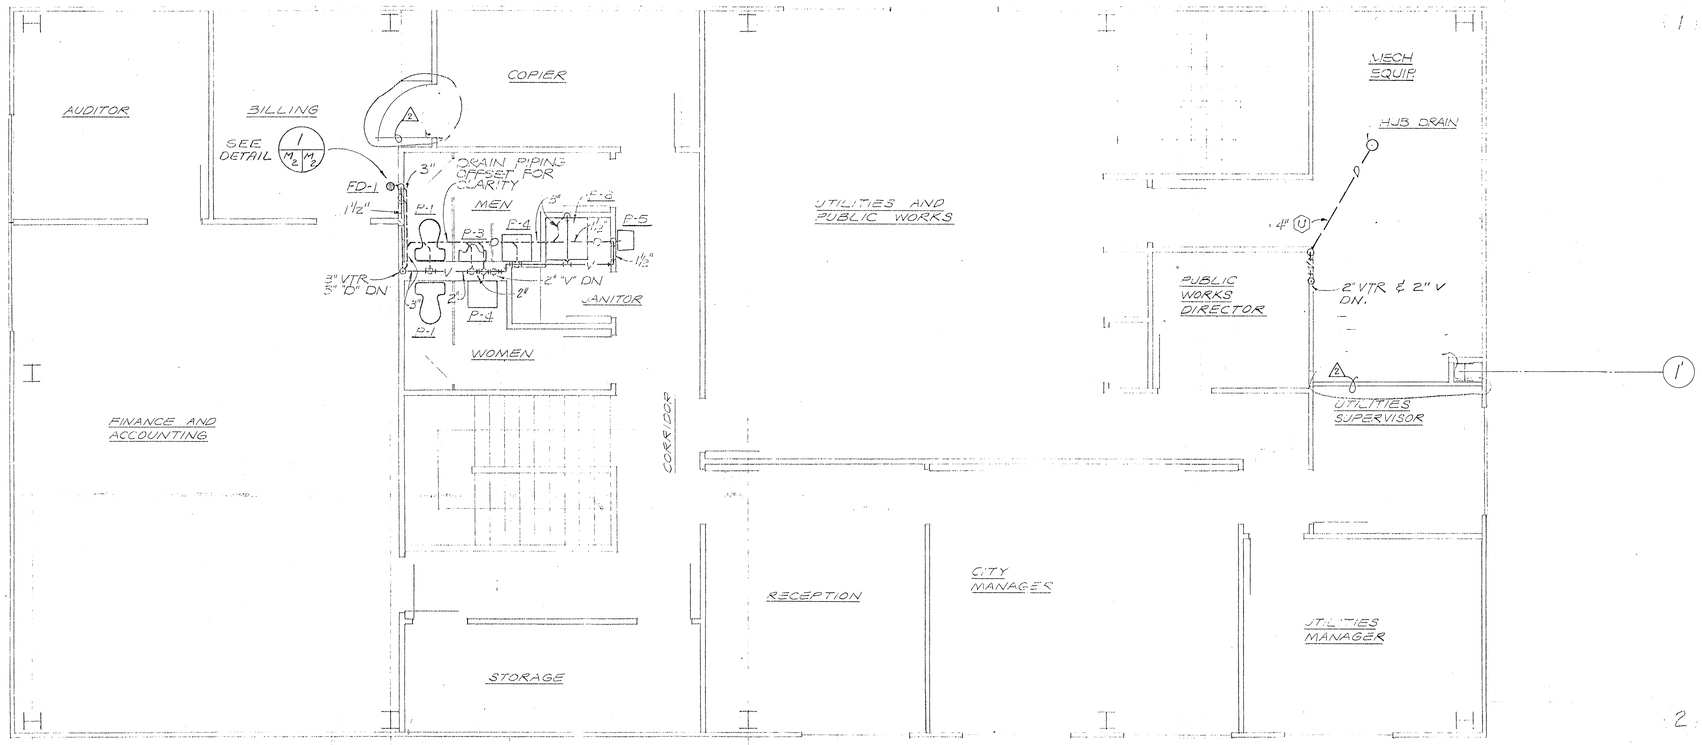

PLUMBING PLAN

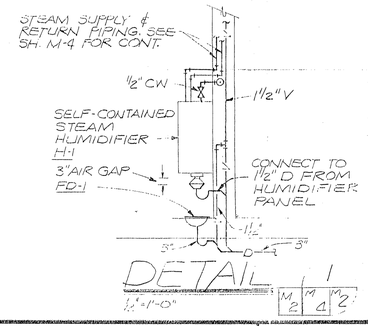

DETAIL 1/M2 M4 M2

1/4"=1'-0"

AS BUILT
DATE JAN 2 7 1977

STATE OF ALASKA 49TH
ALAN L. HUMMONT No. 1116-E
REGISTERED PROFESSIONAL ENGINEER

CH2M HILL

DES. JDH					
DR. JDH	2	12-15-76	AS BUILT	GLB	
CHK. WAK/JWR	1	2-6-76	MISCELLANEOUS REVISIONS	WAK	JJP
APPD. ALH	NO.	DATE	REVISION	BY	APPD.

SECOND FLOOR PLAN 1/4" = 1'-0" AND DETAILS

BASIC BID NO. 1 ALTERNATIVE "C"

CITY HALL FOR NOME, ALASKA

SHEET OF 72 M-2
PROJ. NO. K-7327.1
DATE 1 JUN 75
DWG. NO.

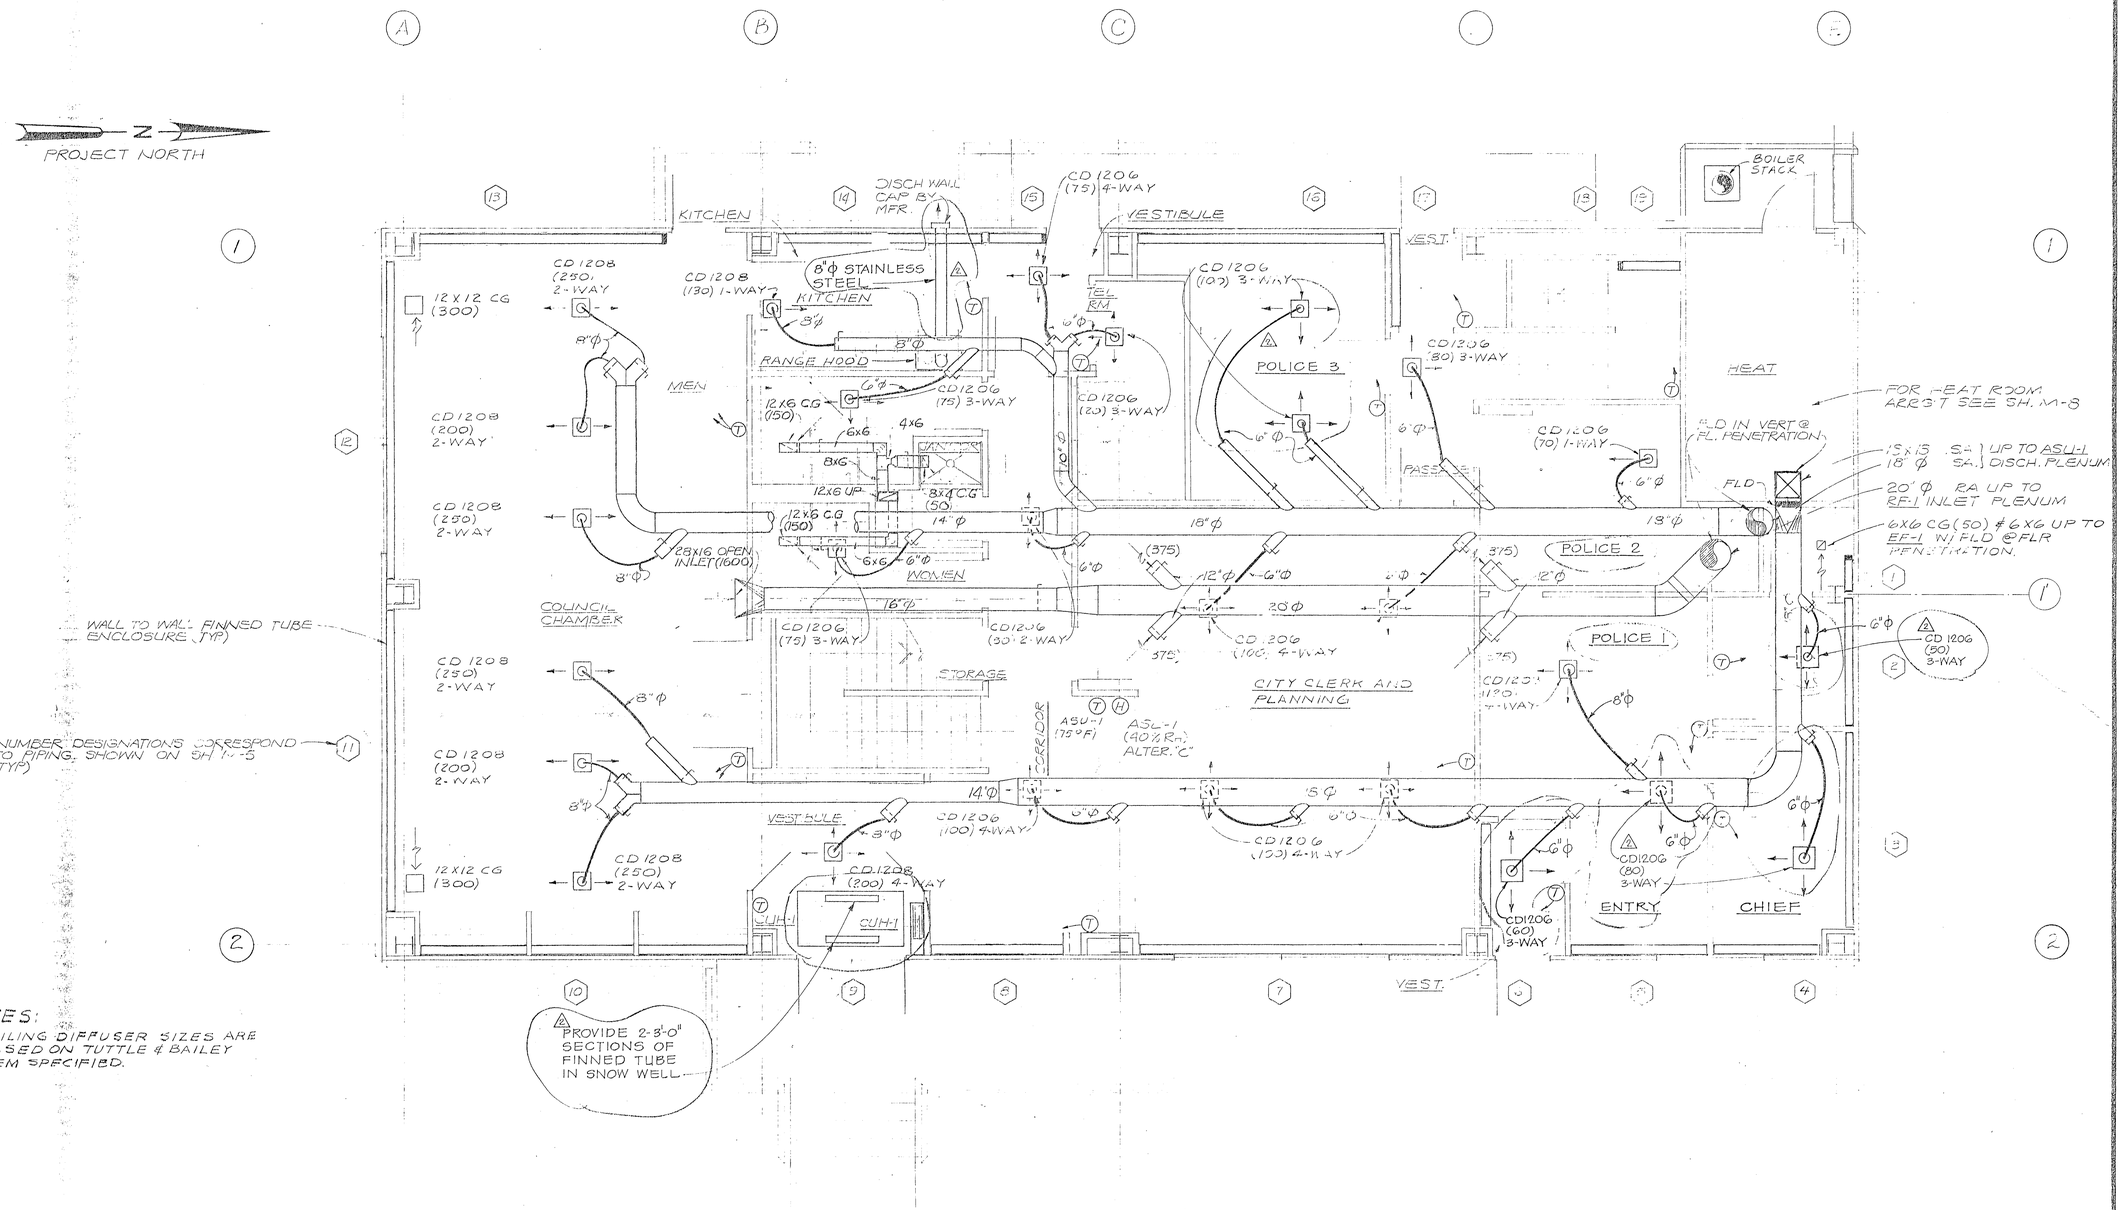

NOTES:

1. CEILING DIFFUSER SIZES ARE BASED ON TUTTLE & BAILEY ITEM SPECIFIED.

HEATING AND VENTILATING

AS BUILT
DATE JAN 27 1977

DES. K/NLN					
DR. SCH/SDG					
CHK MK/NLN					
APP M-H					
			WAK	JJP	
	REVISION		BY	APPD.	

FIRST FLOOR PLAN 1/4"=1'-0"

BASIC BID NO. 1
ALTERNATIVE A, 'B', & 'C'

CITY HALL FOR
NOME, ALASKA

SHEET OF 13 M-3
PROJ. NO. K9327.1
DATE JAN 75
DWG. NO.

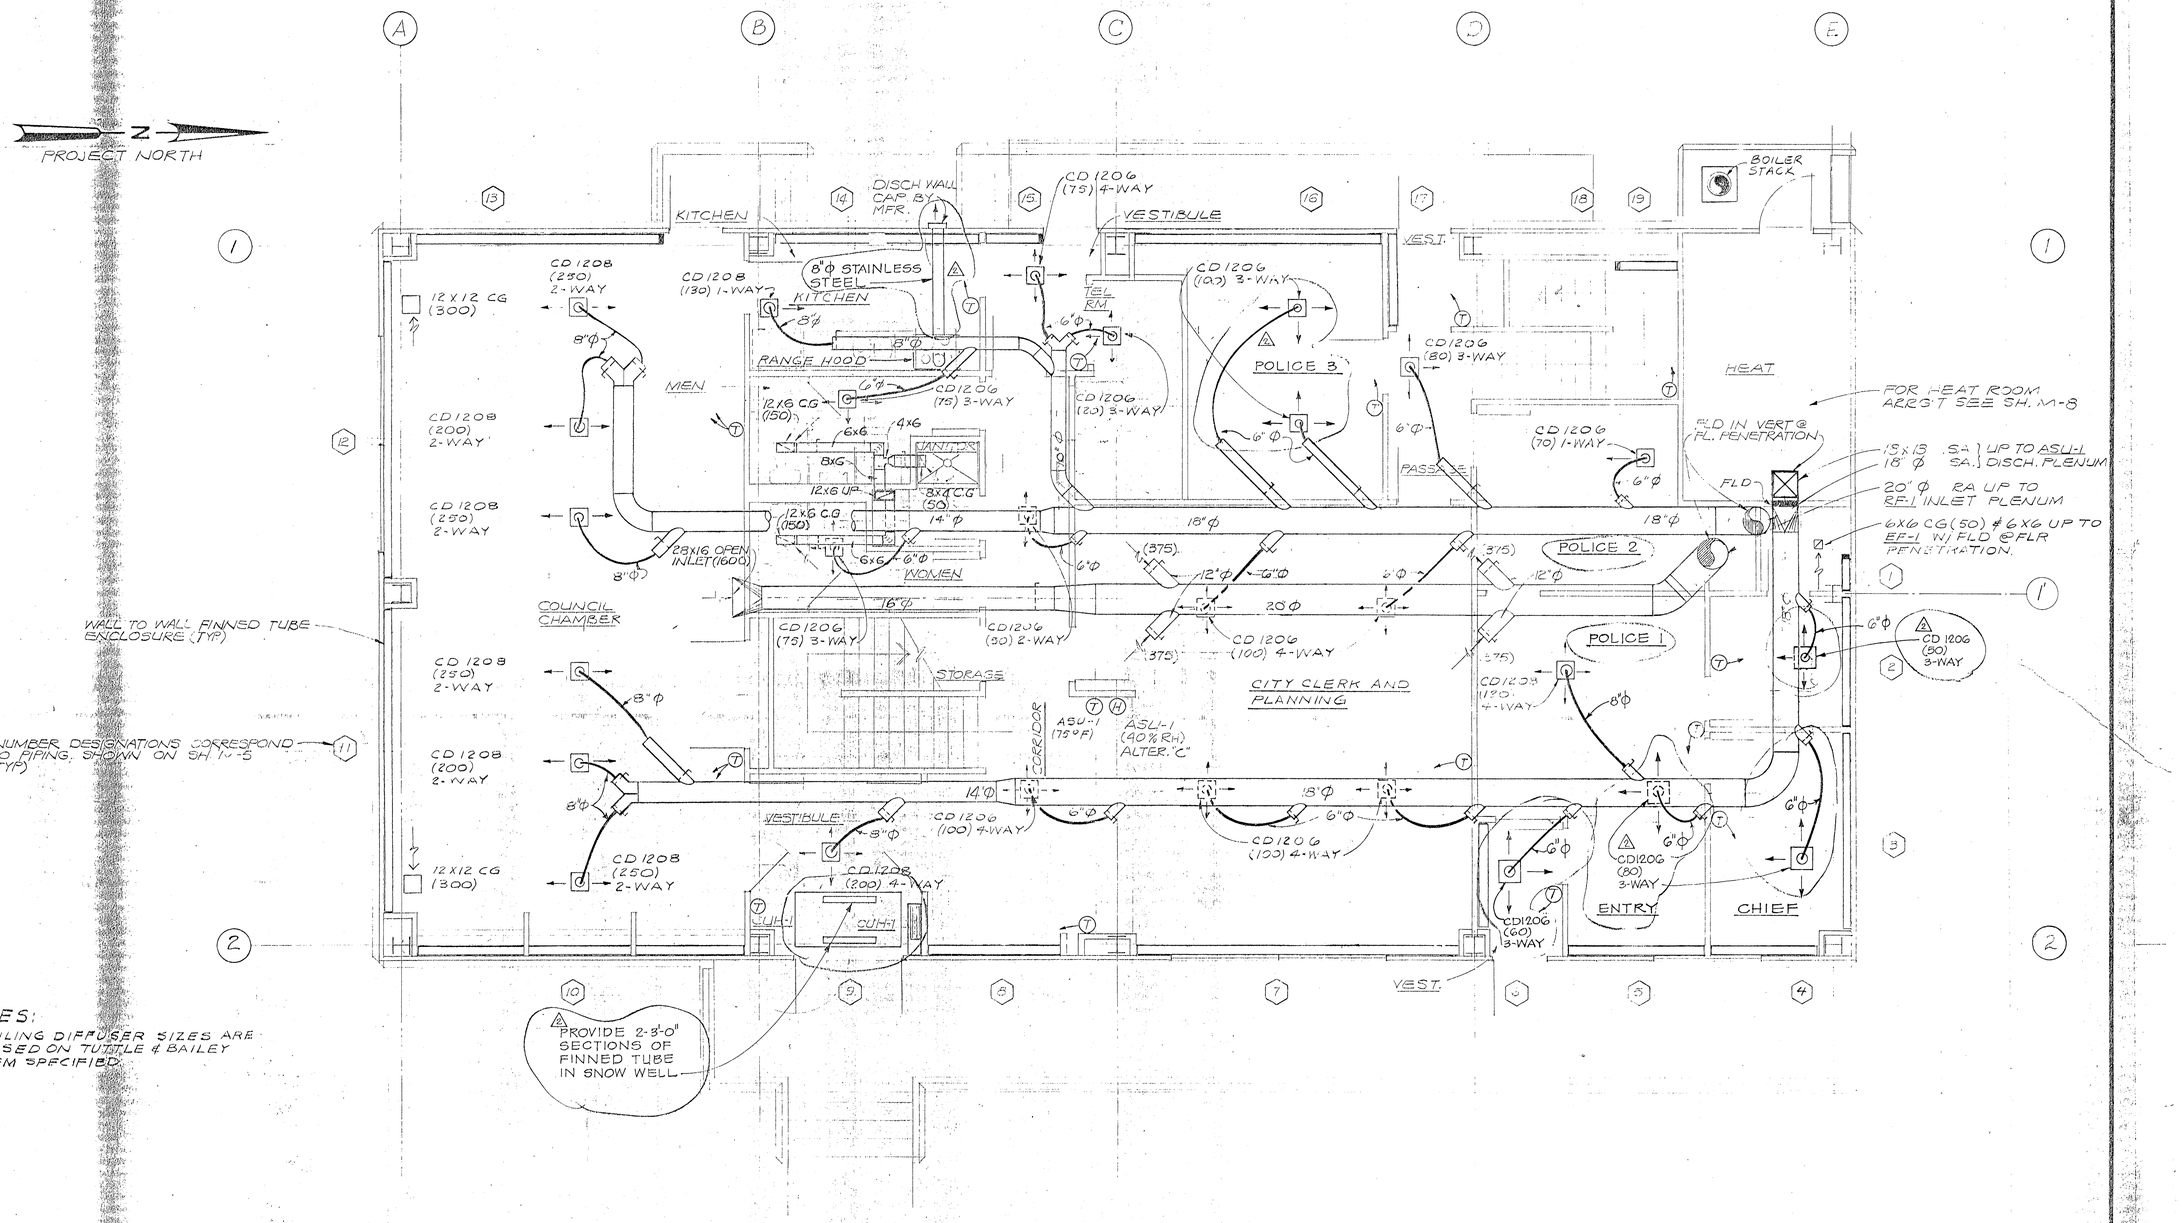

NOTES:

1. CEILING DIFFUSER SIZES ARE BASED ON TUTTLE & BAILEY ITEM SPECIFIED.

HEATING AND VENTILATING

AS BUILT
DATE JAN 27 1977

STATE OF ALASKA
ALAN C. HURNGUTT
No. 1110-E
REGISTERED PROFESSIONAL ENGINEER

CH2M HILL

DES. WAK/NLN				
DR. NDH/SOG				
CHK. WAK/NLN	2	12-15-76	AS BUILT	WAK
APPD. ALH	1	2-6-76	MISCELLANEOUS REVISIONS	WAK JJP
	NO.	DATE	REVISION	BY APPD.

FIRST FLOOR PLAN 1/4"=1'-0"

BASIC BID NO. 1
ALTERNATIVE "A", "B", & "C"

CITY HALL FOR NOME, ALASKA

SHEET OF M-3
PROJ. NO. K9327.1
DATE
DWG. NO.

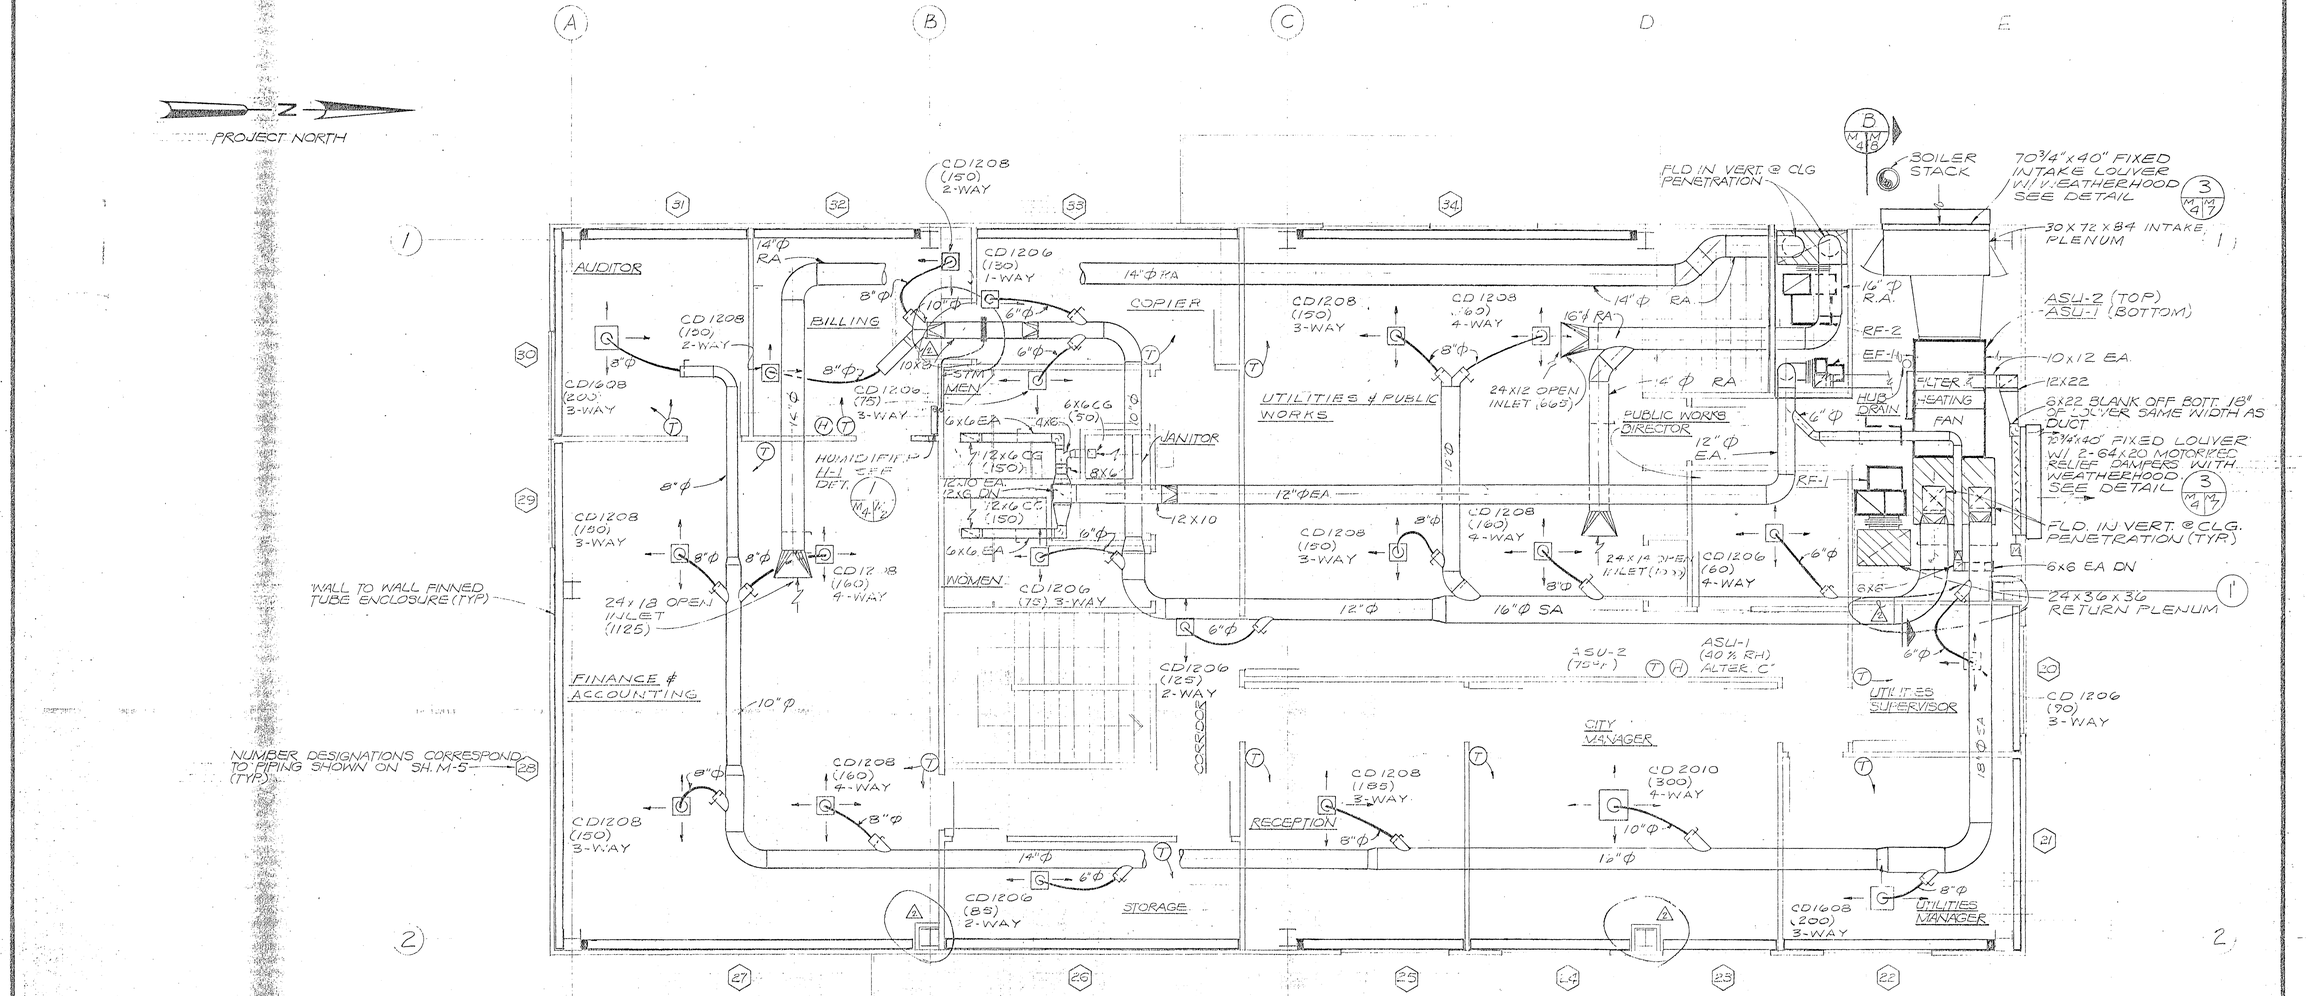

NOTES:

1. CEILING DIFFUSER SIZES ARE BASED ON TUTTLE & BAILEY ITEMS SPECIFIED.

△ HEATING & VENTILATING

AS BUILT
DATE JAN 2 7 1977

STATE OF ALASKA 49TH
ALAN L. HUNNICUTT No. 1119-E
REGISTERED PROFESSIONAL ENGINEER

CH2M HILL

NO.		BY	APPD.
△	12-15-76 AS BUILT	BJB	
△	2-4-77 MISCELLANEOUS REVISIONS	WAK	JJP

DES. WAK/NLN
DR. JDH/SDG
CHK. WAK/NLN
APPD. ALH

SECOND FLOOR PLAN 1/4"=1'-0"

BASIC BID NO. 1
ALTERNATIVE "C"

CITY HALL FOR NOME, ALASKA

SHEET OF 13 M-4
PROJ. NO. K9327.1
DATE JUN 75
DWG. NO.

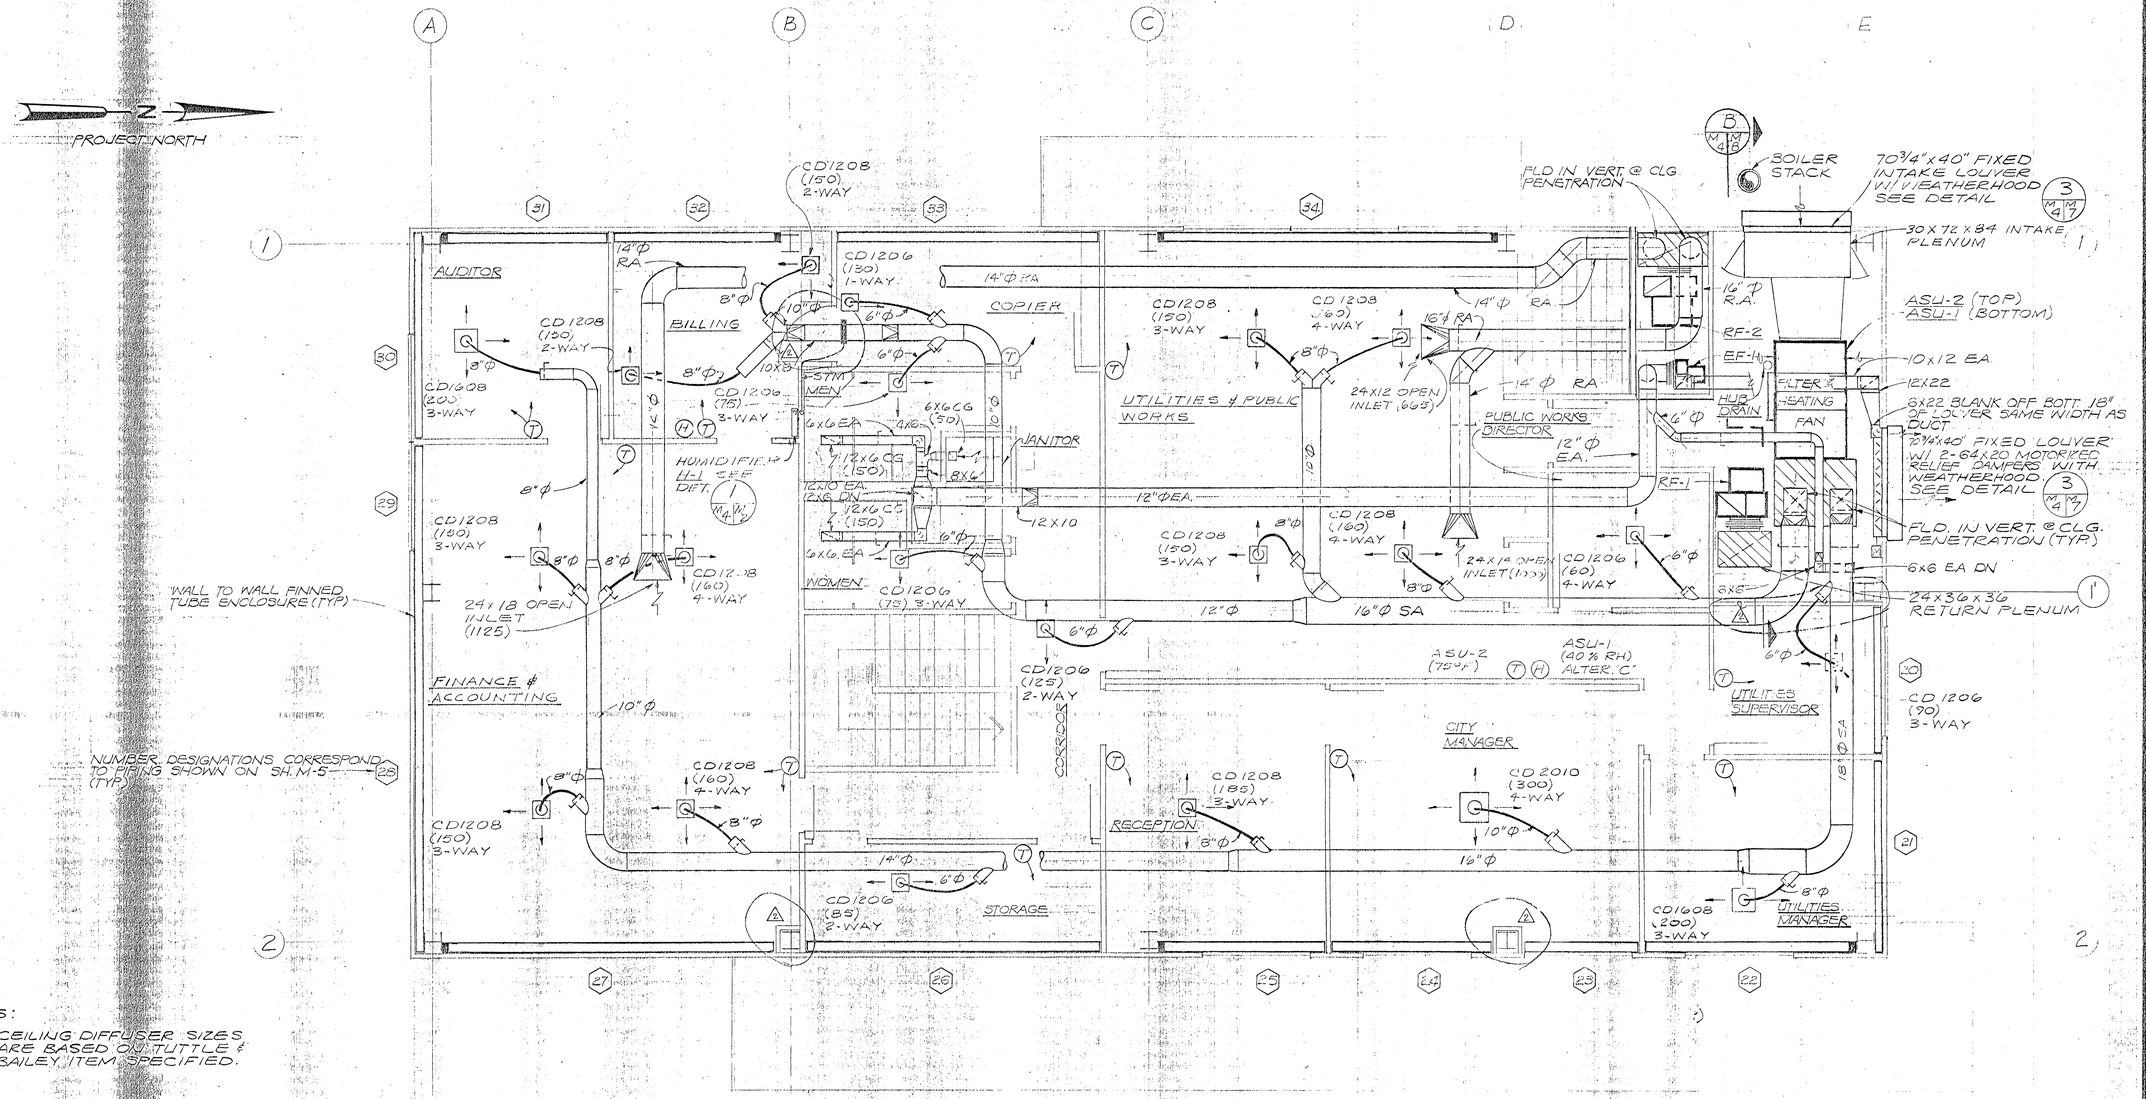

NOTES:

1. CEILING DIFFUSER SIZES ARE BASED ON TUTTLE & BAILEY ITEM SPECIFIED.

△ HEATING & VENTILATING

AS BUILT
DATE JAN 27 1977

STATE OF ALASKA 49TH
ALAN L. HUMMCUTT
No. 1119-E
REGISTERED PROFESSIONAL ENGINEER

CH2M HILL

DES. WAK/NLN				
DR. JDH/SDG	△	12-15-76	AS BUILT	BOB
CHK. WAK/NLN	△	2-6-76	MISCELLANEOUS REVISIONS	WAK JJP
APPD. ALH	NO.	DATE	REVISION	BY APPD.

SECOND FLOOR PLAN 1/4" = 1'-0"

BASIC BID NO. 1
ALTERNATIVE "C"

CITY HALL FOR
NOME, ALASKA

SHEET OF 10 M-4
PROJ. NO. K9327.1
DATE 27 JUN 75
DWG. NO.

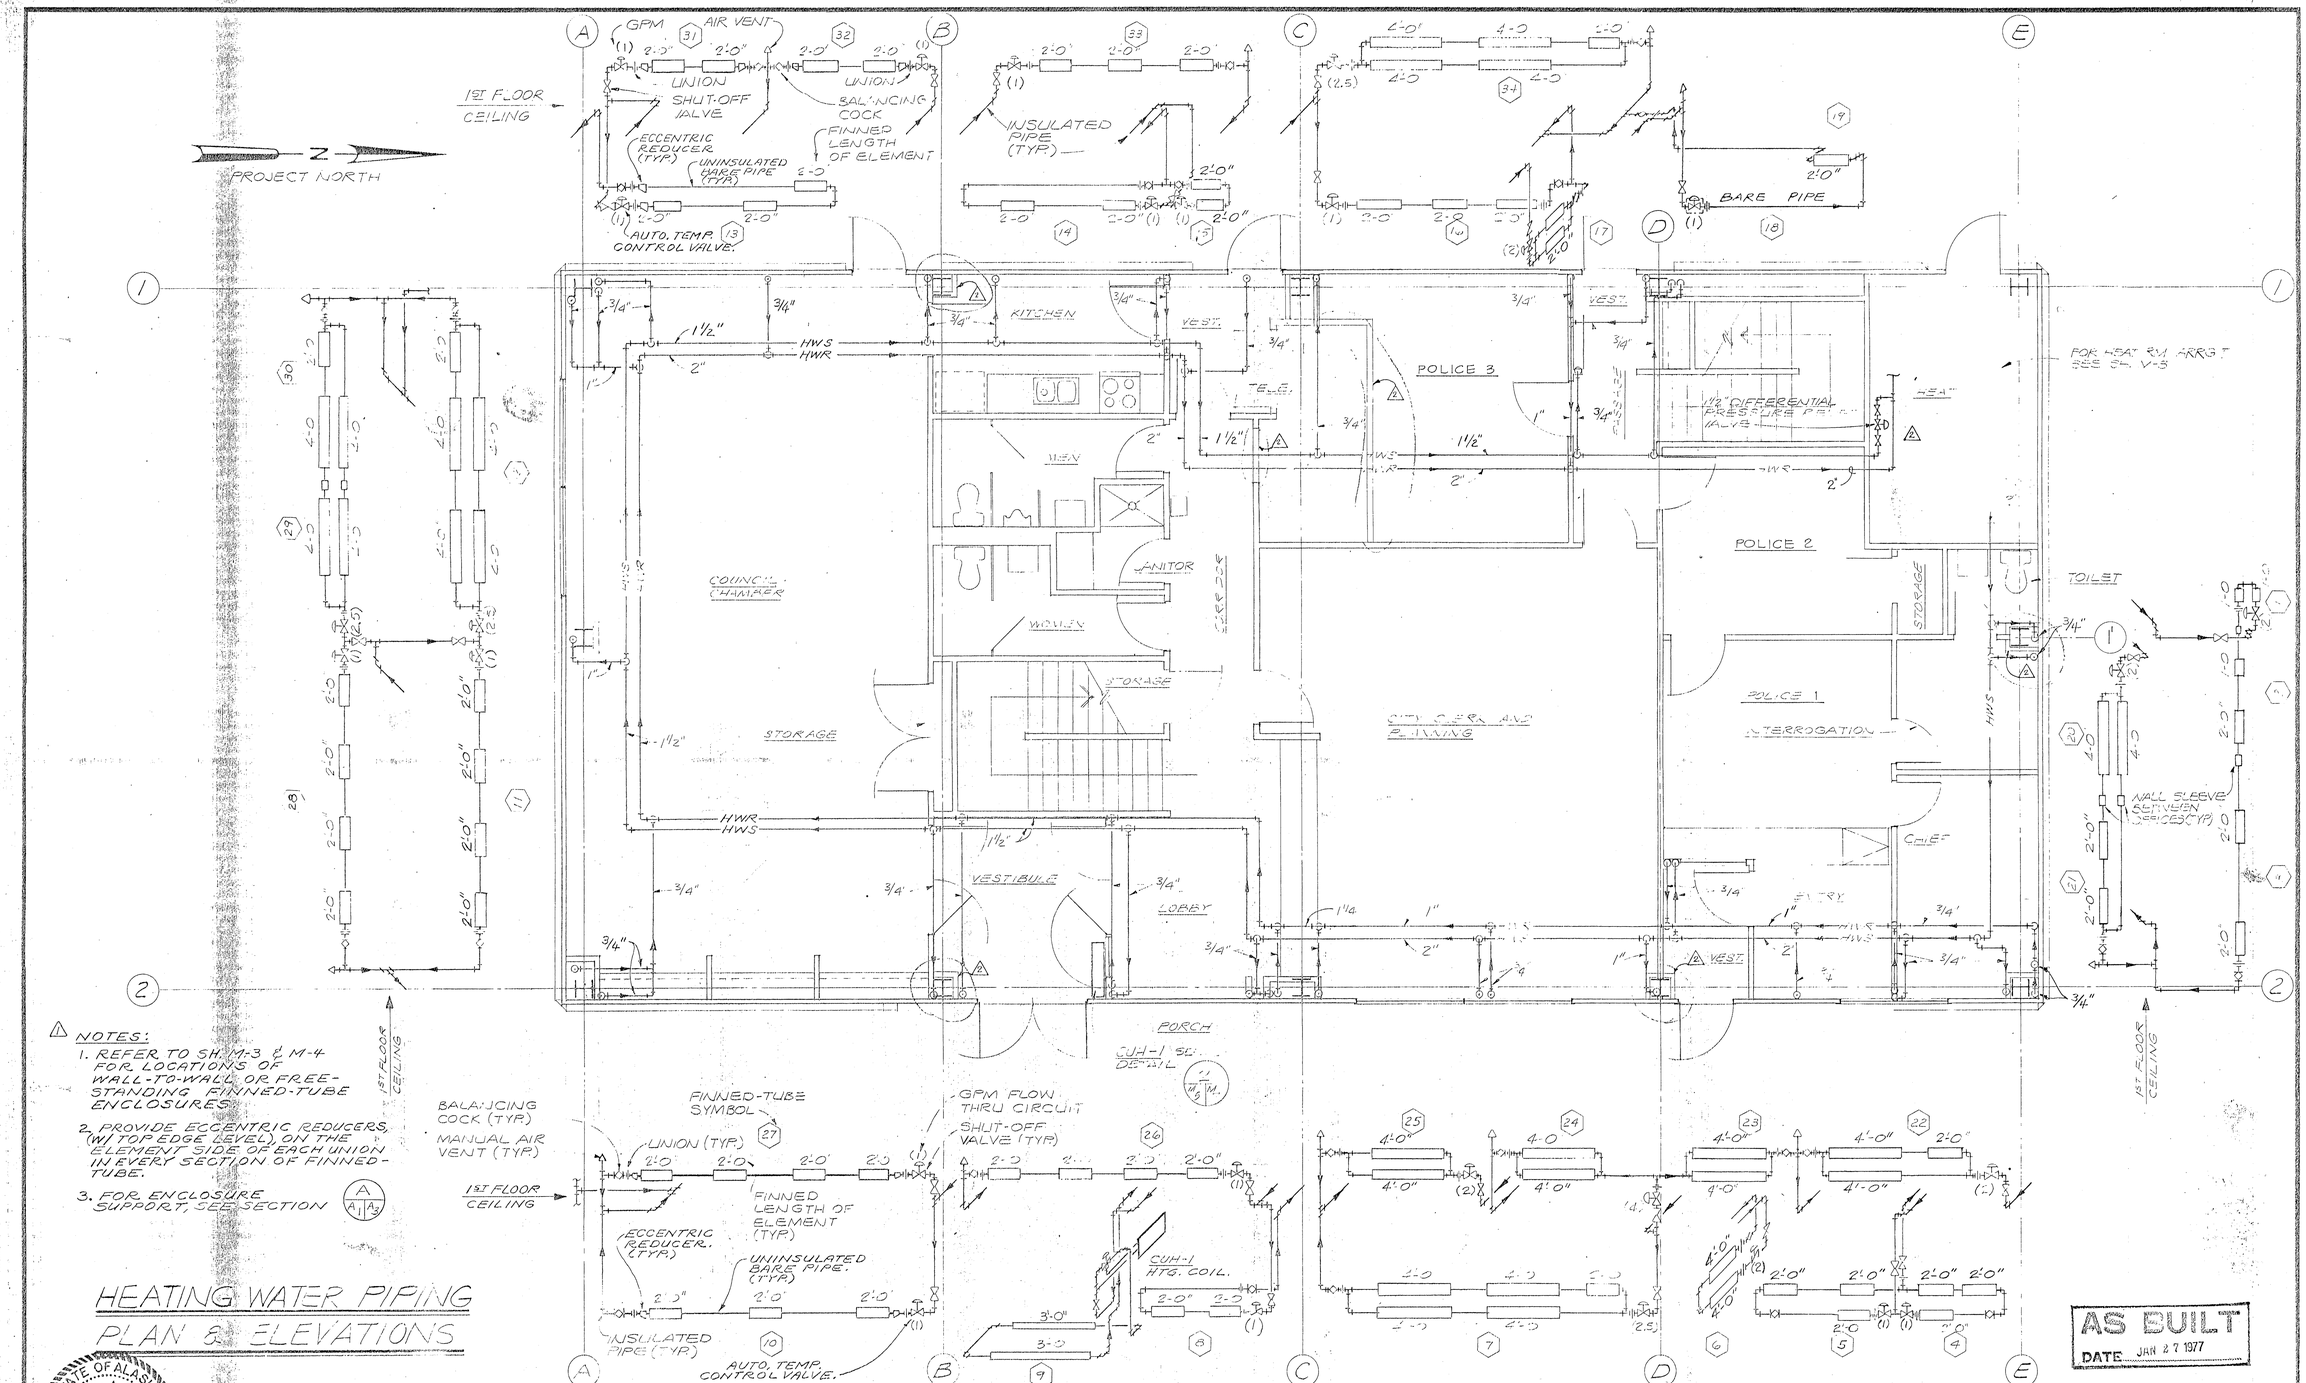

NOTES:

1. REFER TO SH. M-3 & M-4 FOR LOCATIONS OF WALL-TO-WALL OR FREE-STANDING FINNED-TUBE ENCLOSURES.
2. PROVIDE ECCENTRIC REDUCERS, (W/ TOP EDGE LEVEL) ON THE ELEMENT SIDE OF EACH UNION IN EVERY SECTION OF FINNED-TUBE.
3. FOR ENCLOSURE SUPPORT, SEE SECTION A (A1/A2)

HEATING WATER PIPING PLAN & ELEVATIONS

AS BUILT
DATE JAN 27 1977

STATE OF ALASKA 49TH
ADAM C. HAWKSCOTT
No. 1119-E
REGISTERED PROFESSIONAL ENGINEER

CH2M HILL ALASKA

DES. W.A.K				
DR. GAM	15-76	AS BUILT	BJB	
CHK. W.A.K., V.L.N.	6-76	MISCELLANEOUS REVISIONS	WAK	JJP
APPD. A.L.H	NO. DATE	REVISION	BY	APPD.

FIRST FLOOR PLAN 1/4" = 1'-0"

BASIC BID NO.1
ALTERNATIVE B'

CITY HALL FOR
NOME, ALASKA

SHEET OF M-5
PROJ. NO. F-9332
DATE
DWG. NO.

PROJECT NORTH

1ST FLOOR CEILING

GPM (1) 2'-0" AIR VENT (31) 2'-0" 2'-0" (32) 2'-0" 2'-0" (1)
UNION SHUT-OFF VALVE
UNION BALANCING COCK
ECCENTRIC REDUCER (TYP.)
UNINSULATED BARE PIPE (TYP.)
FINNED LENGTH OF ELEMENT
2'-0" (1) 2'-0" 2'-0" (13) AUTO. TEMP. CONTROL VALVE.

(33) 2'-0" 2'-0" 2'-0" (1)
INSULATED PIPE (TYP.)
2'-0" 2'-0" (1) (1) 2'-0" (14) (15)

4'-0" 4'-0" 4'-0" (2.5) 4'-0" (34) 4'-0" (1) 2'-0" (16) 2'-0" (2) 2'-0" (17)
(19) 2'-0" BARE PIPE (1) (18)

(30) 4'-0" 2'-0" 4'-0" 2'-0" (29) 4'-0" 2'-0" 4'-0" 2'-0" (28) 2'-0" 2'-0" 2'-0" 2'-0" (1) (2.5) (1) (2.5)

KITCHEN
VEST.
MEN
WOMEN
JANITOR
COUNCIL CHAMBER
STORAGE
CORRIDOR
STORAGE
VESTIBULE
LOBBY
CITY CLERK AND PLANNING
POLICE 3
VEST.
1/2" DIFFERENTIAL PRESSURE REL... VALVE
HEAT
POLICE 2
STORAGE
TOILET
POLICE 1
INTERROGATION
CHIEF
ENTRY
VEST.
FOR HEAT EXCH. SEE SH. M-8
WALL SLEEVE BETWEEN SERIES (TYP.)
PORCH
CUH-1 SEE DETAIL 1/2 M4

3/4" 1 1/2" 2" HWS HWR 1" 1 1/4" 1 1/2"

NOTES:
1. REFER TO SH. M-3 & M-4 FOR LOCATIONS OF WALL-TO-WALL OR FREE-STANDING FINNED-TUBE ENCLOSURES.
2. PROVIDE ECCENTRIC REDUCERS, (W/ TOP EDGE LEVEL) ON THE ELEMENT SIDE OF EACH UNION IN EVERY SECTION OF FINNED-TUBE.
3. FOR ENCLOSURE SUPPORT, SEE SECTION (A / A1 A2)

1ST FLOOR CEILING
BALANCING COCK (TYP.)
MANUAL AIR VENT (TYP.)
FINNED-TUBE SYMBOL
UNION (TYP.) (27) 2'-0" 2'-0" 2'-0" 2'-0" (1) (26) 2'-0" 2'-0" 2'-0" 2'-0" (1)
GPM FLOW THRU CIRCUIT
SHUT-OFF VALVE (TYP.)
ECCENTRIC REDUCER. (TYP.)
FINNED LENGTH OF ELEMENT (TYP.)
UNINSULATED BARE PIPE. (TYP.)
2'-0" 2'-0" 2'-0" (10) (1) INSULATED PIPE (TYP.)
3'-0" (9) CUH-1 HTG. COIL. 3'-0" 2'-0" (1) (8)
AUTO. TEMP. CONTROL VALVE.

(25) 4'-0" 4'-0" (24) 4'-0" (2) 4'-0" (23) 4'-0" (4) 4'-0" (22) 4'-0" 2'-0" (2)
4'-0" 4'-0" 4'-0" (2.5) (7) 4'-0" (6) 4'-0" 2'-0" 2'-0" 2'-0" 2'-0" (2) (1) (1) (5) (4)

HEATING WATER PIPING PLAN & ELEVATIONS

AS BUILT DATE JAN 27 1977

STATE OF ALASKA 49TH ALAN L. HUNNICUTT No. 1119-E REGISTERED PROFESSIONAL ENGINEER

CH2M HILL

NO.	DATE	REVISION	BY	APPD.
3	12-15-76	AS BUILT	BJB	
2	2-6-76	MISCELLANEOUS REVISIONS	WAK	JJP

DES. WAK
DR. GAM
CHK. WAK, ALN
APPD. ALH

FIRST FLOOR PLAN 1/4" = 1'-0"

BASIC BID NO. 1
ALTERNATIVE 'B'

CITY HALL FOR NOME, ALASKA

SHEET OF M-5
PROJ. NO. F3327.1
DATE JAN '75
DWG. NO.

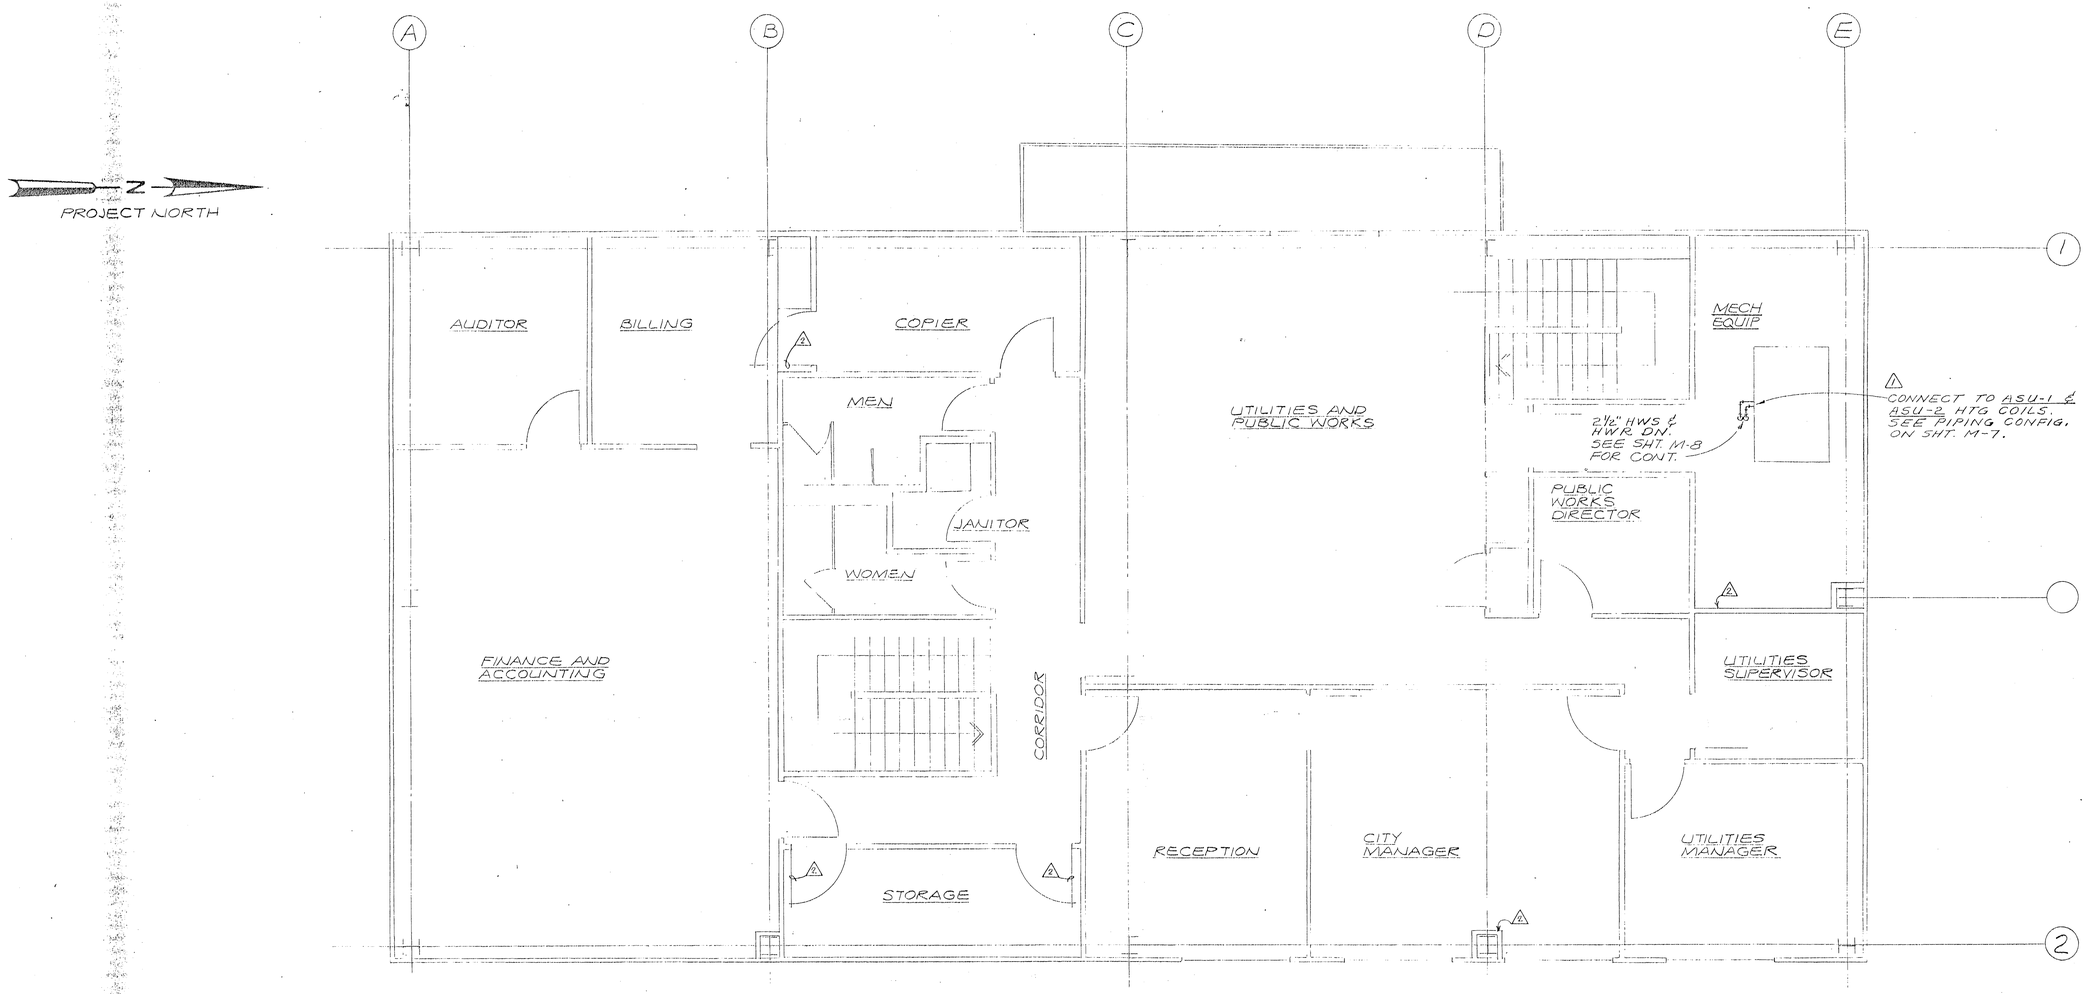

HEATING WATER PIPING PLAN

AS BUILT
DATE JAN 27 1977

STATE OF ALASKA — 49TH

CH2M HILL

NAK					
JDH	2	12-15-76			
WAK/NLN	1	2-6-76	REVISIONS	WAK	JJP
ALH	NO.	DATE		BY	APPD.

SECOND FLOOR PLAN 1/4"=1'-0"

BASIC BID NO.1

CITY HALL FOR NOME, ALASKA

SHEET OF 10 M-6
PROJ. NO. K9337.1
DATE 27 JUN 75
DWG. NO.

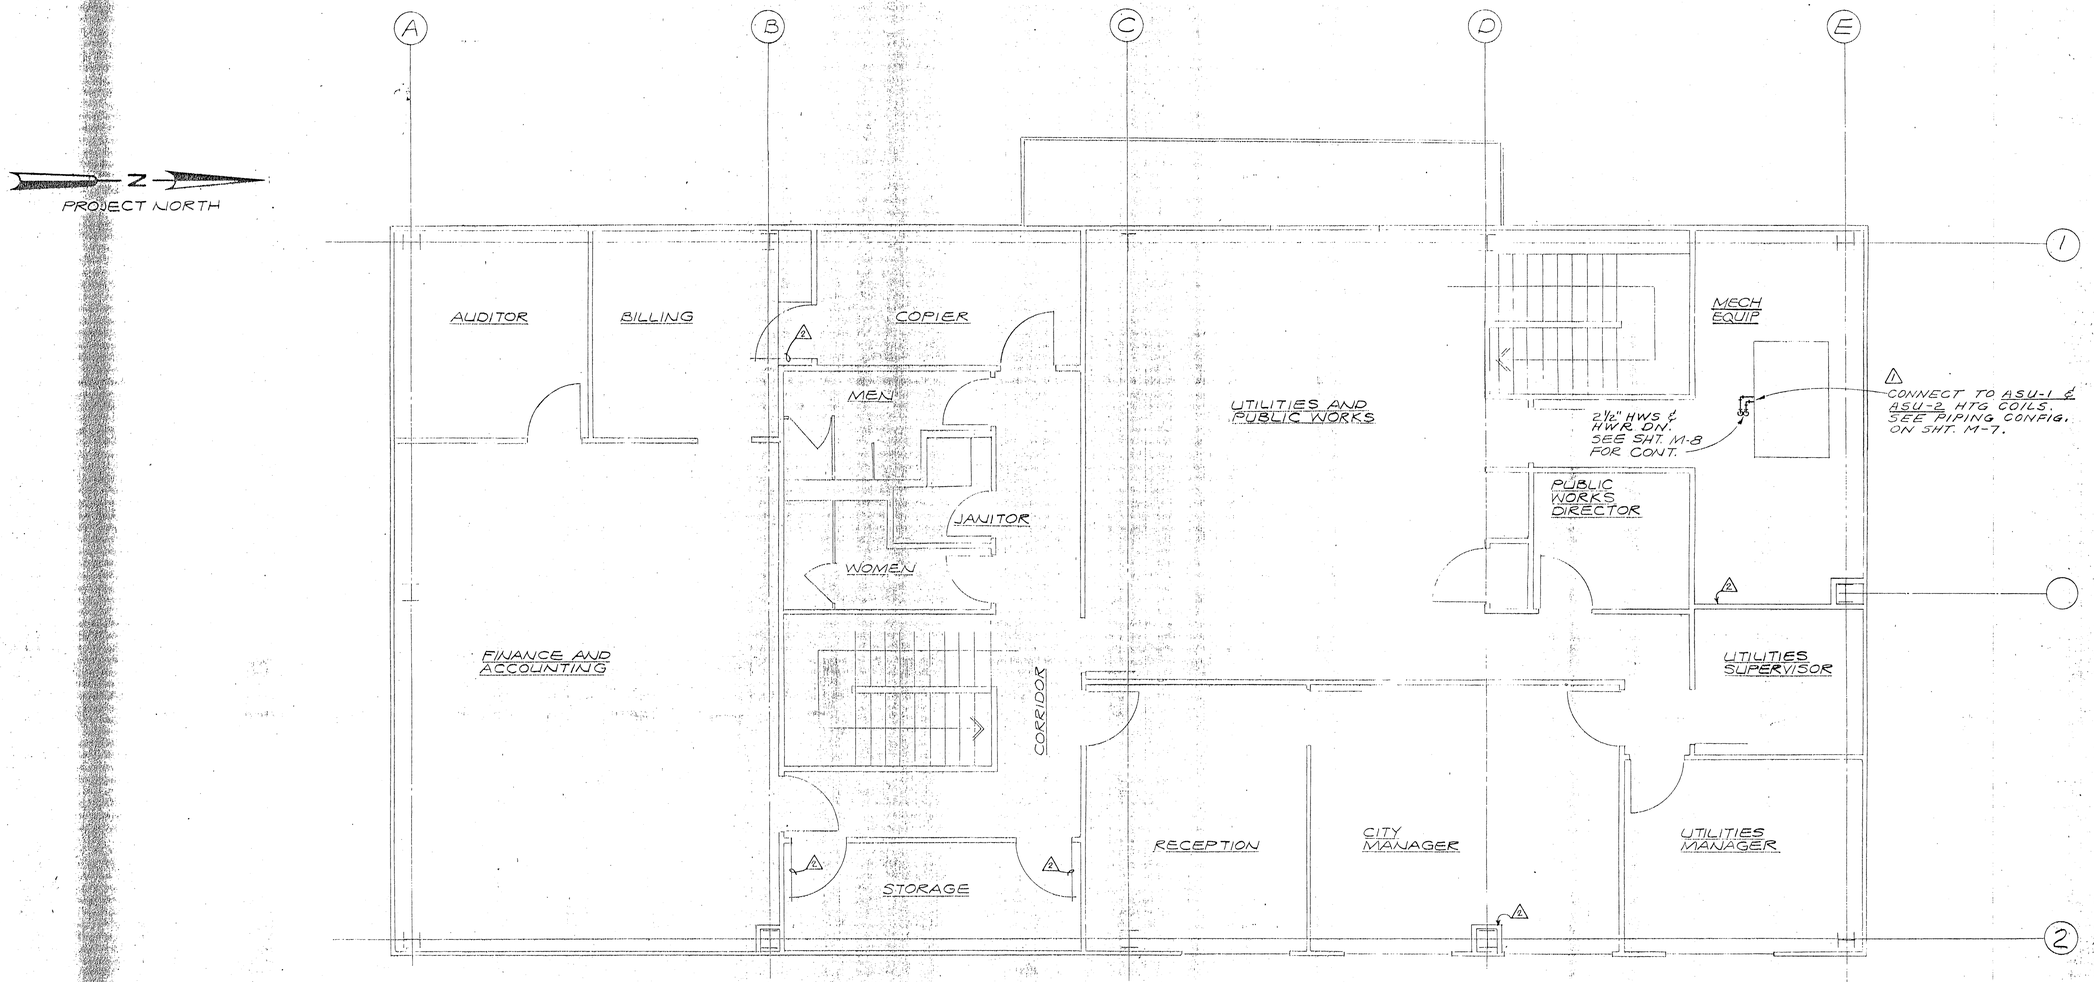

HEATING WATER PIPING PLAN

AS BUILT
DATE JAN 27 1977

STATE OF ALASKA — 49TH — REGISTERED PROFESSIONAL ENGINEER — No. 1116-E

CH2M HILL

DES. WAK						SECOND FLOOR PLAN 1/4"=1'-0"
DR. NDH						
CHK. WAK/NLN	2	12-15-76	AS BUILT	Mab		
APPD. ALH	1	2-6-76	MISCELLANEOUS REVISIONS	WAK	JJP	
	NO.	DATE	REVISION	BY	APPD.	

BASIC BID NO. 1

CITY HALL FOR NOME, ALASKA

SHEET OF 10 M-6
PROJ. NO. K9327.1
DATE 27 JUN. 75
DWG. NO.

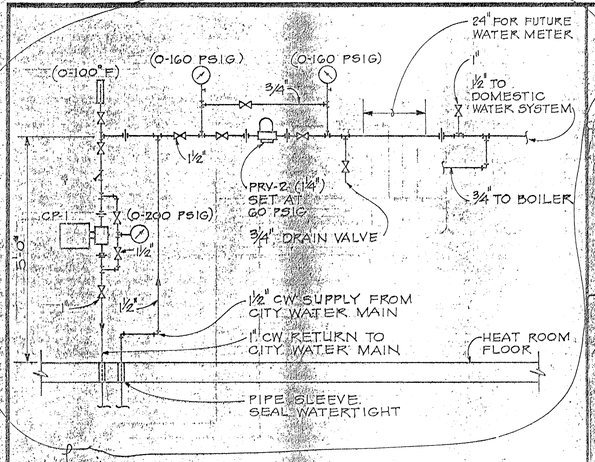

⚠ WATER HEADER DETAIL

N.T.S. (1 / M1 M7)

MECHANICAL LEGEND

PIPING:

- D — DRAIN (BUILDING SEWER)
- V — VENT
- HW — HOT WATER
- HWS — HEATING WATER SUPPLY
- HWR — HEATING WATER RETURN
- FOS — FUEL OIL SUPPLY
- FOR — FUEL OIL RETURN
- CW — COLD WATER

VALVES AND MISCELLANEOUS PIPING ITEMS:

- GATE VALVE
- GLOBE VALVE
- CHECK VALVE
- DIAPHRAGM CONTROL VALVE
- SOLENOID VALVE
- PRESSURE RELIEF VALVE
- MANUAL AIR VENT
- BALANCE FITTING
- HOSE VALVE (TYPE AS SPECIFIED)
- UNION
- (PSIG SCALE) GAUGE WITH COCK
- (°F SCALE) THERMOMETER
- STRAINER
- (C) PIPING IN CEILING SPACE
- (U) PIPING UNDER FLOOR

DUCTWORK

- CEILING DIFFUSER (SUPPLY)
- CEILING GRILLE (RETURN & EXHAUST)
- TURNING VANES
- SOUND ATTENUATED DUCT
- FUSIBLE LINK FIRE DAMPER
- SPLITTER DAMPER
- MANUAL BUTTERFLY VOLUME DAMPER
- MOTORIZED DAMPER
- CANVAS CONNECTION
- SUPPLY DUCT (SECTION)
- RETURN OR EXHAUST DUCT (SECTION)
- (T) THERMOSTAT
- (H) HUMIDISTAT
- (125) CFM AIR

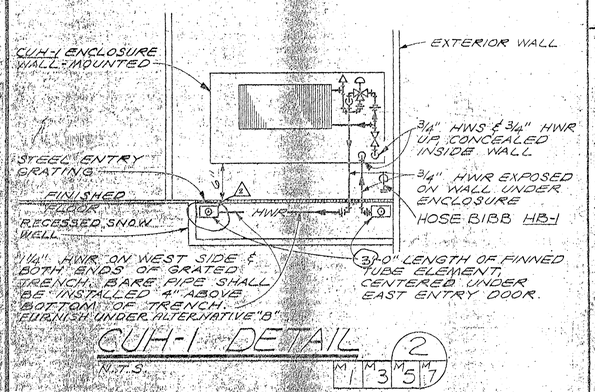

CUH-1 DETAIL

N.T.S. (2 / M1 M3 M5 M7)

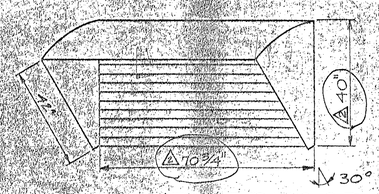

WEATHERHOOD DETAIL

N.T.S. (3 / M4 M8 M7)

ABBREVIATIONS

DN	DOWN	RA	RETURN AIR
FCO	FLOOR CLEANOUT	EA	EXHAUST AIR
NTS	NOT TO SCALE	OSA	OUTSIDE AIR
VTR	VENT THRU ROOF	NC	NORMALLY CLOSED
SA	SUPPLY AIR	NO	NORMALLY OPEN
DCO	DECK CLEANOUT	C	COMMON

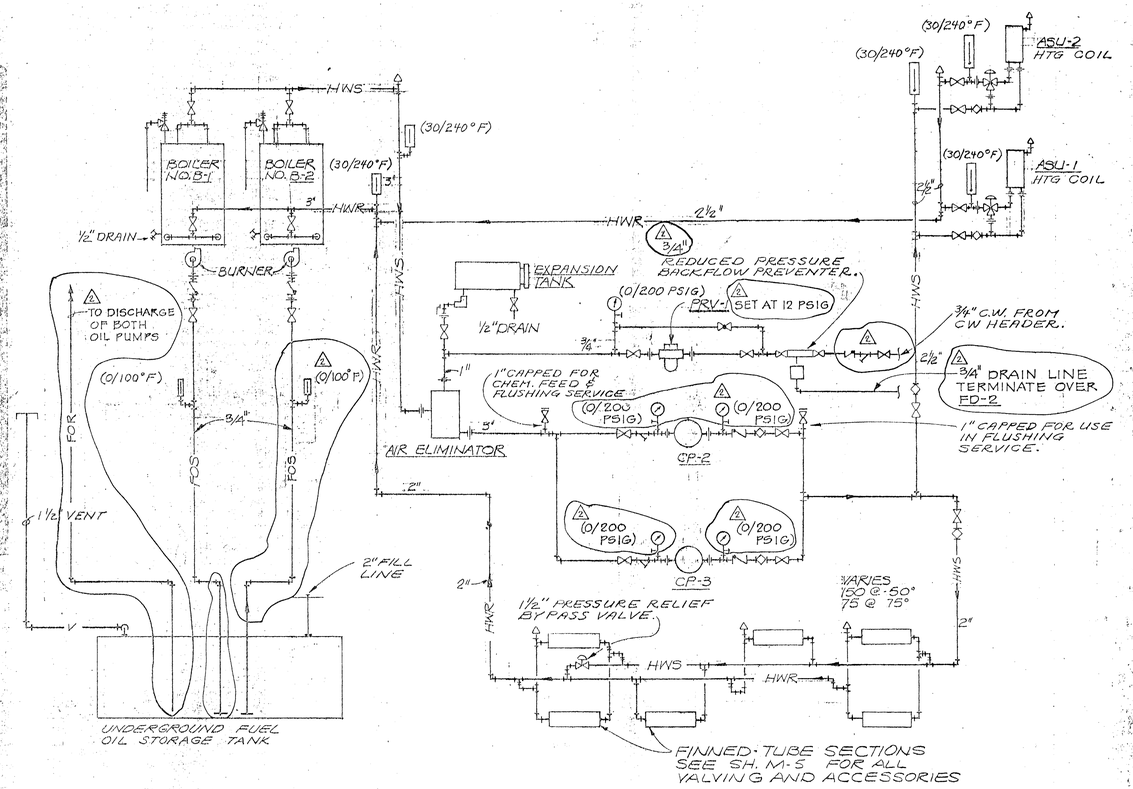

⚠ HEATING SYSTEM PIPING SCHEMATIC

N.T.S.

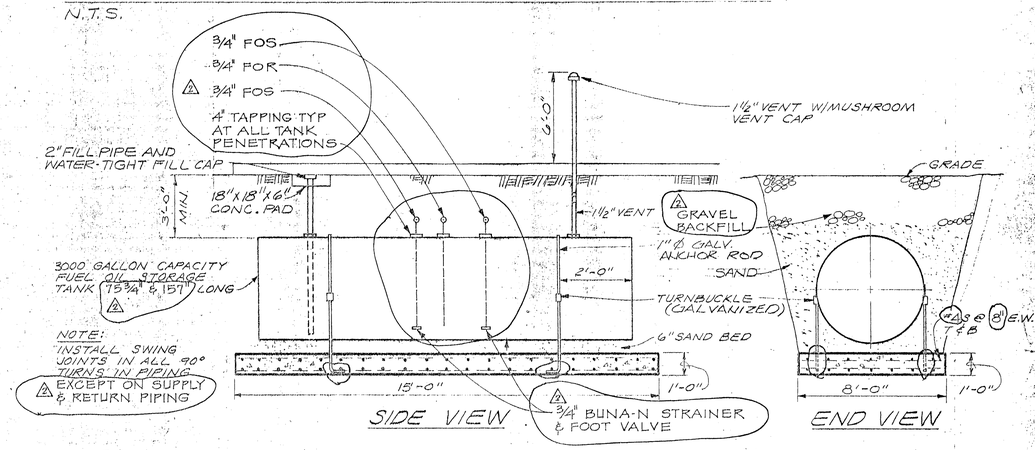

AS BUILT
DATE JAN 27 1977

UNDERGROUND FUEL OIL STORAGE TANK

N.T.S. (ALTERNATIVE E) (4 / C2 M7)

STATE OF ALASKA — 49TH

CH2M HILL

DES. WAK
DR. GAM
CHK. WAK/JWR
APPD. ALH

NO.	DATE	REVISION	BY	APPD.
⚠	12-15-76	AS BUILT	BLB.	
⚠	2-6-76	MISCELLANEOUS REVISIONS	WAK	JWP

MECHANICAL DETAILS

BASIC BID NO. 1
ALTERNATIVE "B", "C", & "E"

CITY HALL FOR NOME, ALASKA

SHEET OF 10 M-7
PROJ. NO. K9327.1
DATE 27 JUN 75
DWG. NO.

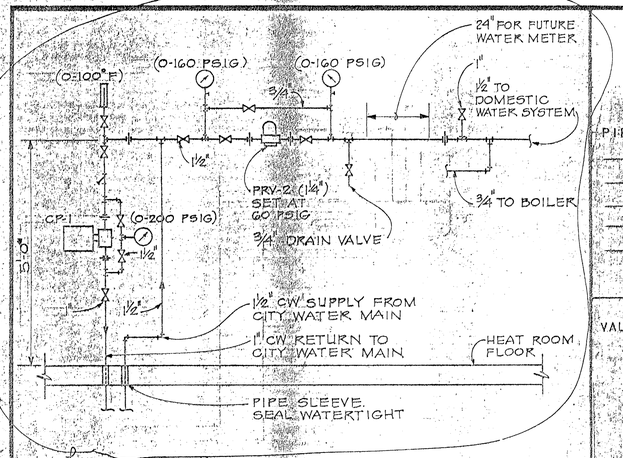

WATER HEADER DETAIL

N.T.S.

M1 M2

MECHANICAL LEGEND

PIPING:

D	DRAIN (BUILDING SEWER)	FOS	FUEL OIL SUPPLY
V	VENT	FOR	FUEL OIL RETURN
HW	HOT WATER	CW	COLD WATER
HWS	HEATING WATER SUPPLY		
HWR	HEATING WATER RETURN		

VALVES AND MISCELLANEOUS PIPING ITEMS:

	GATE VALVE		BALANCE FITTING
	GLOBE VALVE		HOSE VALVE (TYPE AS SPECIFIED)
	CHECK VALVE		UNION
	DIAPHRAGM CONTROL VALVE	(P&IG SCALE)	GAUGE WITH COCK
S	SOLENOID VALVE	(°F SCALE)	THERMOMETER
	PRESSURE RELIEF VALVE		STRAINER
	MANUAL AIR VENT	C	PIPING IN CEILING SPACE
		U	PIPING UNDER FLOOR

DUCTWORK

	CEILING DIFFUSER (SUPPLY)	M	MOTORIZED DAMPER
	CEILING GRILLE (RETURN & EXHAUST)		CANVAS CONNECTION
			SUPPLY DUCT (SECTION)
	TURNING VANES		RETURN OR EXHAUST DUCT (SECTION)
	SOUND ATTENUATED DUCT	T	THERMOSTAT
FSD	FUSIBLE LINK FIRE DAMPER	H	HUMIDISTAT
	SPLITTER DAMPER	(125)	CFM AIR
	MANUAL BUTTERFLY VOLUME DAMPER		

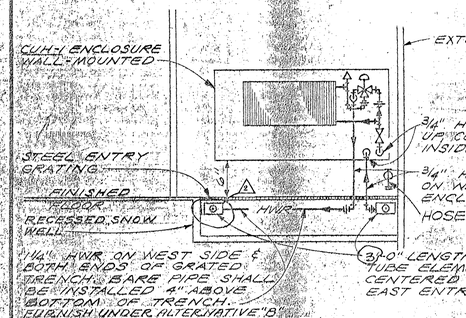

CUH-1 DETAIL

N.T.S.

M1 M3 M5 M7 — 2

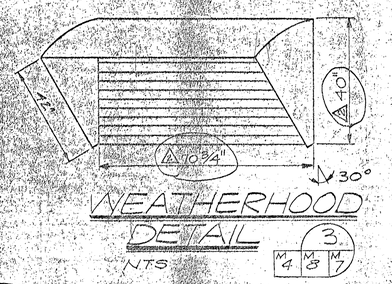

WEATHERHOOD DETAIL

N.T.S.

M4 M8 M7 — 3

ABBREVIATIONS

DN	DOWN	RA	RETURN AIR
FCO	FLOOR CLEANOUT	EA	EXHAUST AIR
NTS	NOT TO SCALE	OSA	OUTSIDE AIR
VTR	VENT THRU ROOF	NC	NORMALLY CLOSED
SA	SUPPLY AIR	NO	NORMALLY OPEN
DCO	DECK CLEANOUT	C	COMMON

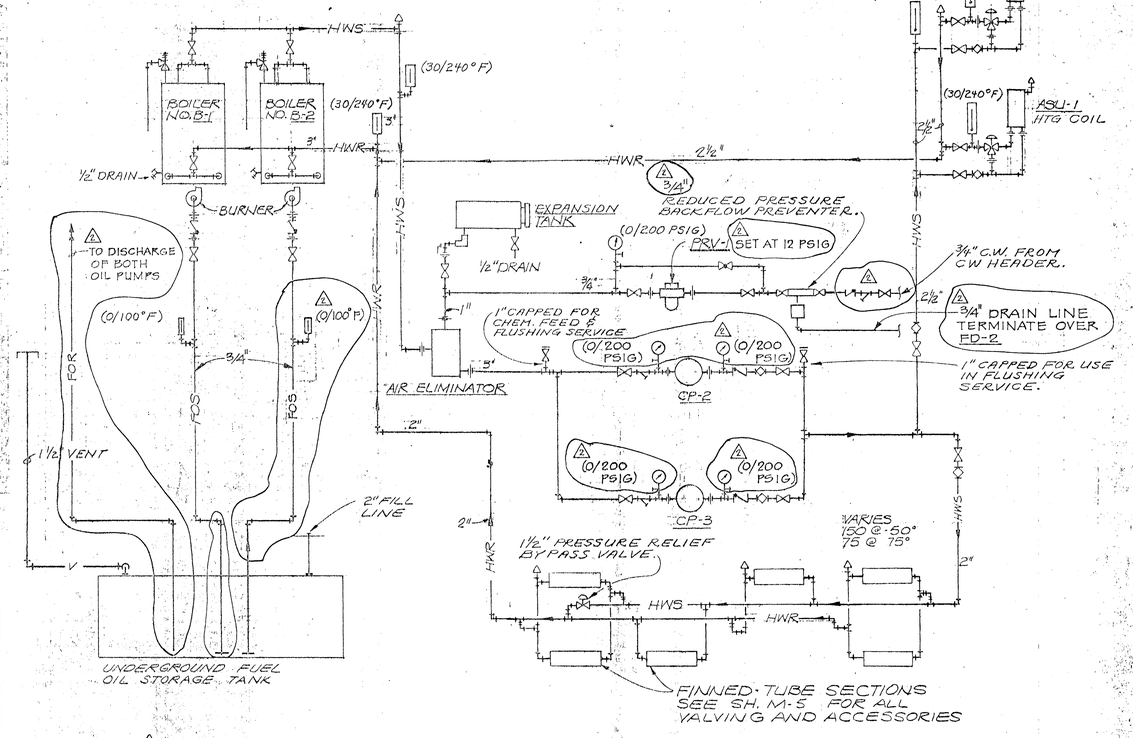

HEATING SYSTEM PIPING SCHEMATIC

N.T.S.

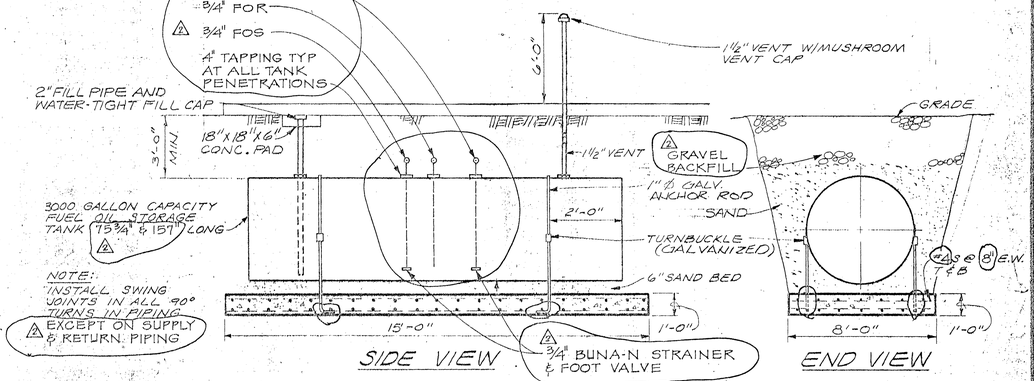

AS BUILT
DATE JAN 27 1977

UNDERGROUND FUEL OIL STORAGE TANK

N.T.S.

(ALTERNATIVE E)

C2 M7 — 4

STATE OF ALASKA — REGISTERED PROFESSIONAL ENGINEER — 4915 — ALBERT L. HOLLOWELL

CH2M HILL ALASKA

DES. WAK
DR. GAM
CHK. WAK/JWR
APPD. ALH

NO.	DATE	REVISION	BY	APPD.
1	12-15-76	AS BUILT	BJB	
2	2-6-76	MISCELLANEOUS REVISIONS	WAK	JJP

MECHANICAL DETAILS

BASIC BID NO. 1
ALTERNATIVE "B", "C", & "E"

CITY HALL FOR
NOME, ALASKA

SHEET OF 10 M-7
PROJ. NO. K9327.1
DATE 27 JUN 75
DWG. NO.

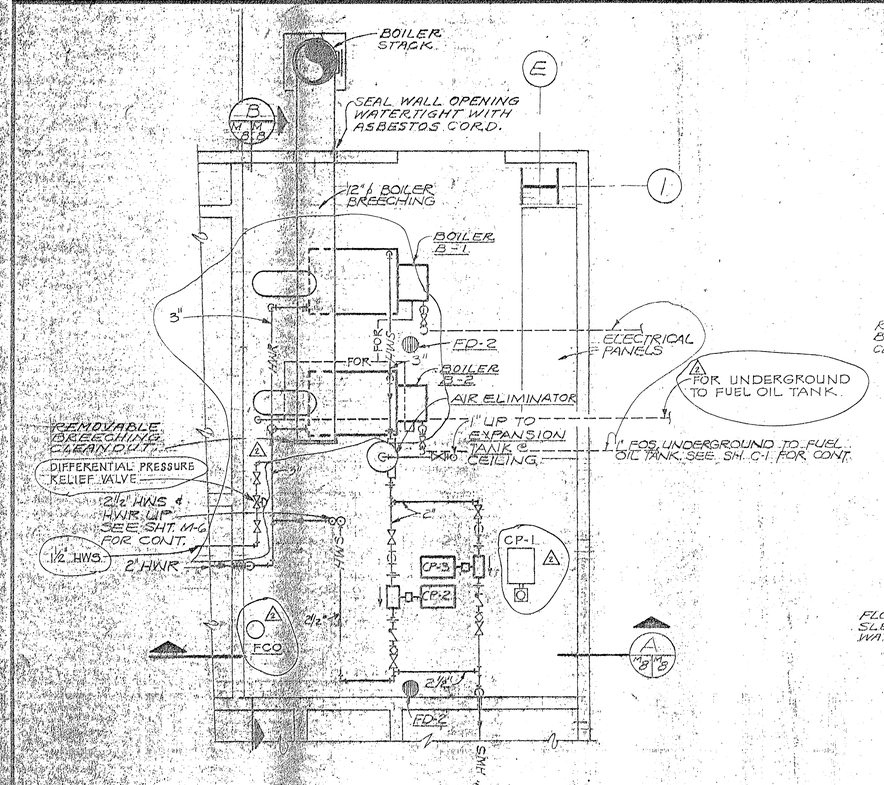

HEAT ROOM PLAN

1/4"=1'-0"

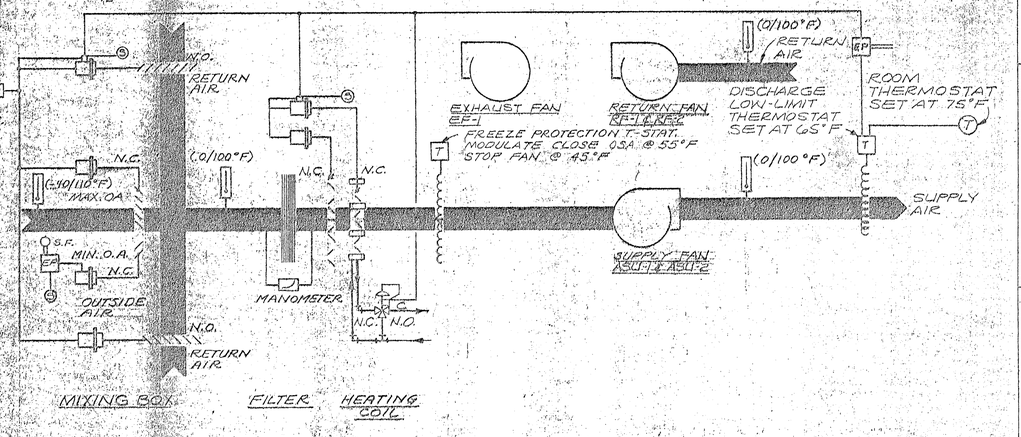

CONTROL SCHEMATICS

N.T.S.

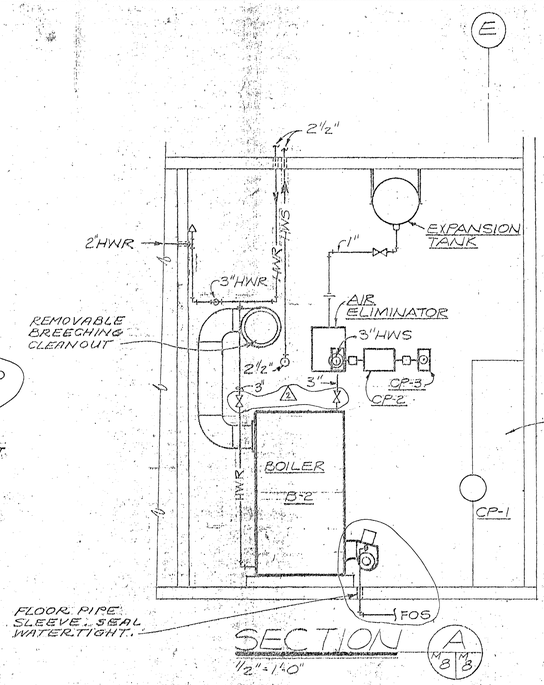

SECTION A

1/2"=1'-0"

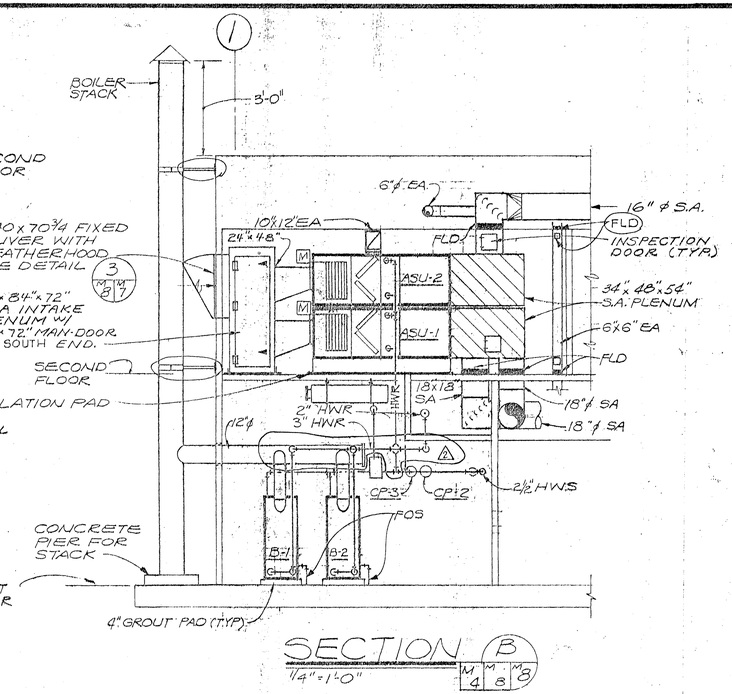

SECTION B

1/4"=1'-0"

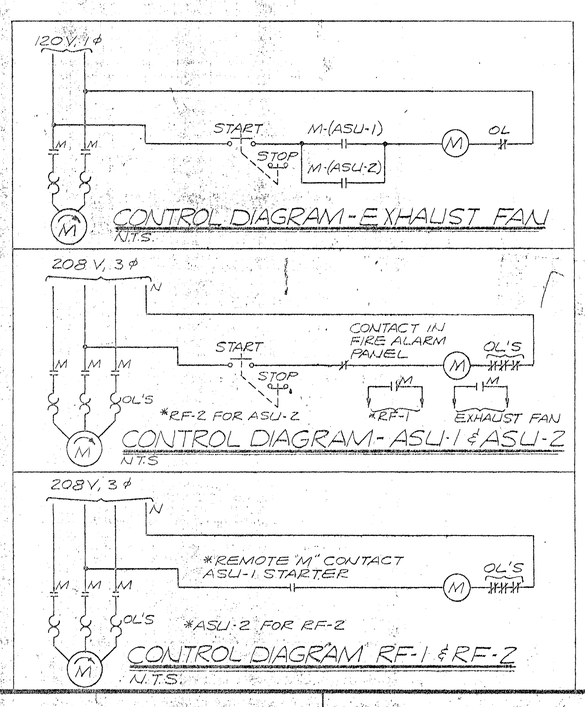

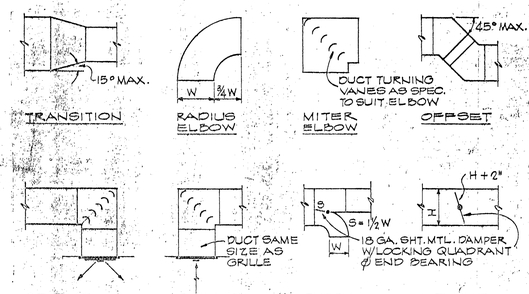

TYPICAL DUCT CONSTRUCTION DETAIL N.T.S

GENERAL DUCTWORK NOTES:

1. CEILING DIFFUSERS & GRILLES ARE TO BE LOCATED IN THE PANELS BETWEEN THE T-BAR GRIDS IN ALL SUSPENDED CEILING SYSTEMS. WHERE REFLECTED CEILING PLANS ARE PROVIDED, LOCATE DIFFUSERS & GRILLES AS INDICATED.
2. PROVIDE SPLITTER DAMPER AT EACH SUPPLY DUCT TAKE-OFF IN ACCORDANCE WITH TYPICAL DUCT CONSTRUCTION DETAILS ABOVE.
3. PROVIDE VOLUME DAMPERS FOR EACH GRILLE AT EACH RETURN CONNECTION AND ANY OTHER LOCATIONS INDICATED ON THE DRAWINGS IN ACCORDANCE WITH TYPICAL DUCT CONSTRUCTION DETAILS ABOVE. DAMPERS TO BE INSTALLED MINIMUM 5'-0" FROM GRILLE EXCEPT AS REQUIRED.

AS BUILT
DATE JAN 27 1977

CH2M HILL

DES. WAK					
DR. GAM					
CH. WAK/NJN					
APP. MCH	NO.	DATE	REVISION	BY	APPD.
	1	12-16-76	AS BUILT	WAK	JJP
	2	2-10-76	MISCELLANEOUS REVISIONS		

SECTIONS AND DETAILS

BASIC BID NO.1
ALTERNATIVE "C"

CITY HALL FOR NOME, ALASKA

SHEET OF 10 M-8
PROJ. NO. K9327.1
DATE 27 JUN 75
DWG. NO.

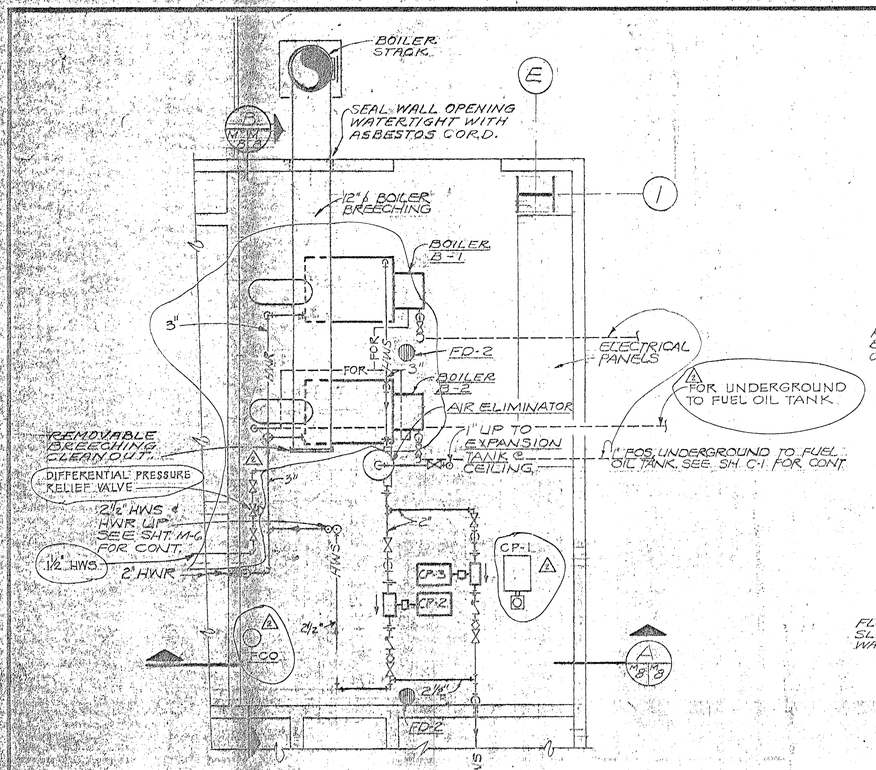

HEAT ROOM PLAN

½"=1'-0"

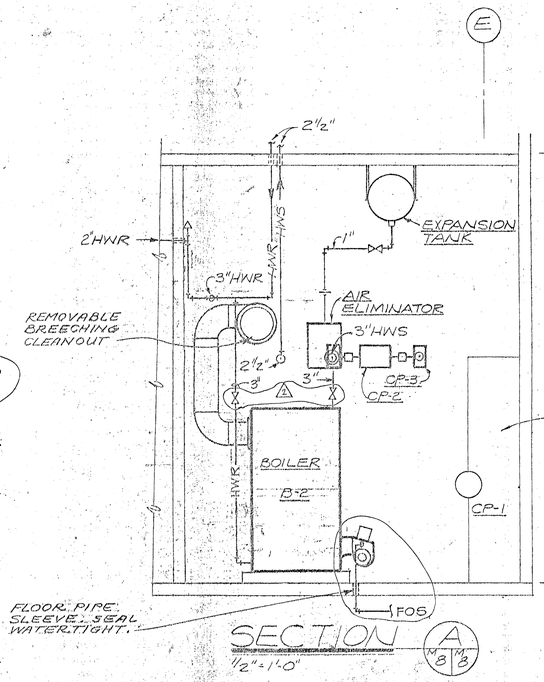

SECTION A

½"=1'-0"

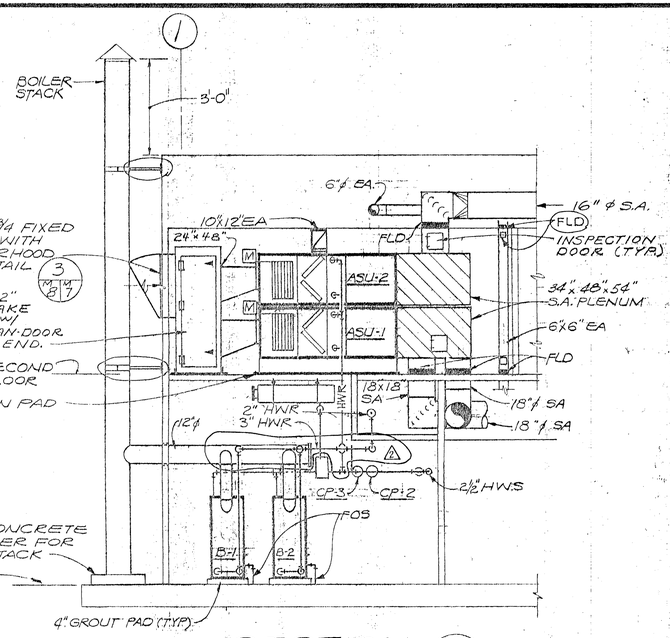

SECTION B

¼"=1'-0"

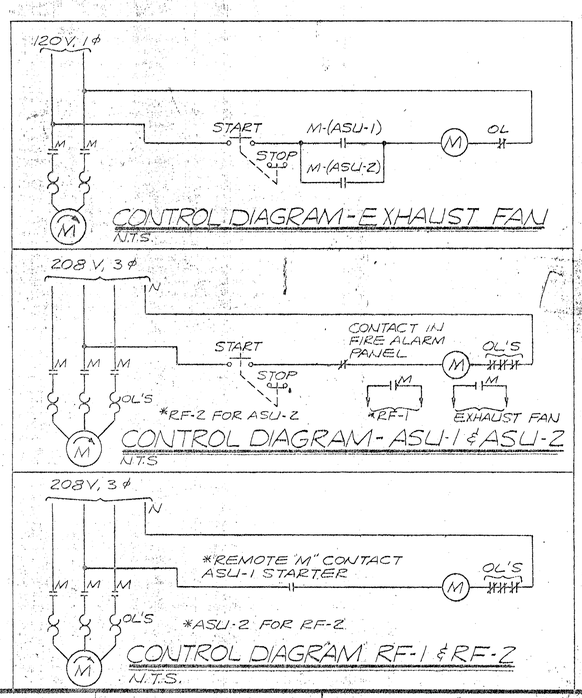

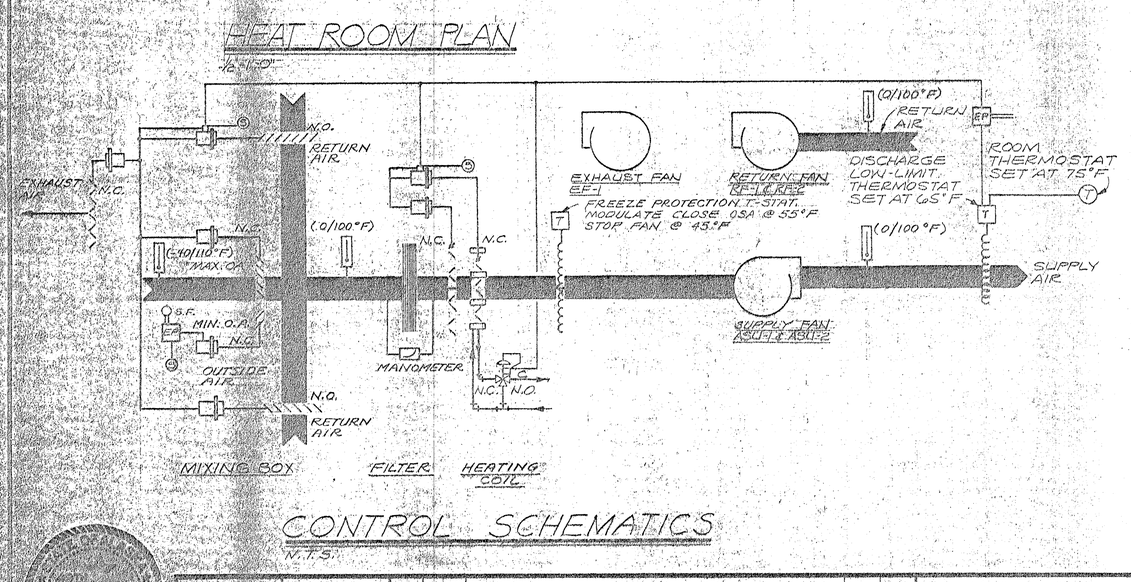

CONTROL SCHEMATICS

N.T.S.

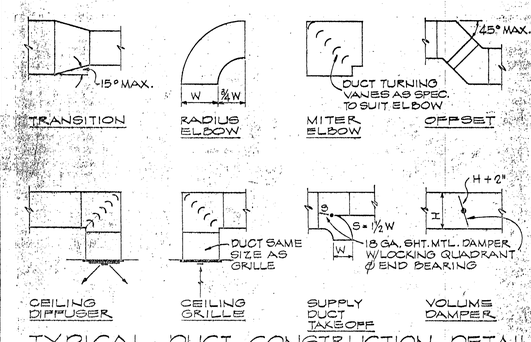

TYPICAL DUCT CONSTRUCTION DETAIL N.T.S.

GENERAL DUCTWORK NOTES:

1. CEILING DIFFUSERS ϕ GRILLES ARE TO BE LOCATED IN THE PANELS BETWEEN THE T-BAR GRIDS IN ALL SUSPENDED CEILING SYSTEMS. WHERE REFLECTED CEILING PLANS ARE PROVIDED, LOCATE DIFFUSERS ϕ GRILLES AS INDICATED.
2. PROVIDE SPLITTER DAMPER AT EACH SUPPLY DUCT TAKE-OFF IN ACCORDANCE WITH TYPICAL DUCT CONSTRUCTION DETAILS ABOVE.
3. PROVIDE VOLUME DAMPERS FOR EACH GRILLE AT EACH RETURN CONNECTION AND ANY OTHER LOCATIONS INDICATED ON THE DRAWINGS IN ACCORDANCE WITH TYPICAL DUCT CONSTRUCTION DETAILS ABOVE. DAMPERS TO BE INSTALLED MINIMUM 5'-0" FROM GRILLE EXCEPT AS REQUIRED.

AS BUILT
DATE JAN 27 1977

DES. WAK						
DR. GAM					BAB	
CHK. WAK/NLN	1	12-16-76	AS BUILT		BAB	
APPD. ALH	0	2-6-76	MISCELLANEOUS REVISIONS		WAK	JJP
	NO.	DATE	REVISION		BY	APPD.

CH2M HILL

SECTIONS AND DETAILS

BASIC BID NO. 1
ALTERNATIVE "C"

CITY HALL FOR NOME, ALASKA

SHEET OF 10 M-8
PROJ. NO. K9327.1
DATE 27 JUN 75
DWG. NO.

STRUCTURAL NOTES

1. FOOTINGS MAY BE STEPPED TO FOLLOW FINAL FINISH GRADES SHOWN ON SHEET C-1. MIN. DEPTH TO TOP OF INSULATION SHALL BE 2'-0"
2. PERIMETER FOUNDATION WALLS SHALL BE POURED MONOLITHIC WITH THE COLUMN PIERS.
3. AT THE COLUMN POCKETS, THE TOP 8½" OF SUBGRADE INSULATION SHALL NOT BE PLACED UNTIL THE COLUMNS HAVE BEEN SET AND GROUTED.

LEGEND AND ABBREVIATIONS

STRUCTURAL SHEETS

B.M.	BENCH MARK
BLDG. MFR.	BUILDING MANUFACTURER
℄	CENTER LINE
COL.	COLUMN
COL'S	COLUMNS
CONC.	CONCRETE
CONT.	CONTINUOUS
COP.	COPPER
CORP.	CORPORATION
CPLG.	COUPLING
E.W.	EACH WAY
EL.	ELEVATION
EXST.	EXISTING
FIN.	FINISH
F.G.	FINISHED GRADE
HORZ.	HORIZONTAL
INV.	INVERT
MAX.	MAXIMUM
MIN.	MINIMUM
N.I.C.	NOT IN CONTRACT
N.T.S.	NOT TO SCALE
O.C.	ON CENTER
PL	PLATE
SPEC'S	SPECIFICATIONS
SQ.	SQUARE
S.S.	STAINLESS STEEL
STD.	STANDARD
TYP.	TYPICAL
VERT.	VERTICAL
WWM	WELDED WIRE MESH
W/	WITH
⊕	FINISHED GRADE TYP
F.O.I.C.	FURNISHED BY OWNER & INSTALLED BY CONTRACTOR

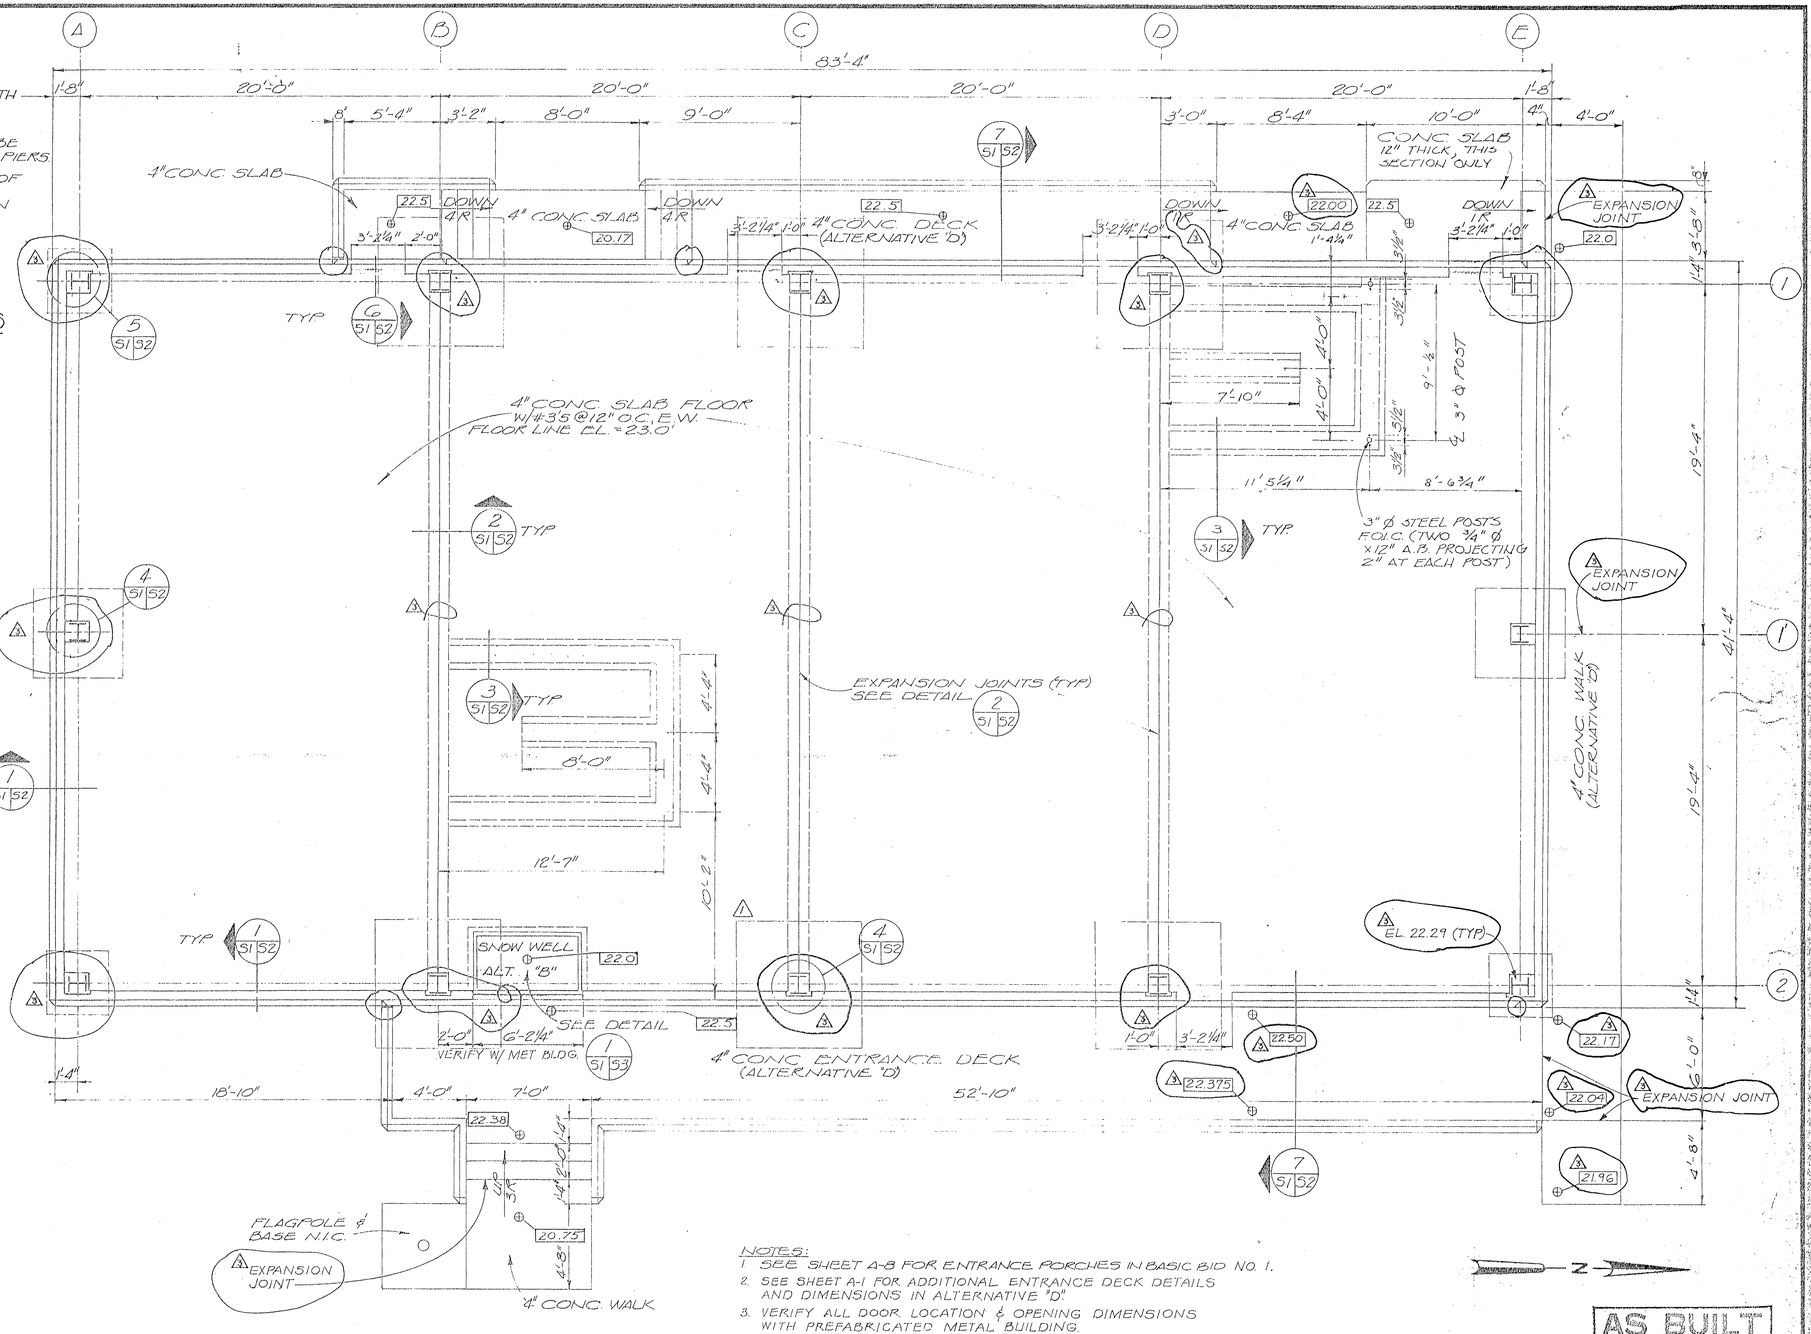

NOTES:
1. SEE SHEET A-8 FOR ENTRANCE PORCHES IN BASIC BID NO. 1.
2. SEE SHEET A-1 FOR ADDITIONAL ENTRANCE DECK DETAILS AND DIMENSIONS IN ALTERNATIVE "D"
3. VERIFY ALL DOOR LOCATION & OPENING DIMENSIONS WITH PREFABRICATED METAL BUILDING.
4. SEE SHEETS M-1 AND A-9 FOR FLOOR DRAIN LOCATIONS. SET DRAINS 1" BELOW FLOOR LINE AND PROVIDE 2'-0" DIAMETER DISH IN SLAB AROUND DRAIN.

STATE OF ALASKA 49TH — Edward A. Holt — 8756 E — Registered Professional Engineer

AS BUILT DATE JAN 27 1977

CH2M HILL ANCHORAGE

DES. E.A.H. DR. D.E.V.K. CHK. E.A.H. APPD. E.A.H.

NO.	DATE	REVISION	BY	APPD.
3	12-10-76	AS BUILT	GEB	JJP
2	2-6-76	MISC. REVISIONS	J.J.P.	E.A.H.
1	7-18-75	SHOW FOOTING AT COLUMN C-2	EAH	EAH

FOUNDATION PLAN ¼"=1'-0"

BASIC BID NO. 1 & ALTERNATIVES "B" & "D"

CITY HALL FOR NOME, ALASKA

SHEET OF 3 51
PROJ. NO. K9327.1.
DATE 7 JULY 75
DWG. NO. C9327-1

STRUCTURAL NOTES

1. FOOTINGS MAY BE STEPPED TO FOLLOW FINAL FINISH GRADES SHOWN ON SHEET C-1. MIN. DEPTH TO TOP OF INSULATION SHALL BE 2'-0"
2. PERIMETER FOUNDATION WALLS SHALL BE POURED MONOLITHIC WITH THE COLUMN PIERS.
3. AT THE COLUMN POCKETS, THE TOP 8½" OF SUBGRADE INSULATION SHALL NOT BE PLACED UNTIL THE COLUMNS HAVE BEEN SET AND GROUTED.

LEGEND AND ABBREVIATIONS

STRUCTURAL SHEETS

B.M.	BENCH MARK
BLDG. MFR.	BUILDING MANUFACTURER
℄	CENTER LINE
COL.	COLUMN
COL'S	COLUMNS
CONC.	CONCRETE
CONT.	CONTINUOUS
COP.	COPPER
CORP.	CORPORATION
CPLG.	COUPLING
E.W.	EACH WAY
EL.	ELEVATION
EXST.	EXISTING
FIN.	FINISH
F.G.	FINISHED GRADE
HORZ.	HORIZONTAL
INV.	INVERT
MAX.	MAXIMUM
MIN.	MINIMUM
N.I.C.	NOT IN CONTRACT
N.T.S.	NOT TO SCALE
O.C.	ON CENTER
PL.	PLATE
SPEC'S	SPECIFICATIONS
SQ.	SQUARE
S.S.	STAINLESS STEEL
STD.	STANDARD
TYP.	TYPICAL
VERT.	VERTICAL
WWM	WELDED WIRE MESH
W/	WITH
⊕	FINISHED GRADE TYP
F.O.I.C.	FURNISHED BY OWNER & INSTALLED BY CONTRACTOR

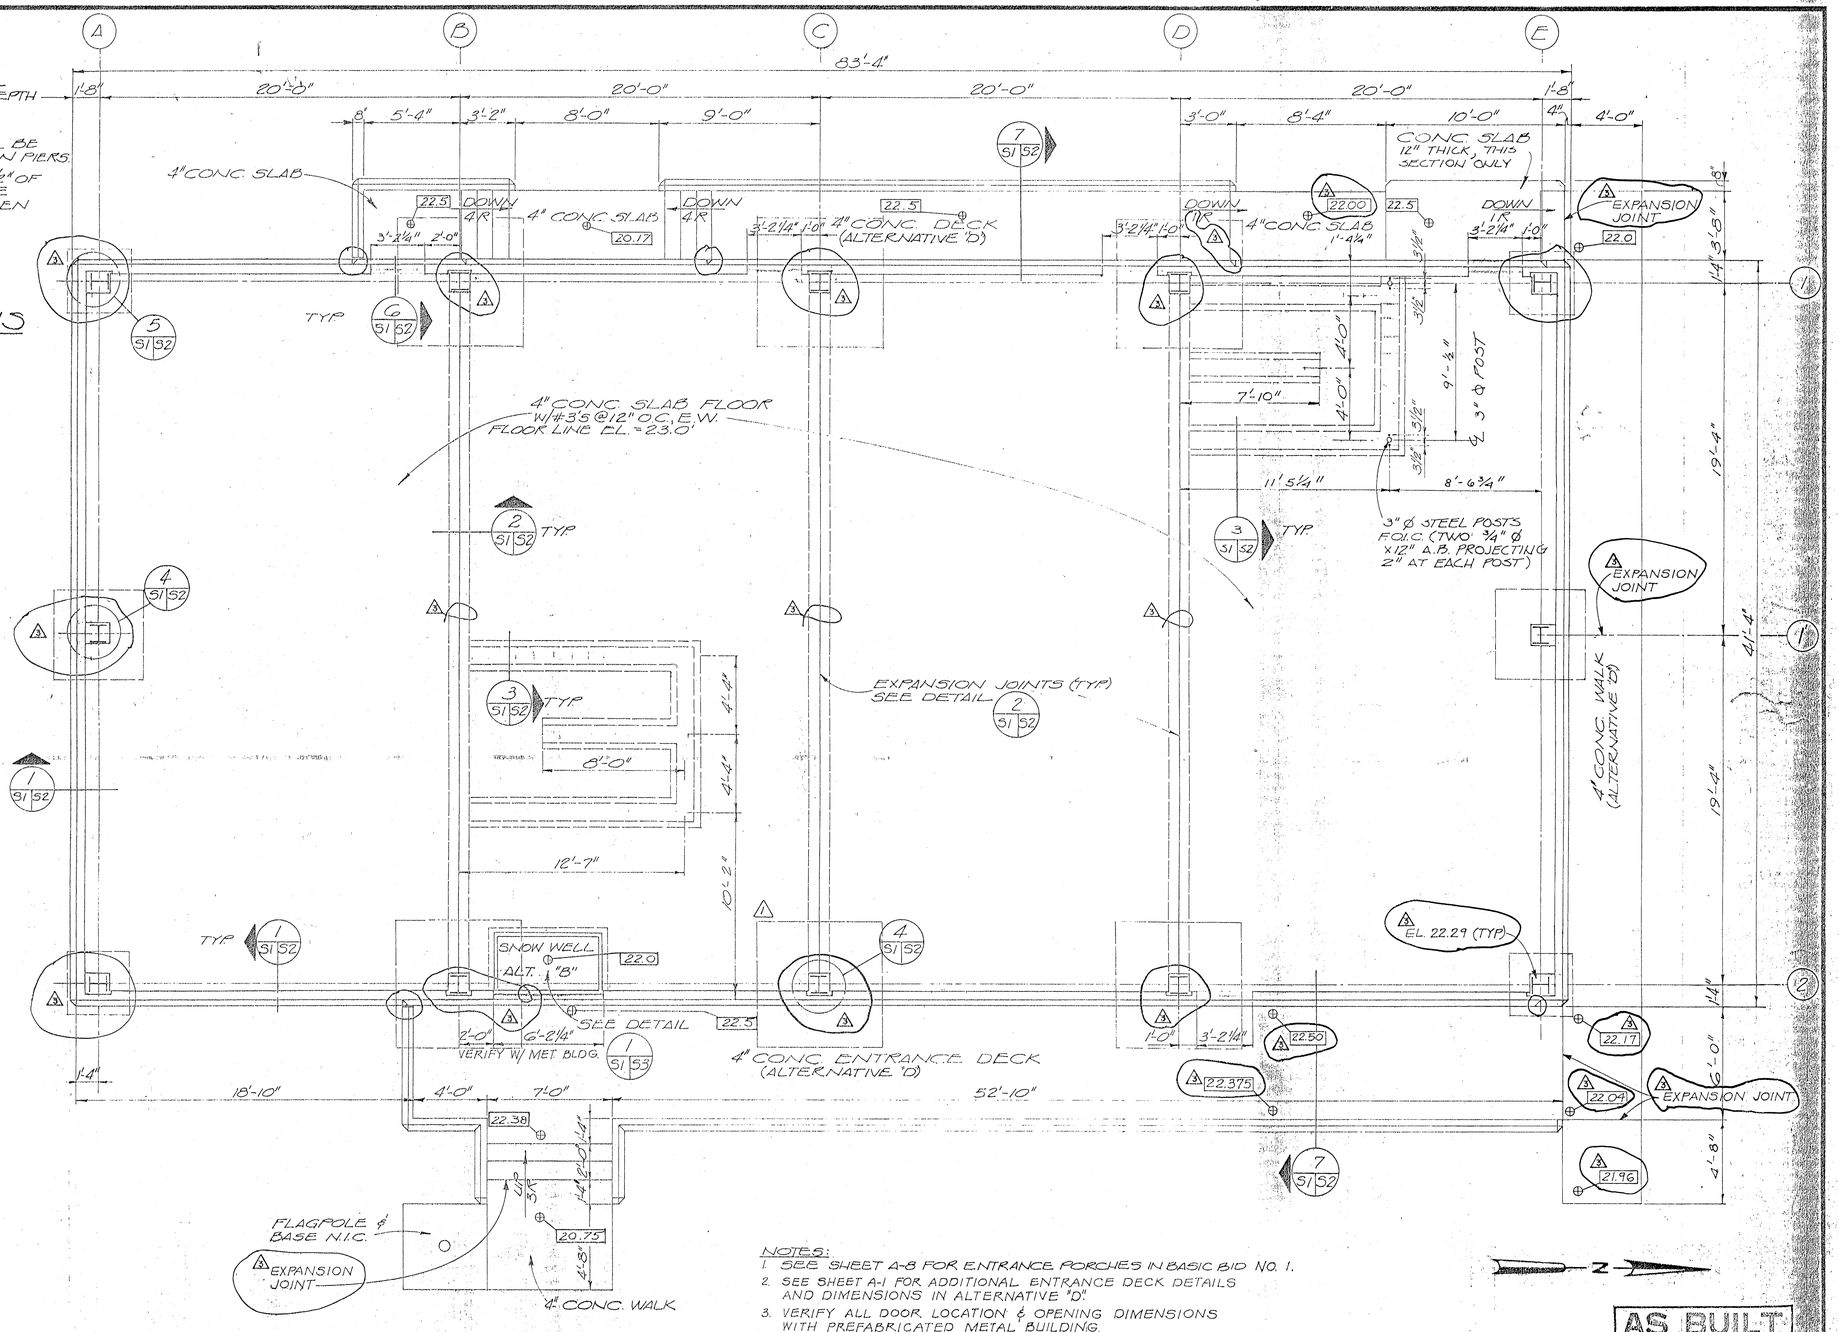

NOTES:
1. SEE SHEET A-8 FOR ENTRANCE PORCHES IN BASIC BID NO. 1.
2. SEE SHEET A-1 FOR ADDITIONAL ENTRANCE DECK DETAILS AND DIMENSIONS IN ALTERNATIVE "D"
3. VERIFY ALL DOOR LOCATION & OPENING DIMENSIONS WITH PREFABRICATED METAL BUILDING.
4. SEE SHEETS M-1 AND A-9 FOR FLOOR DRAIN LOCATIONS. SET DRAINS 1" BELOW FLOOR LINE AND PROVIDE 2'-0" DIAMETER DISH IN SLAB AROUND DRAIN.

AS BUILT
DATE JAN 27 1977

STATE OF ALASKA 49TH
Edward A. Hart
REGISTERED PROFESSIONAL ENGINEER
9781E

CH2M HILL ALASKA

DES. E.A.H.
DR. D.E.V.K.
CHK. E.A.H.
APPD. E.A.H.

NO.	DATE	REVISION	BY	APPD.
3	12-10-76	AS BUILT	GEB	JJP
2	2-6-76	MISC. REVISIONS	JJP	EAH
1	7-18-75	SHOW FOOTING AT COLUMN C-2	EAH	EAH

FOUNDATION PLAN ¼"=1'-0"

BASIC BID NO. 1 & ALTERNATIVES "B" & "D"

CITY HALL FOR NOME, ALASKA

SHEET OF 3 S1
PROJ. NO. K9327.1
DATE JULY 75
DWG. NO. C9327-1

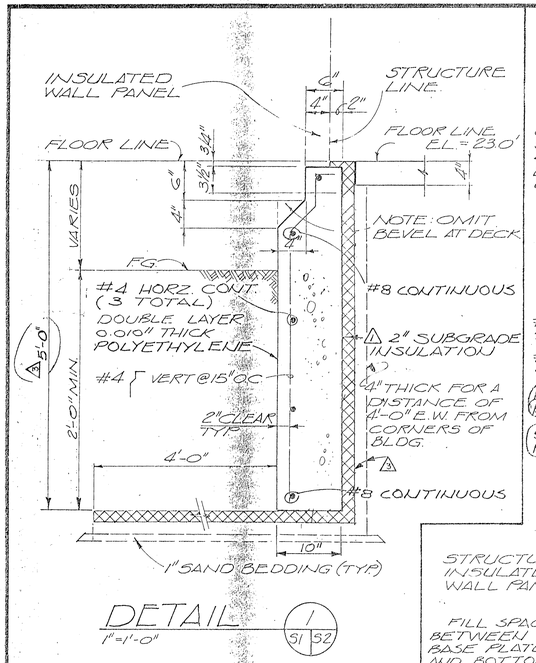

DETAIL 1 (S1 | S2)
1"=1'-0"

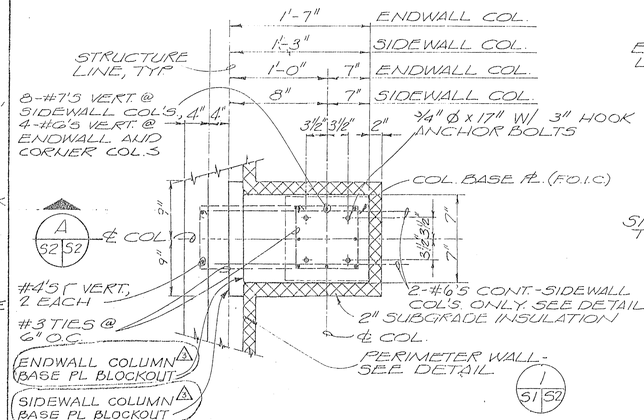

PLAN 4 (S1 | S2)
1"=1'-0"

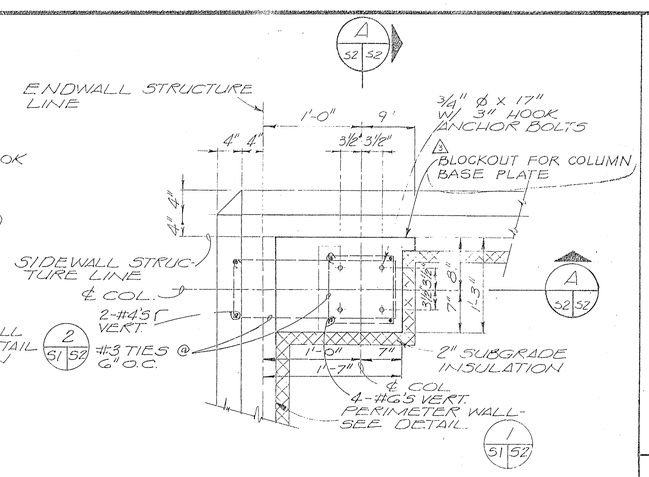

PLAN 5 (S1 | S2)
1"=1'-0"

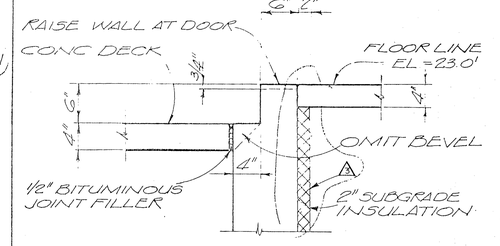

DETAIL 6 (S1 | S2)
1"=1'-0"

NOTE: THIS DETAIL TYP. AT ALL EXTERIOR DOORS

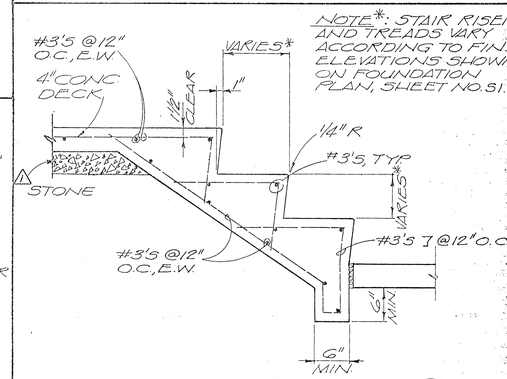

NOTE*: STAIR RISERS AND TREADS VARY ACCORDING TO FIN. ELEVATIONS SHOWN ON FOUNDATION PLAN, SHEET NO. S1.

STD. STAIR DETAIL 8 (S1 | S2)
1"=1'-0"

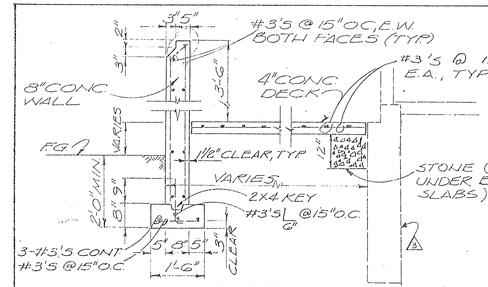

DETAIL 7 (S1 | S2)
N.T.S.
ALTERNATIVE "D"

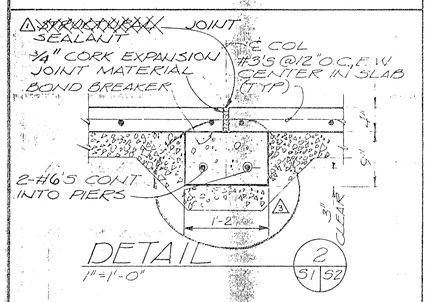

DETAIL 2 (S1 | S2)
1"=1'-0"

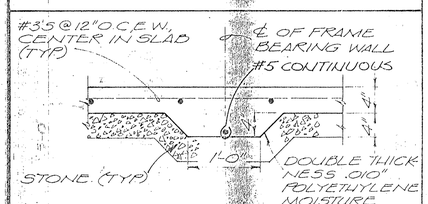

DETAIL 3 (S1 | S2)
1"=1'-0"

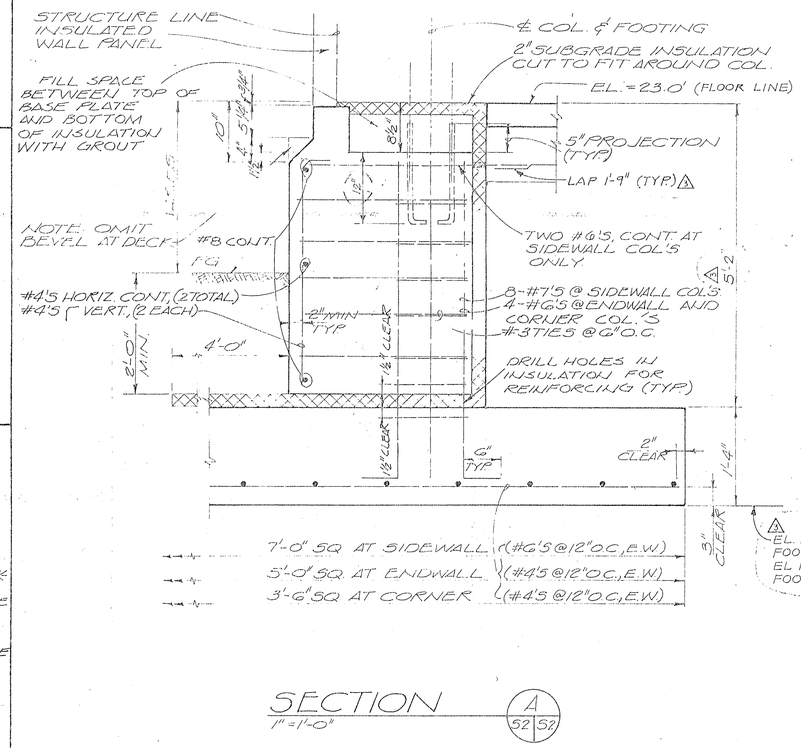

SECTION A (S2 | S2)
1"=1'-0"

NOTE: PERIMETER FOUNDATION WALLS SHALL BE PLACED MONOLITHIC WITH THE COLUMN PIERS.

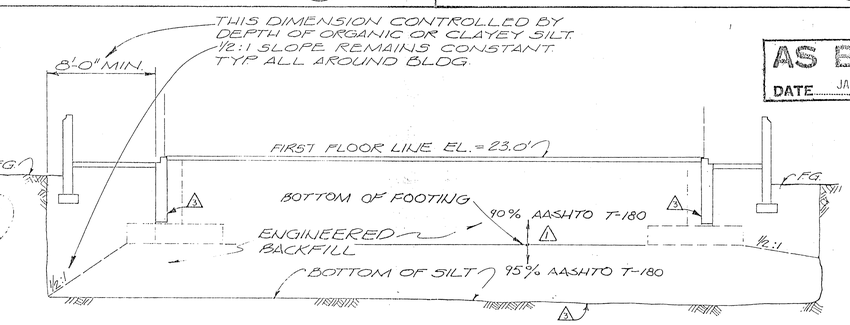

AS BUILT
DATE JAN 27 1977

STD. FOUNDATION EXCAVATION DIAGRAM
N.T.S.

NOTES:
1. CONTRACTOR SHALL STRIP ALL ORGANIC SILT AND CLAYEY SILT BELOW STRUCTURE AS SHOWN ON THE SOIL BORING LOGS AND BACKFILL WITH ENGINEERED FILL, PER SPECS.
2. FOUNDATION MAY BE PLACED BEFORE FILL IS BROUGHT TO FINAL GRADE.

Edward A. Hill

CH2M HILL ALASKA
DES. E.A.H.
DR. D.E.V.K.
CHK. E.A.H.
APPD. E.A.H.

NO.	DATE	REVISION	BY	APPD.
3	12-14-76	AS BUILT	GEB	MSK
2	2-6-76	REVISED FOOTING DEPTH; MISC.	DVK	EAH
1	7.18.75	12" CRUSHED STONE UNDER STAIR; COMPACTION UNDER BLDG.; MISC.	EAH	EAH

FOUNDATION SECTIONS AND DETAILS

BASIC BID NO. 1 & ALTERNATIVE "D"

CITY HALL FOR NOME, ALASKA

SHEET OF 5 52
PROJ. NO. K9327.7
DATE 7 JULY 75
DWG. NO. C 9327-1

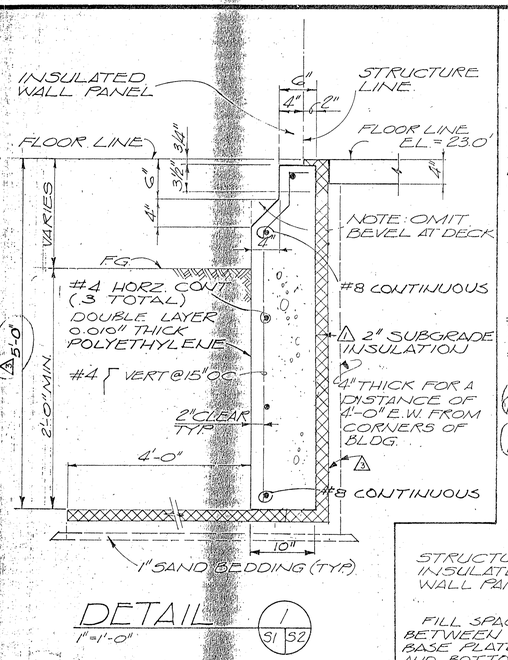

DETAIL 1 (S1|S2)
1"=1'-0"

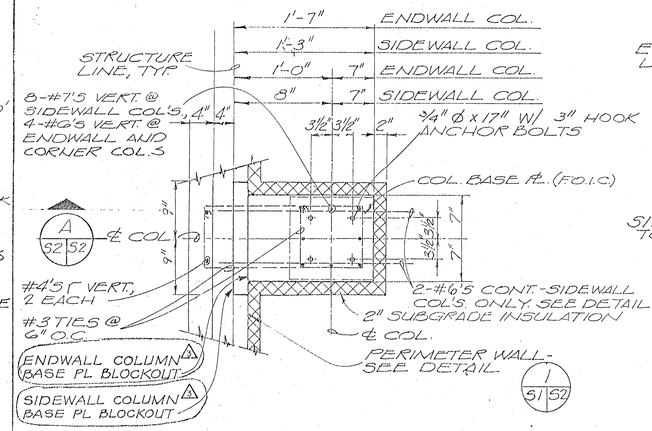

PLAN 4 (S1|S2)
1"=1'-0"

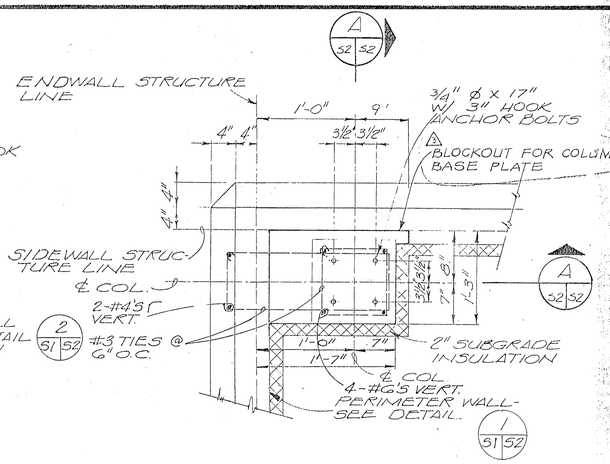

PLAN 5 (S1|S2)
1"=1'-0"

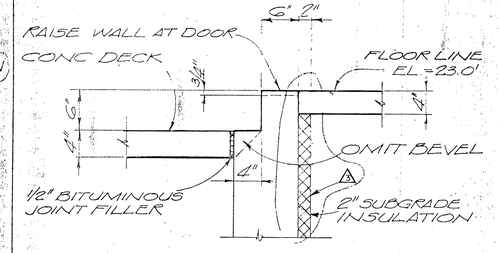

DETAIL 6 (S1|S2)
1"=1'-0"

NOTE: THIS DETAIL TYP AT ALL EXTERIOR DOORS.

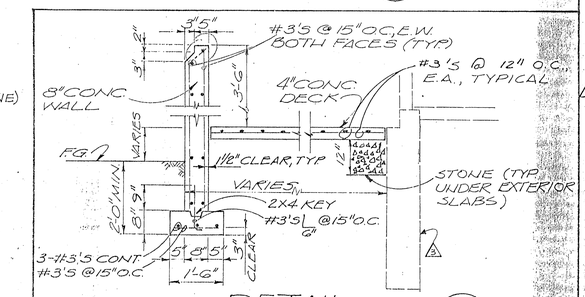

DETAIL 7 (S1|S2)
N.T.S.
ALTERNATIVE "D"

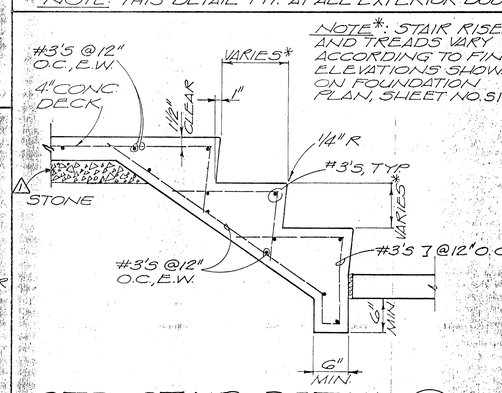

STD. STAIR DETAIL 8 (S1|S2)
1"=1'-0"

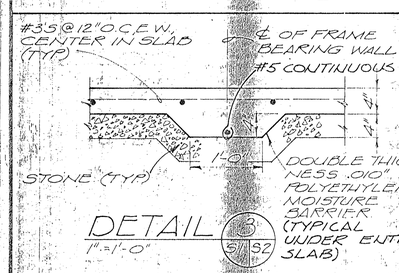

1"=1'-0"

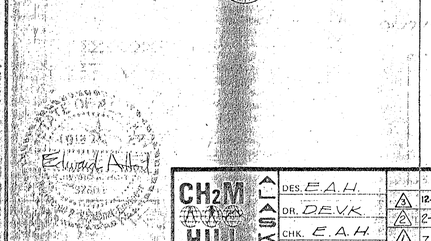

DETAIL 3 (S1|S2)
1"=1'-0"

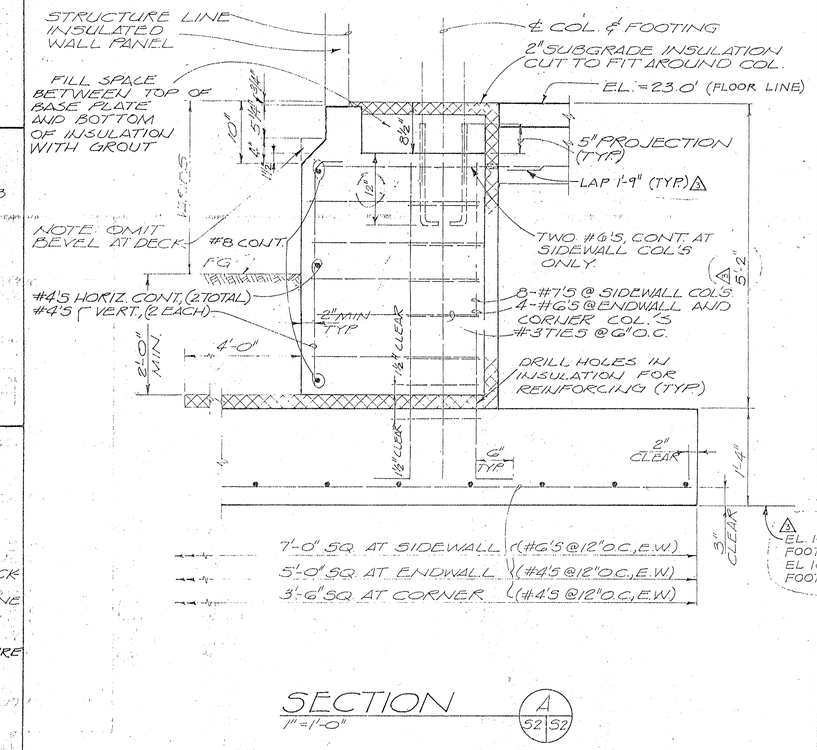

SECTION A (S2|S2)
1"=1'-0"

NOTE: PERIMETER FOUNDATION WALLS SHALL BE PLACED MONOLITHIC WITH THE COLUMN PIERS.

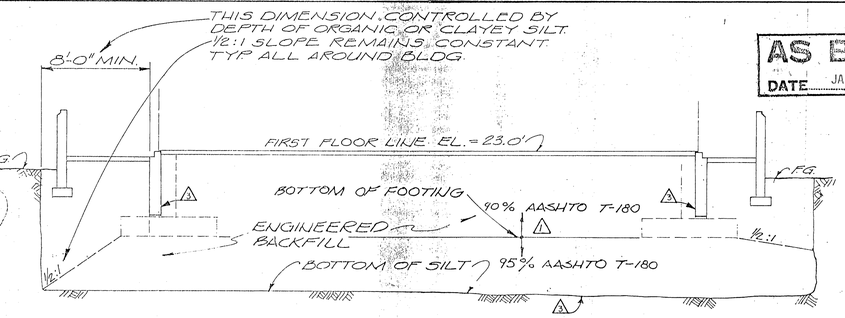

STD. FOUNDATION EXCAVATION DIAGRAM
N.T.S.

NOTES:
1. CONTRACTOR SHALL STRIP ALL ORGANIC SILT AND CLAYEY SILT BELOW STRUCTURE AS SHOWN ON THE SOIL BORING LOGS AND BACKFILL WITH ENGINEERED FILL, PER SPECS.
2. FOUNDATION MAY BE PLACED BEFORE FILL IS BROUGHT TO FINAL GRADE.

AS BUILT
DATE JAN 27 1977

CH2M HILL ALASKA

DES.	E.A.H.
DR.	D.E.V.K.
CHK.	E.A.H.
APPD.	E.A.H.

NO.	DATE	REVISION	BY	APPD.
3	12-14-76	AS BUILT	GEB	MSK
2	2-6-76	REVISED FOOTING DEPTH; MISC.	DVK	EAH
1	7 18 75	12" CRUSHED STONE UNDER STAIR; COMPACTION UNDER BLDG.; MISC.	EAH	EAH

FOUNDATION SECTIONS AND DETAILS

BASIC BID NO. 1 & ALTERNATIVE "D"

CITY HALL FOR NOME, ALASKA

SHEET OF 3 S2
PROJ. NO. K9327.1
DATE 7 JULY 75
DWG. NO. C9327-31

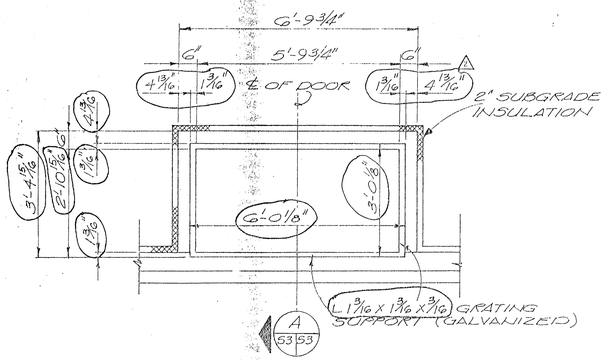

PLAN
1/2"=1'-0"

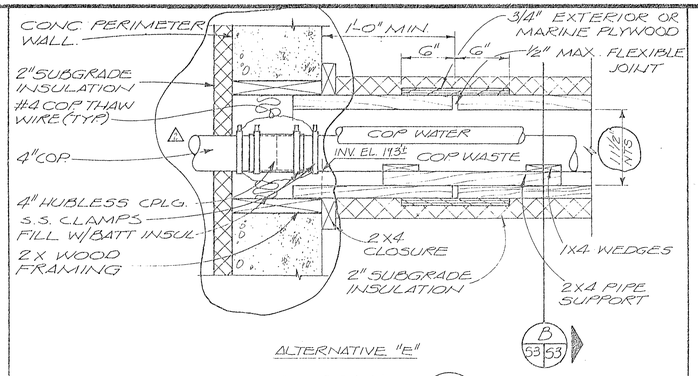

ALTERNATIVE "E"

DETAIL 3
1 1/2"=1'-0" C1 53

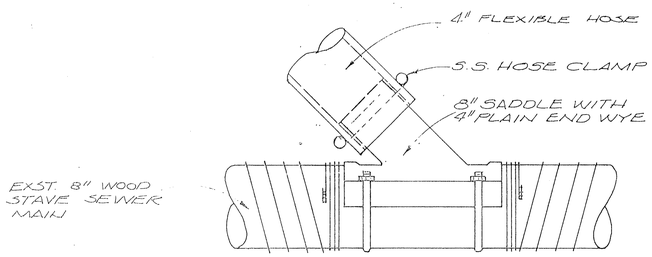

DETAIL 5
N.T.S. 53 53
ALTERNATIVE "E"

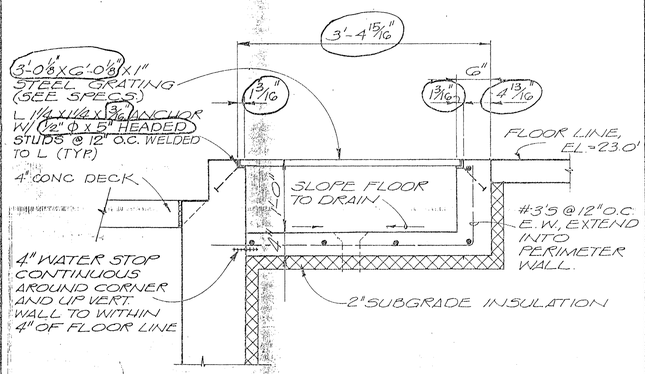

SECTION A
1"=1'-0" S3 53

SNOW WELL DETAIL 1
S1 53
ALTERNATIVE "B"

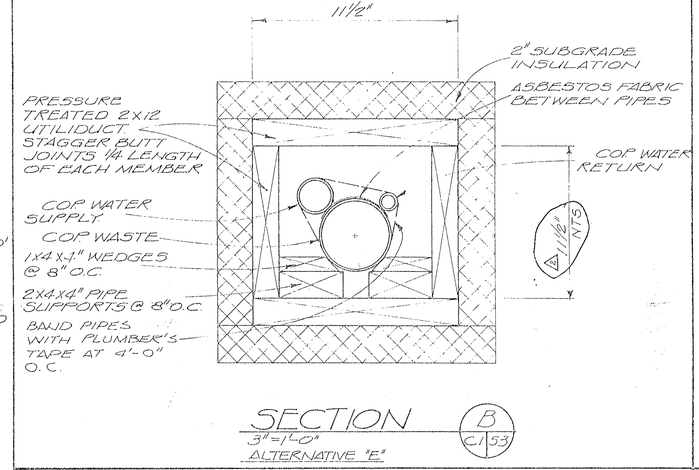

SECTION B
3"=1'-0" C1 53
ALTERNATIVE "E"

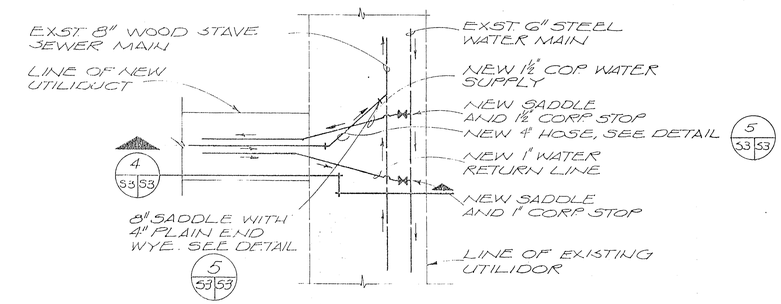

PLAN DETAIL 6
N.T.S. C1 53
ALTERNATIVE "E"

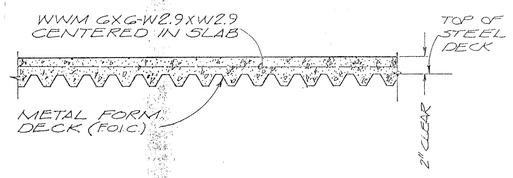

STD 2ND FLOOR SLAB REINFORCING DETAIL 2
N.T.S. A4 53

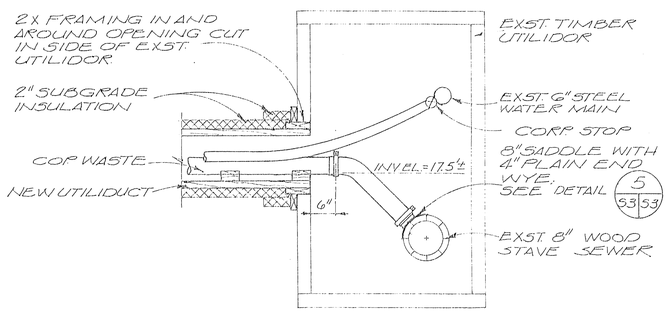

DETAIL 4
3/4"=1'-0" S3 53
ALTERNATIVE "E"

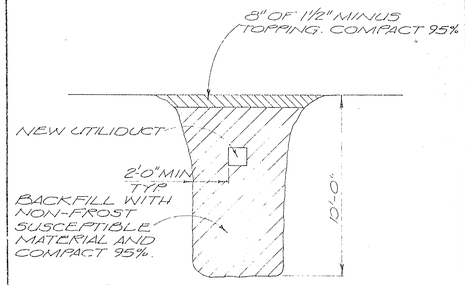

STD TRENCH DETAIL
N.T.S.
ALTERNATIVE "E"

AS BUILT
DATE JAN 27 1977

STATE OF ALASKA
49TH
Edward A. Hill
REGISTERED PROFESSIONAL ENGINEER

CH2M HILL ANCHORAGE

DES. E.A.H./J.R.D.					
DR. D.E.V.K.					
CHK. E.A.H./J.R.D.	2	12-14-76	AS BUILT	GEB	MSK
APPD. E.A.H.	1	2-6-76	MISC. REVISIONS	DVK	EAH
	NO.	DATE	REVISION	BY	APPD.

FOUNDATION DETAILS

BASIC BID NO. 1 & ALTERNATIVES "B" & "E"

CITY HALL FOR NOME, ALASKA

SHEET OF 3 S3
PROJ. NO. K9327.1
DATE 7 JULY 75
DWG. NO. C9327-1

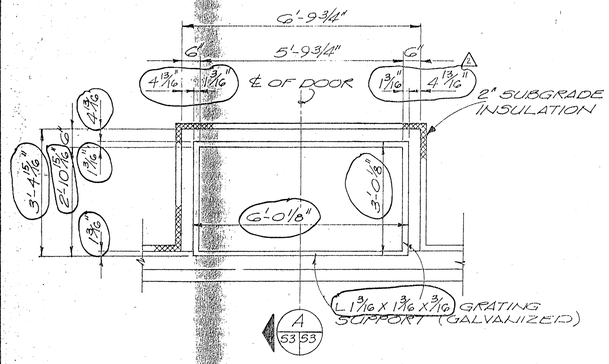

PLAN
1/2" = 1'-0"

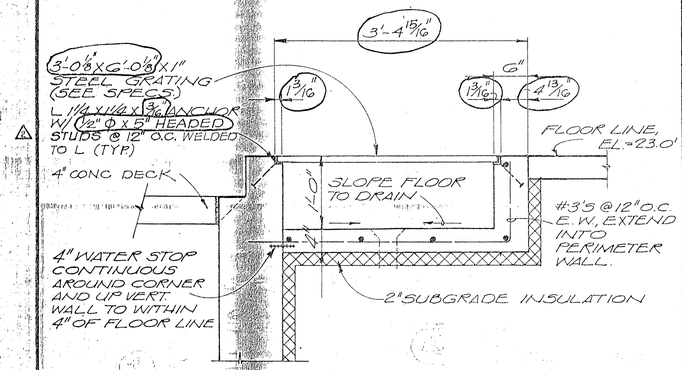

SECTION A (53 | 53)
1" = 1'-0"

SNOW WELL DETAIL (1 | S1 | 53)

ALTERNATIVE "B"

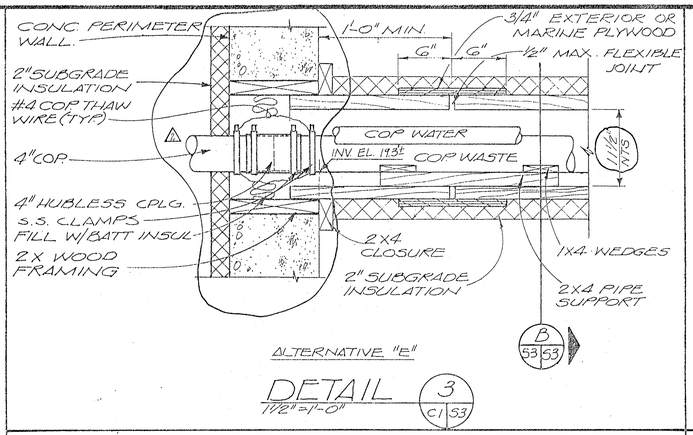

ALTERNATIVE "E"

DETAIL (3 | C1 | 53)

1 1/2" = 1'-0"

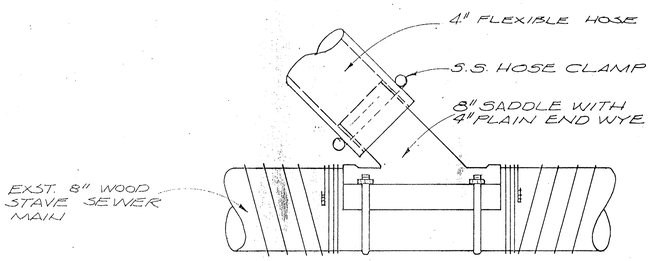

DETAIL (5 | 53 | 53)

N.T.S.

ALTERNATIVE "E"

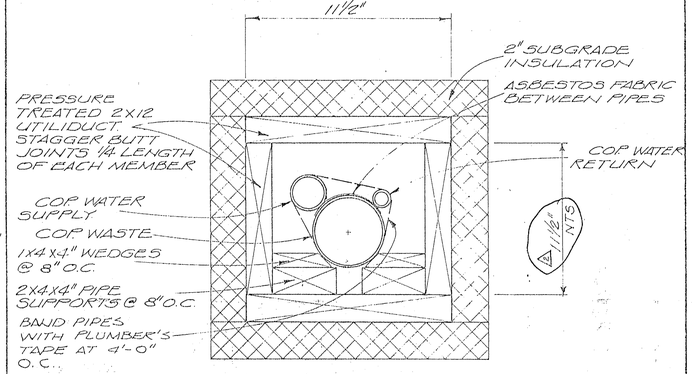

SECTION (B | C1 | 53)

3" = 1'-0"

ALTERNATIVE "E"

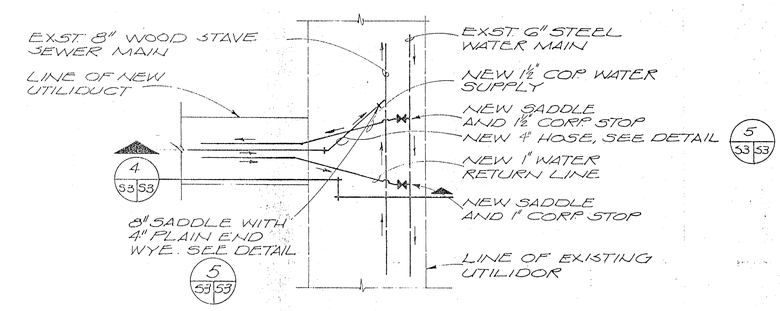

PLAN DETAIL (6 | C1 | 53)

N.T.S.

ALTERNATIVE "E"

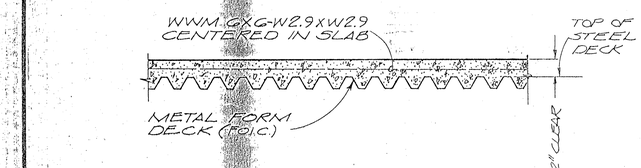

STD 2ND FLOOR SLAB REINFORCING DETAIL (2 | A4 | 53)

N.T.S.

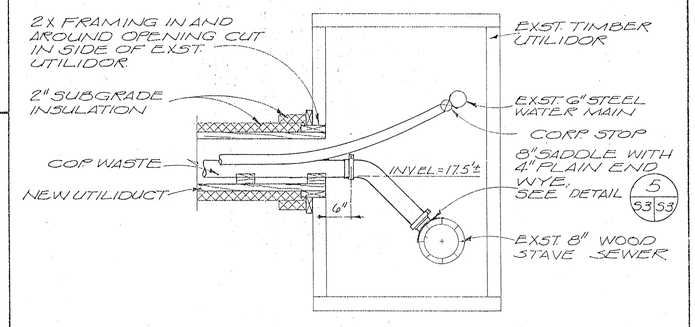

DETAIL (4 | S3 | 53)

3/4" = 1'-0"

ALTERNATIVE "E"

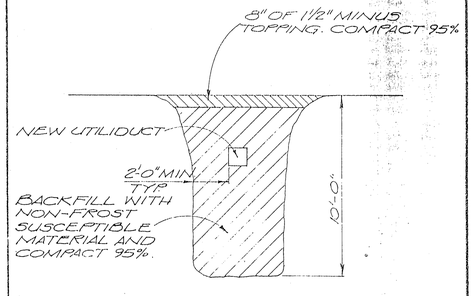

STD. TRENCH DETAIL

N.T.S.

ALTERNATIVE "E"

AS BUILT
DATE JAN 2-7 1977

STATE OF ALASKA
49TH
Edward A. Hall
REGISTERED PROFESSIONAL ENGINEER

CH2M HILL

DES.	E.A.H./J.R.D.
DR.	D.E.V.K.
CHK	E.A.H./J.R.D.
APPD.	E.A.H.

NO.	DATE	REVISION	BY	APPD.
2	12-14-76	AS BUILT	GEB	MSK
1	2-6-76	MISC. REVISIONS	DVK	EAH

FOUNDATION DETAILS

BASIC BID NO. 1 & ALTERNATIVES "B" & "E"

CITY HALL FOR NOME, ALASKA

SHEET OF 3 S3
PROJ. NO. K9327.1
DATE 7 JULY 75
DWG. NO. C9327-1